



**BRIDGE #16 PLAN**  
SCALE 1 : 100

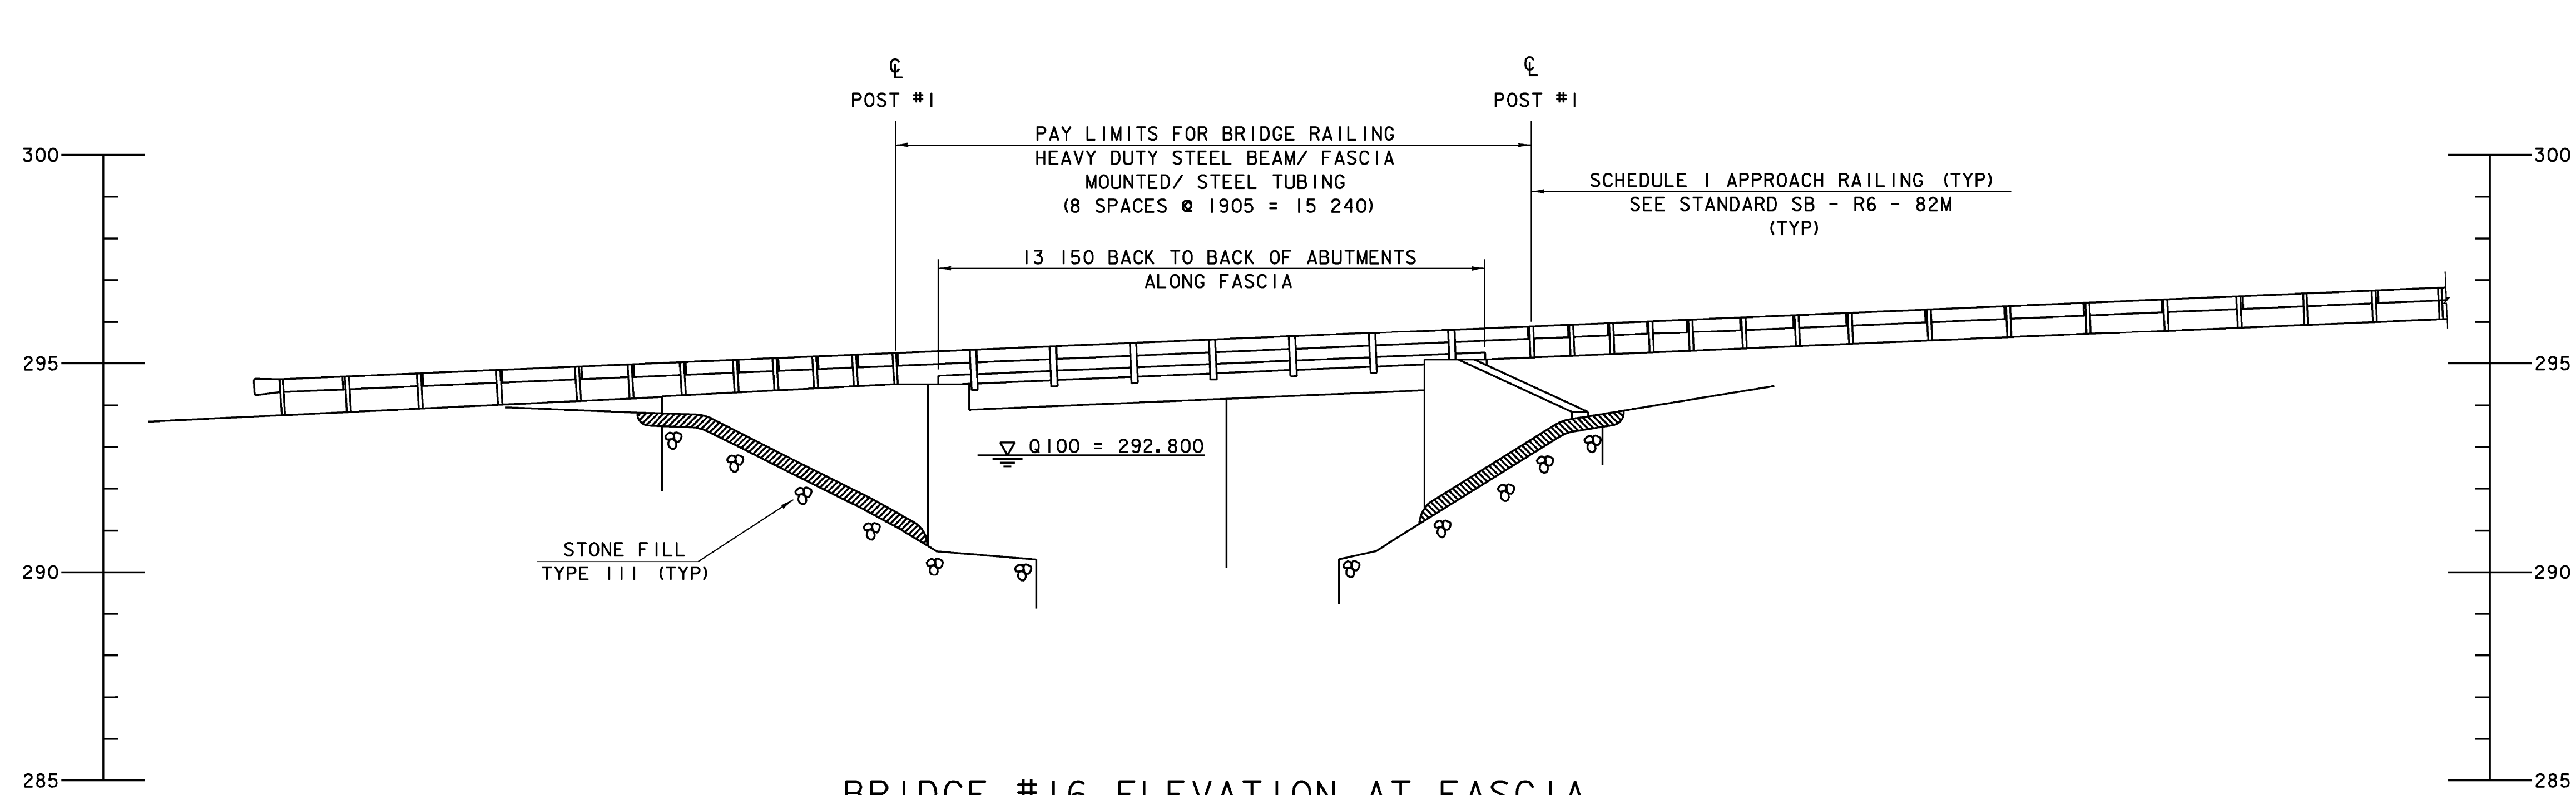

**BRIDGE #16 ELEVATION AT FASCIA**  
SCALE 1 : 100

**DATUM**

VERTICAL	NAVD88
HORIZONTAL	NAD83 (92)

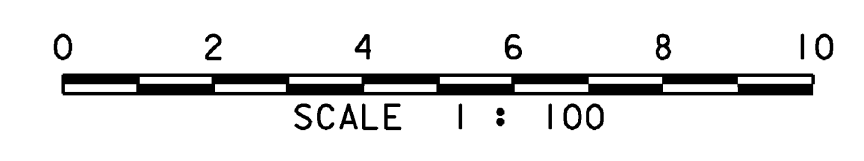

THIS SHEET NOT USED FOR RECORD PLANS. SEE VE DESIGN.

PROJECT: <b>BURKE</b>	PROJECT NO. : <b>BRZ 1447 (15)</b>
DESIGN FILE NAME: 87e043\Structures\se043br16pe.dgn	PLOT DATE: 10-MAR-2008
IPARM FILE NAME: se043br16pe.i	SURVEYED BY: A. MYERS
SURVEYED BY: A. MYERS	DATE: 12/95
SQUAD LEADER: C. P. WILLIAMS	DRAWN BY: T. ANDERSON
BRIDGE #16 PLAN & ELEVATION	SHEET: 28 OF 81

