

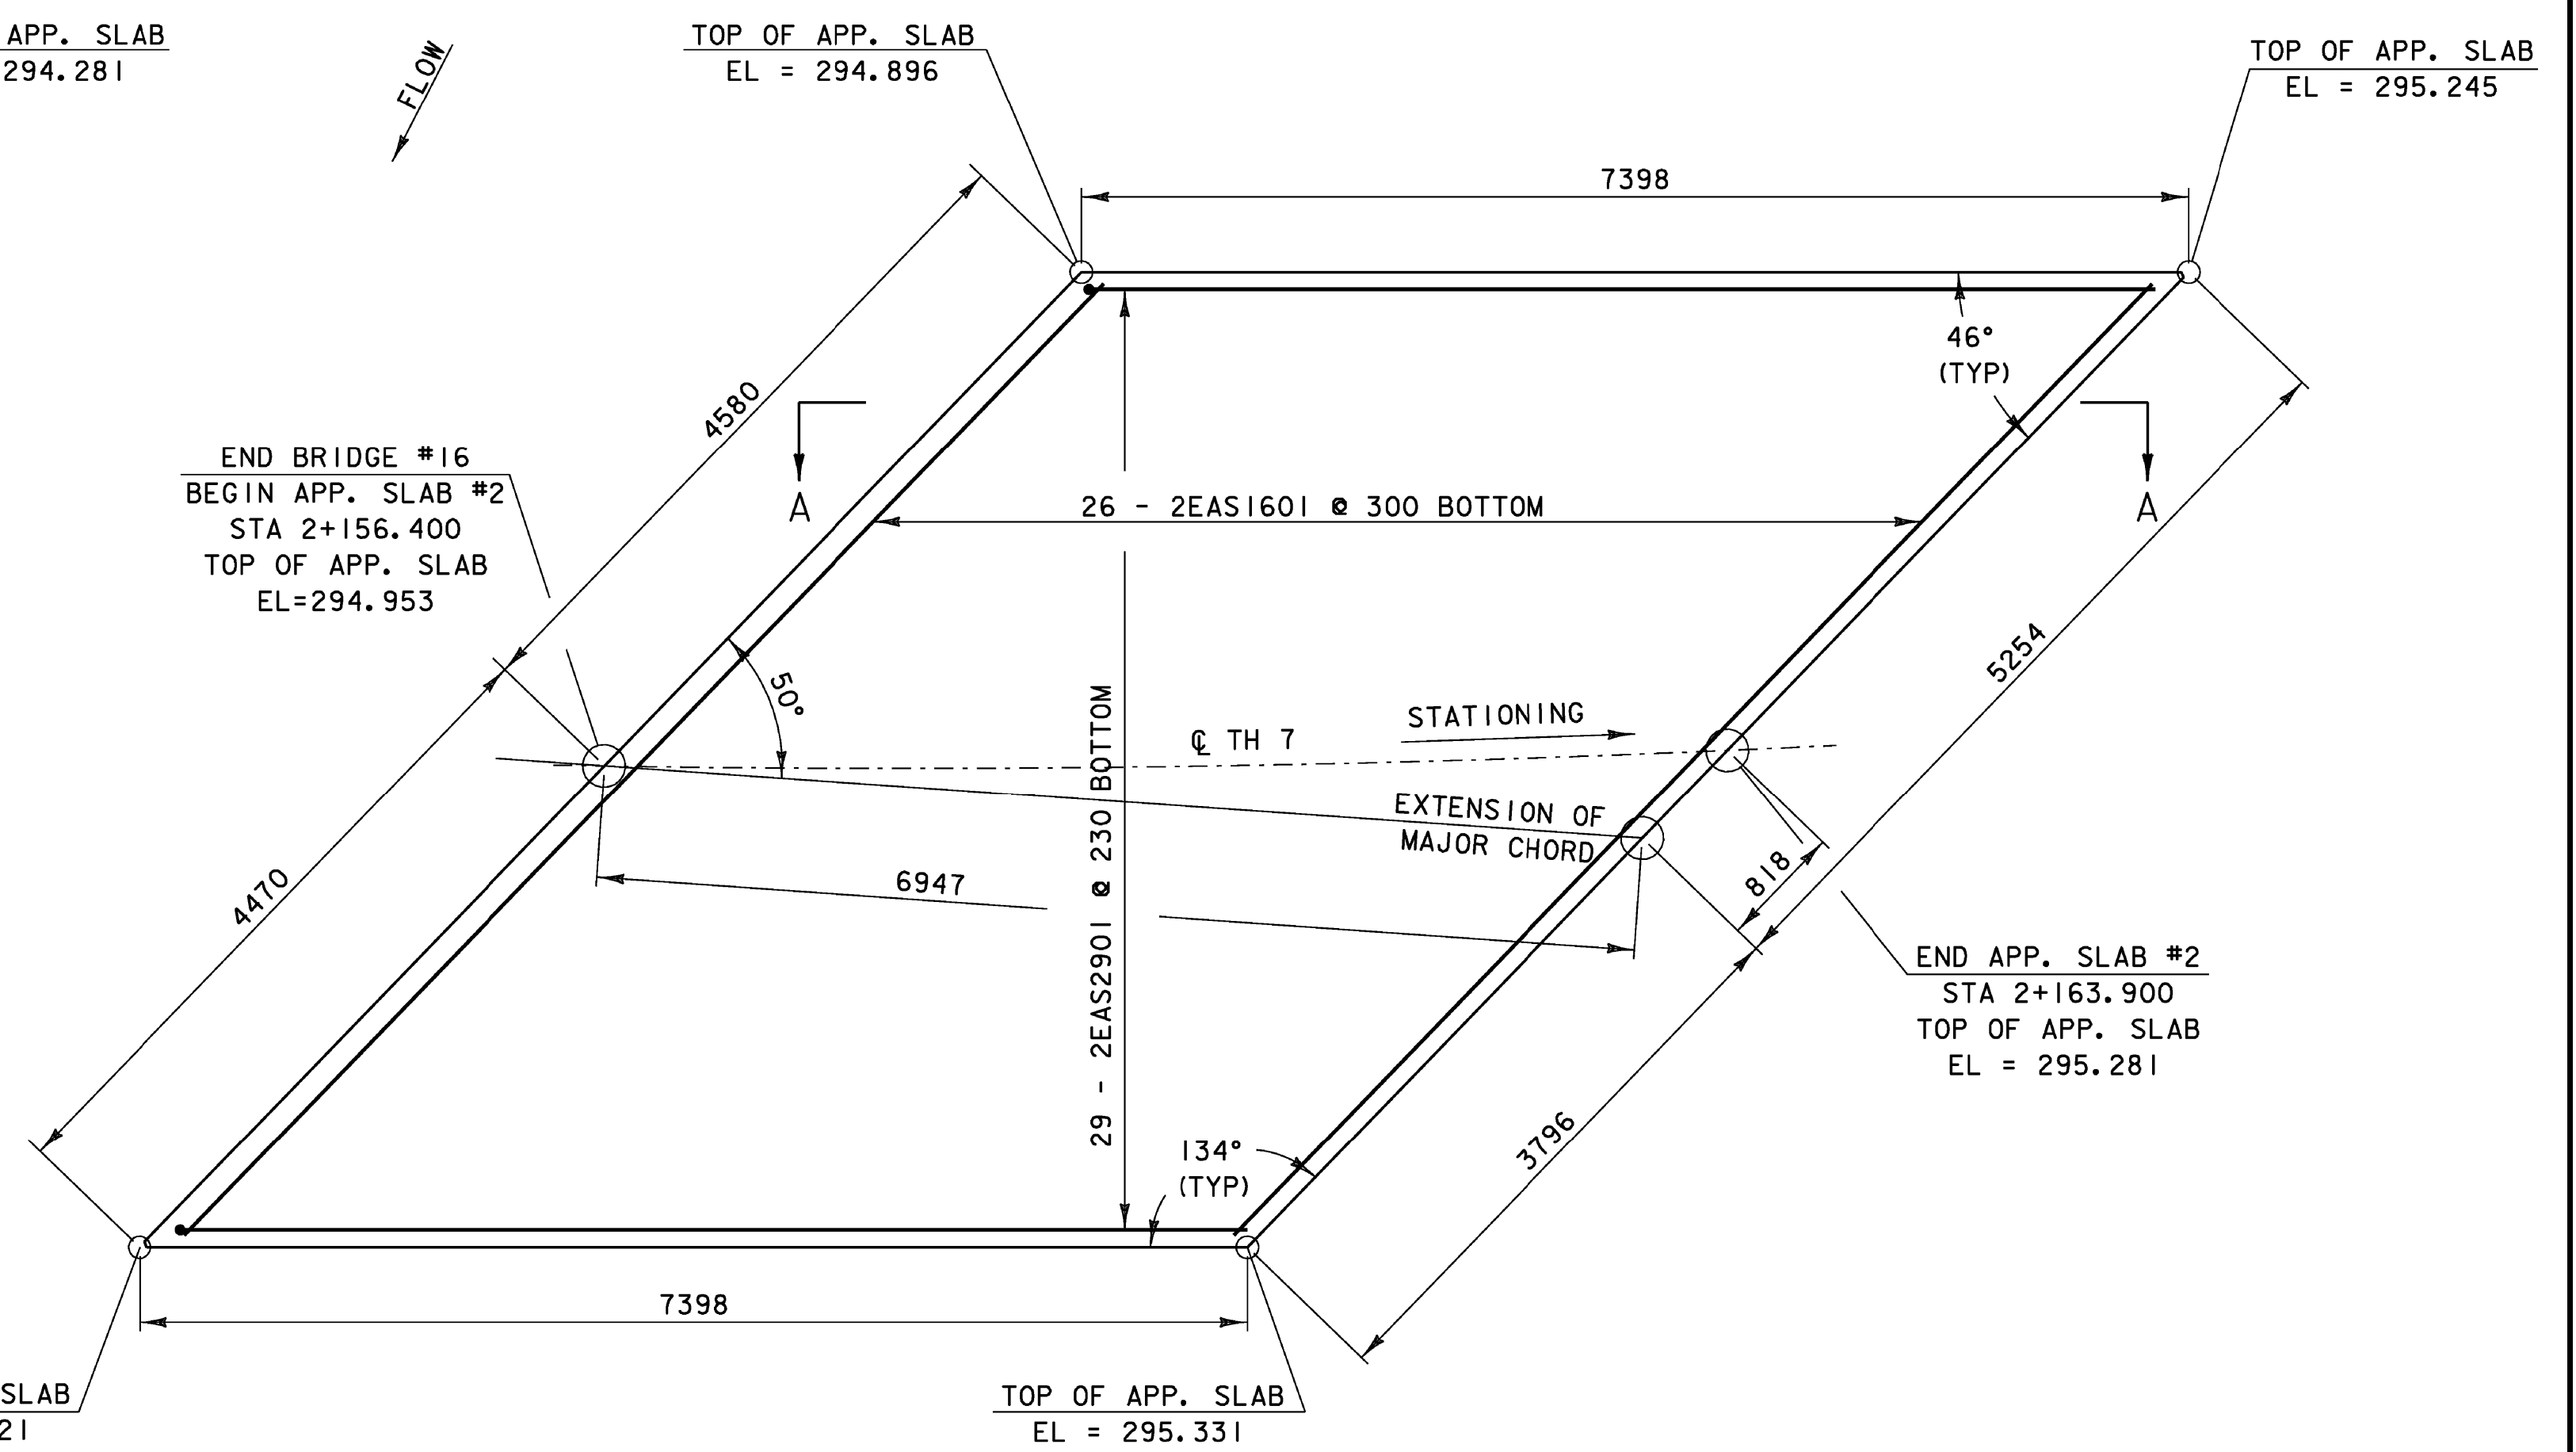
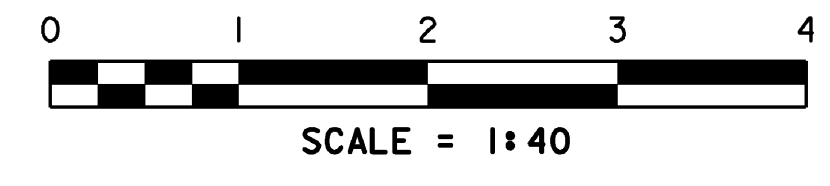




BRIDGE No. 16 APPROACH SLAB #1 PLAN

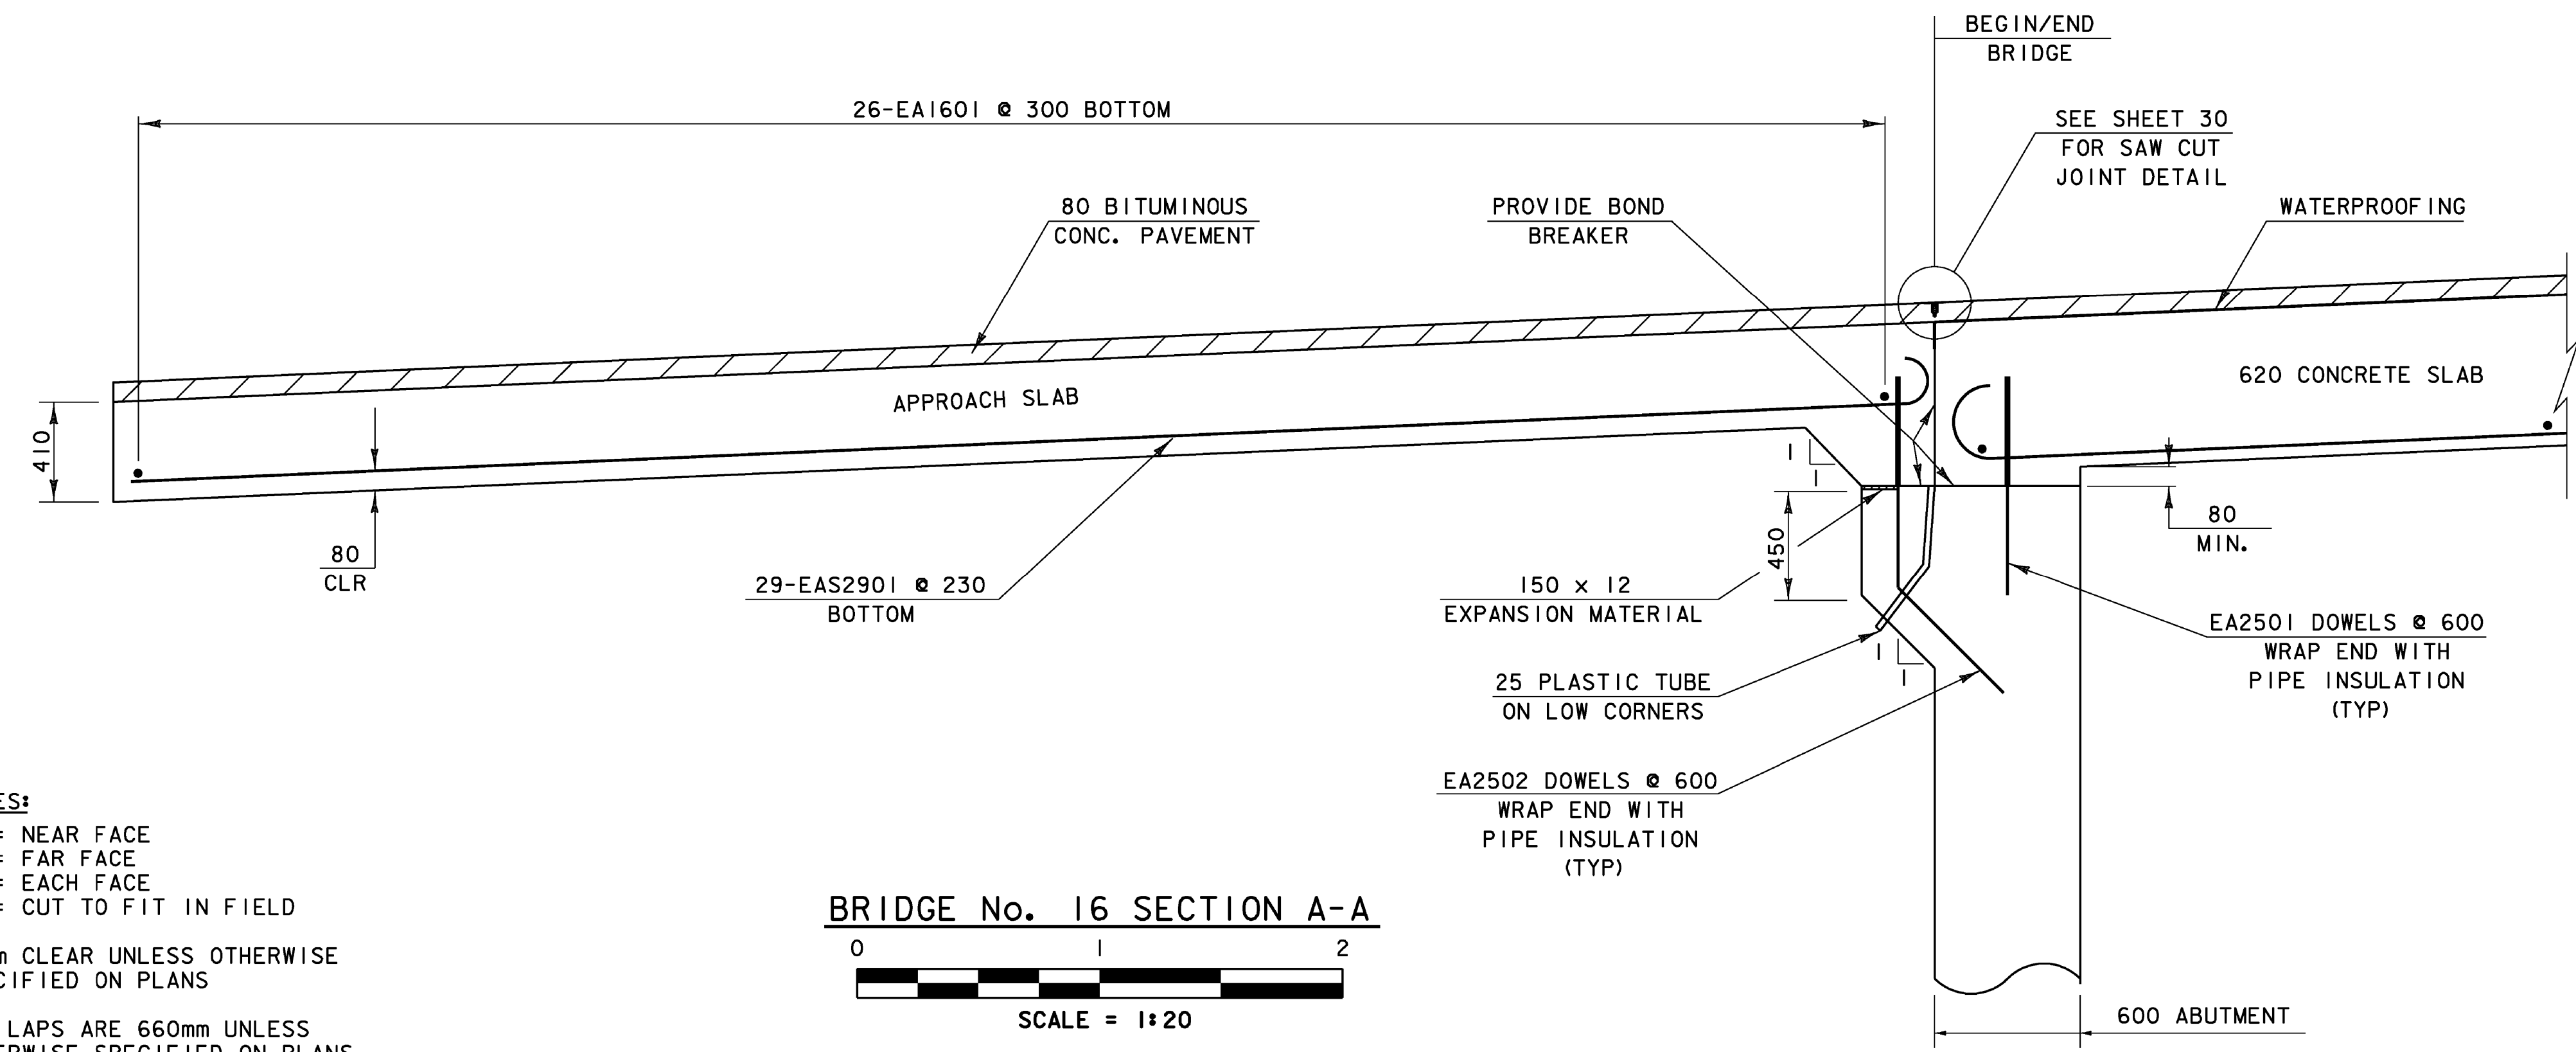

BRIDGE No. 16 APPROACH SLAB #2 PLAN

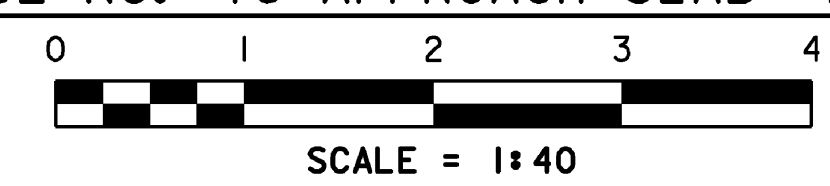

BRIDGE No. 16 SECTION A-A

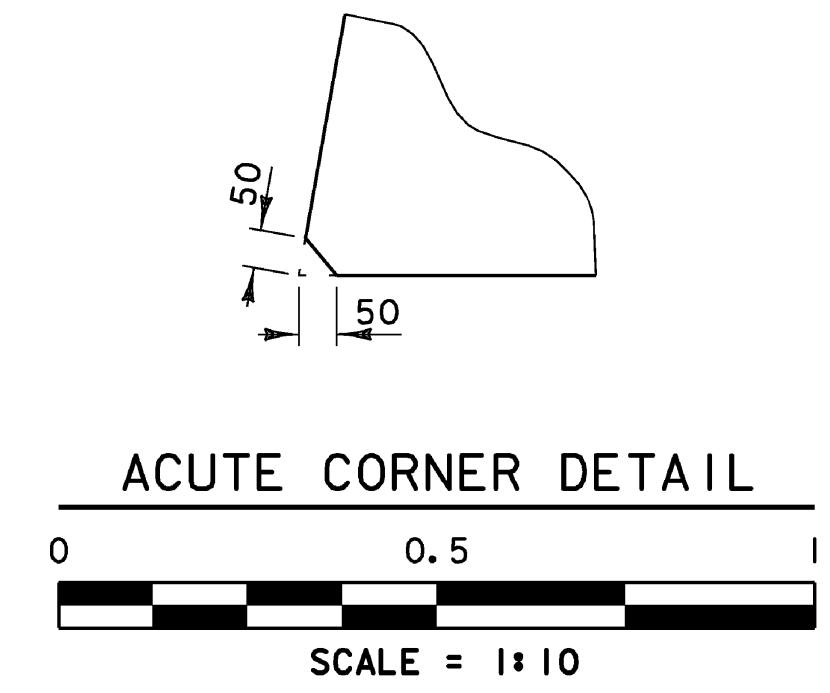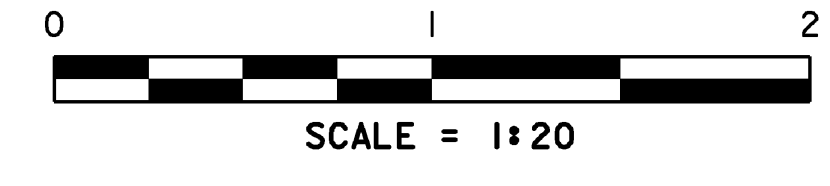

**NOTES:**  
 NF = NEAR FACE  
 FF = FAR FACE  
 EF = EACH FACE  
 ▲ = CUT TO FIT IN FIELD  
 80mm CLEAR UNLESS OTHERWISE SPECIFIED ON PLANS  
 ALL LAPS ARE 660mm UNLESS OTHERWISE SPECIFIED ON PLANS

SEE VALUE ENGINEERED DESIGN.  
 THIS SHEET NOT USED FOR RECORD PLANS.

PROJECT: <b>BURKE</b>	PROJECT NO.: <b>BRZ 1447 (15)</b>
DESIGN FILE NAME: se043slabs.dgn IPARM FILE NAME: se043br16aps.i DESIGNED BY: E.L.RUSTAY SQUAD LEADER: C.P.WILLIAMS BR. 16 APPROACH SLAB DETAILS	PLOT DATE: 10-MAR-2008 DRAWN BY: E.L.RUSTAY CHECKED BY: K.M.HIGGINS SHEET: 32 OF 81