


FINAL CONDITIONS SITE PLAN

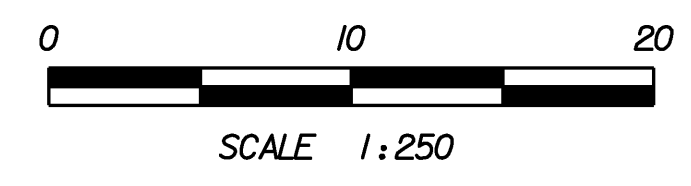

DATUM	
VERTICAL	NAVD88
HORIZONTAL	NAD83 (92)

PROJECT: BURKE	PROJECT NO.: BRZ 1447 (15)
DESIGN FILE NAME: 87e043/structures/se043bdr.dgn	PLOT DATE: 10-MAR-2008
IPARM FILE NAME: se043fInconl.l	SURVEY DATE: 12/95
SURVEYED BY: A. MYERS	DRAWN BY: M.FESSEL
SQUAD LEADER: C. P. WILLIAMS	SHEET: 54 OF 81
FINAL CONDITIONS SITE PLAN	