


LEGEND	
	RIPARIAN BUFFER ZONE

DATUM	
VERTICAL	NAVD88
HORIZONTAL	NAD83 (92)

FINAL CONDITIONS BRIDGE 17

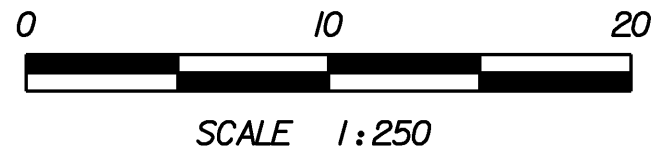

PROJECT: BURKE	PROJECT NO.: BRZ 1447 (15)
DESIGN FILE NAME: 87e043/structures/se043bdr_ero.dgn	PLOT DATE: 10-MAR-2008
IPARM FILE NAME: se043fIncon3.l	SURVEY DATE: 12/95
SURVEYED BY: A. MYERS	DRAWN BY: M.FESSEL
SQUAD LEADER: C. P. WILLIAMS	SHEET: 56 OF 81
FINAL CONDITIONS BRIDGE 17	