

RIGHT - OF - WAY DETAIL SHEET




TABLE OF PROPERTY ACQUISITION

PARCEL NO.	PROPERTY OWNER	SHEET NO.	BEGINNING STATION	ENDING STATION	TAKE	REMAINDER	RIGHT			RECORDING DATA				REMARKS	
					AREA ±	AREA ±	TYPE	(T/W/P)	AREA ±	TITLE	DATE	TOWN / CITY	BOOK		PAGE
6	MATTEIS, VINCENT M. & LORRAINE C.	20,21	2+091.627 RT.	2+152.081 LT.	364 SM					WDOE	6/23/2004	BURKE	96	529-531	3918 S.F.±
			2+050.693 RT.	2+144.587 RT.				CONST.	(T)	469 SM					5048 S.F.±: INCLUDES EROSION CONTROL & LOD
			2+079.000 RT.	2+094.000 RT.				CULVERT	(T)						
			2+087.000 RT.					DRIVE	(T)						3.6M(11.8')
			2+100.000 RT.	2+135.000 RT.				LANDSCAPE	(T)						2 APPLE TREES
			2+100.000 RT.	2+120.000 RT.				SLOPE	(T)	43 SM					463 S.F.±: INCLUDES SEDIMENT TRAP
			2+120.000 RT.	2+133.815 RT.				SLOPE	(P)	48 SM					517 S.F.±: INCLUDES SEDIMENT TRAP
			2+133.340 RT.	2+139.351 RT.				CHANNEL	(P)	24 SM					258 S.F.±
7	LYNDONVILLE ELECTRIC COMPANY														UTILITY
8	VERZON NEW ENGLAND, INC.														UTILITY
9	CHARTER ONE COMMUNICATIONS														UTILITY

TABLE OF REVISIONS

REVISION NO.	SHEET NO.	DESCRIPTION	DATE
1	----	GENERAL CHANGE THE NUMBERS OF THE PARCELS 2,3, AND 4 TO PARCELS 7,8 AND 9. PER C.O. 9341 MADE BY: MR. APPROVED: RPD	3/10/2004
2	19,20,21	PARCEL NO. 1 MATTEIS. CHANGE PARCEL NUMBER FROM PARCEL NO. 1 TO PARCEL NO. 6 PER C.O. 9340 MADE BY: MR. APPROVED: RPD	3/10/2004
		ELECTRONIC FILES TO STRUCTURES 10-31-07	

PLAN LEGEND

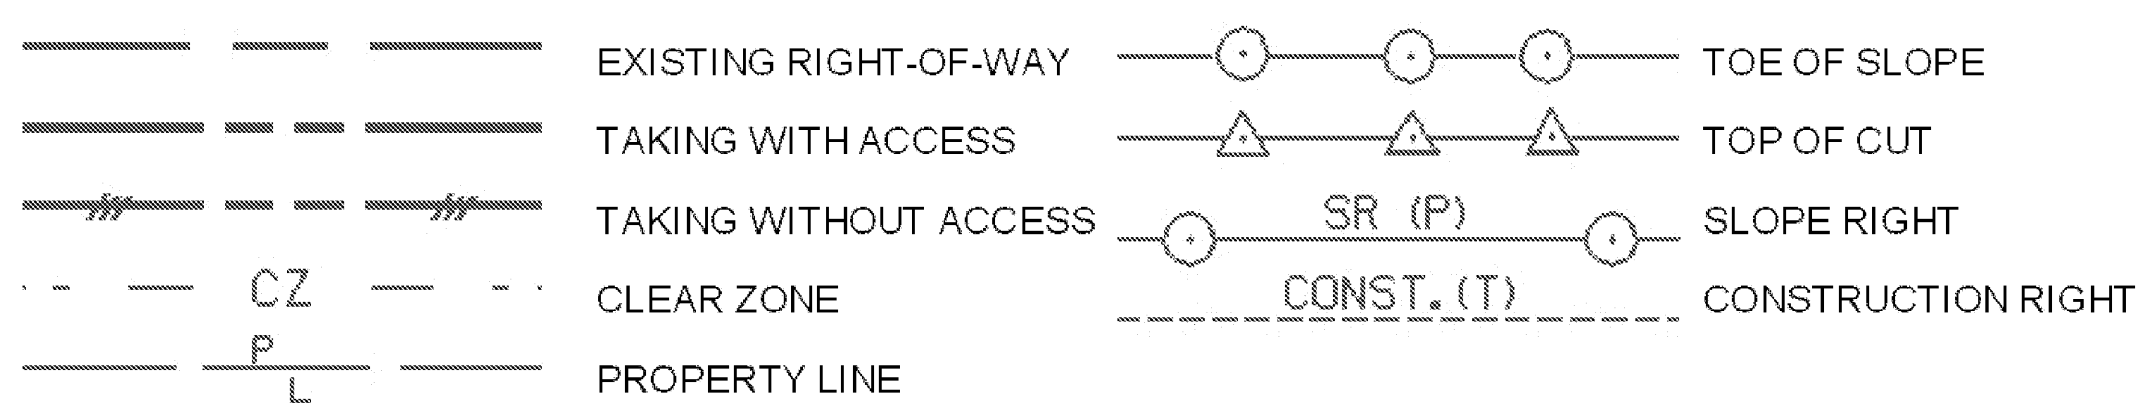

- (P) -PERMANENT
- (T) -TEMPORARY
- DR. -DRAINAGE RIGHT
- DIT. -DITCHING RIGHT
- CH. -CHANNEL RIGHT
- DRIVE -DRIVE RIGHT
- CUL. -CULVERT RIGHT
- C&T -CLEARING & TRIMMING RIGHT
- SR -SLOPE RIGHT
- UE -UTILITY EASEMENT

APPROVED: ROGER P. DUMAS DATE: 12-31-03
CHIEF, PLANS & TITLES

PROJECT NAME:	BURKE	PLOT DATE:	12/31/03
PROJECT NUMBER:	BRZ 1447(15)	DRAWN BY:	GJF
FILE NAME:	87e043d.xls	DESIGNED BY:	KHM
PROJECT LEADER:	C.P. WILLIAMS	CHECKED BY:	JFM
R.O.W. SHEET 19 of 23		SHEET	63 OF 81