
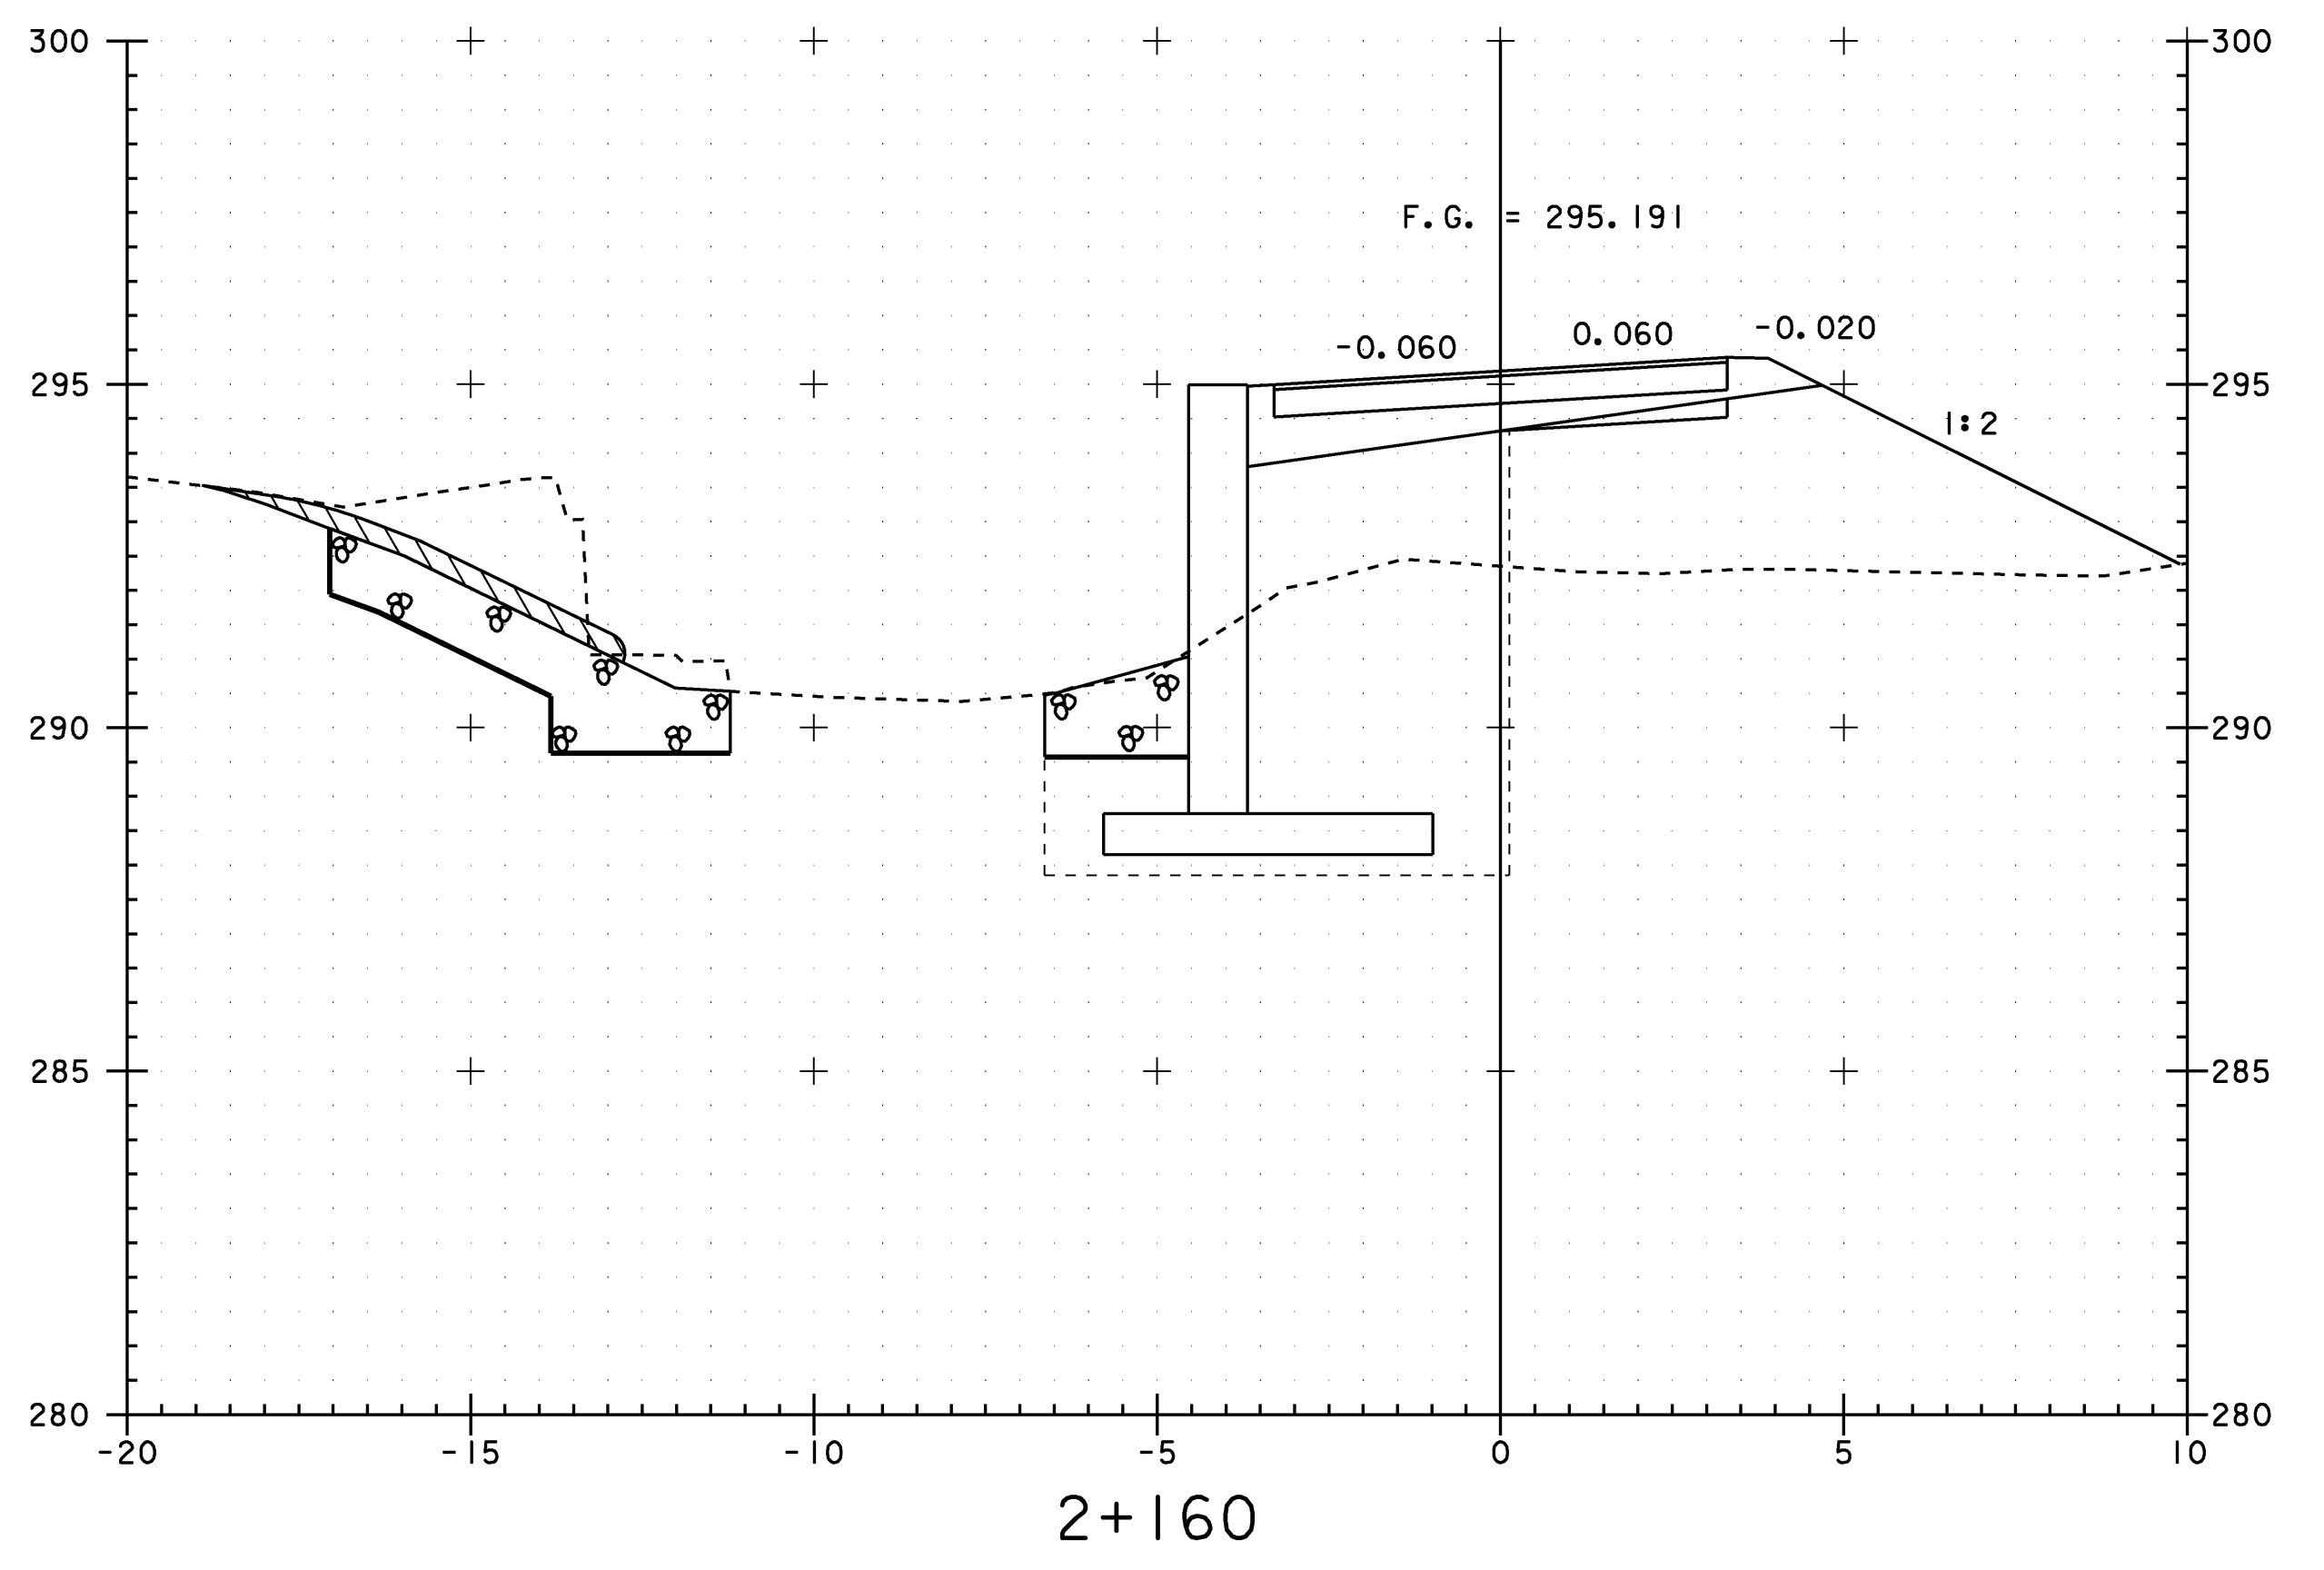




BEGIN BRIDGE 16  
STA 2+143.000

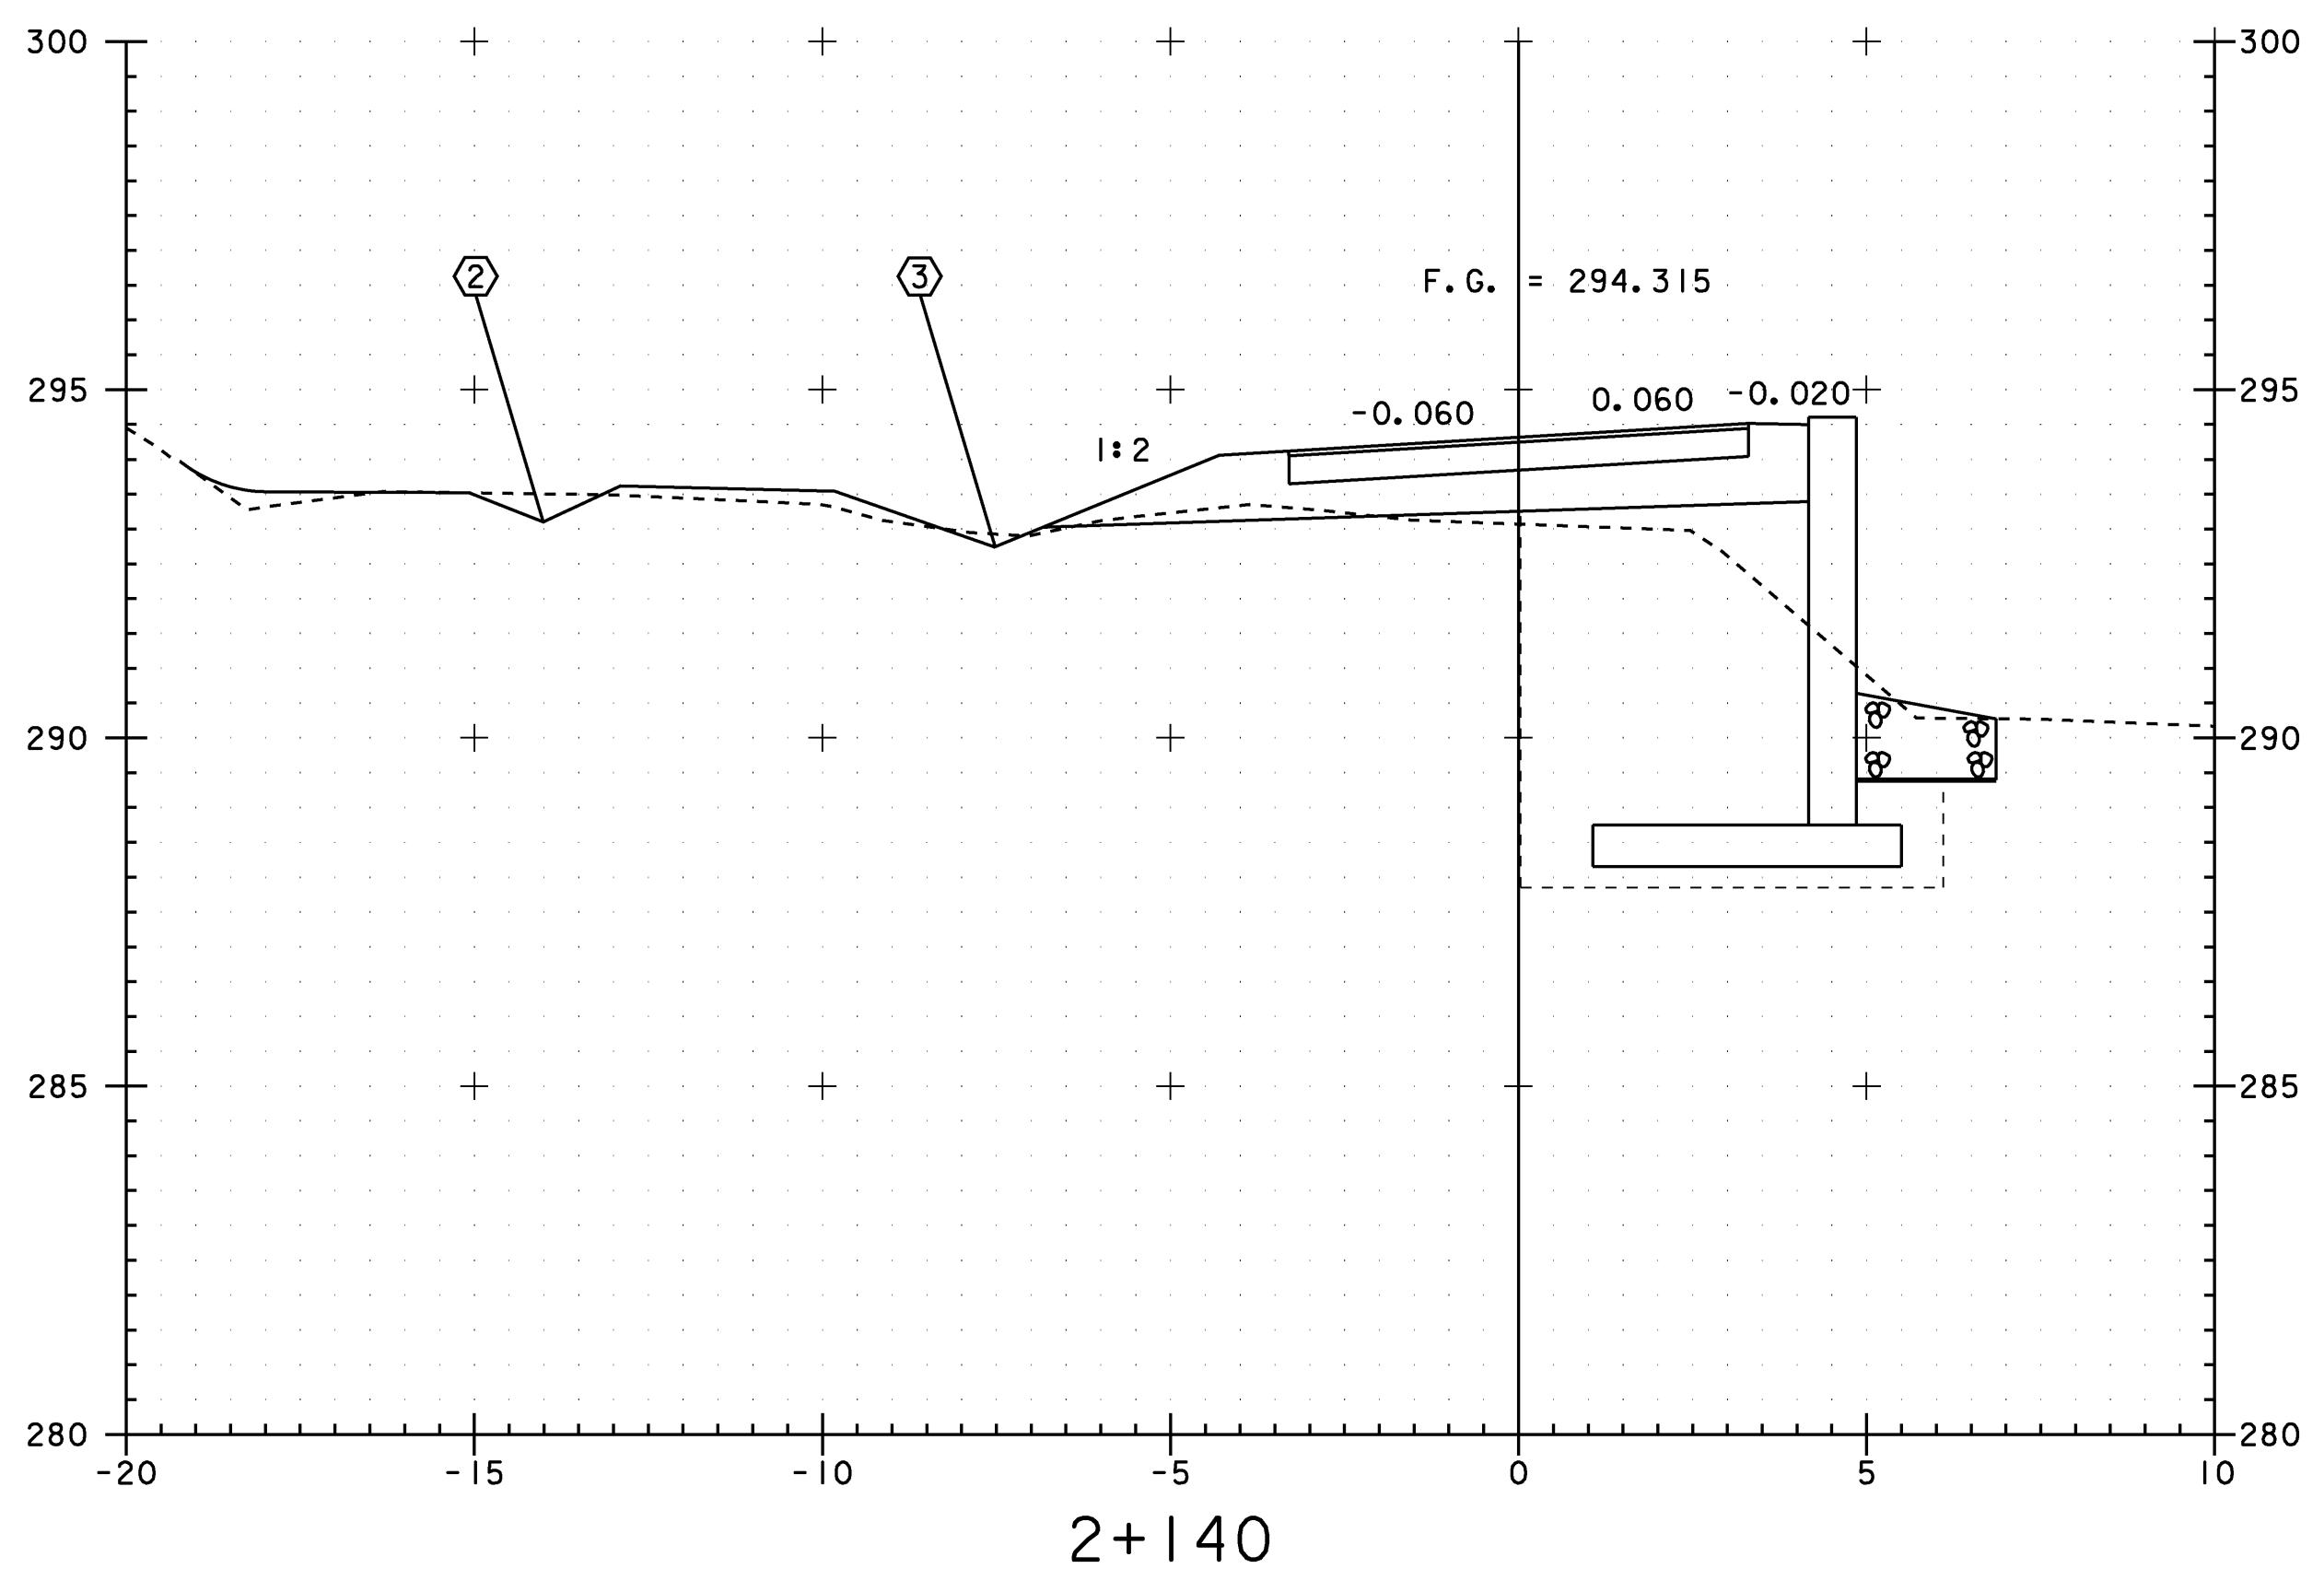

2+140

2+160

END BRIDGE 16  
STA 2+156.400

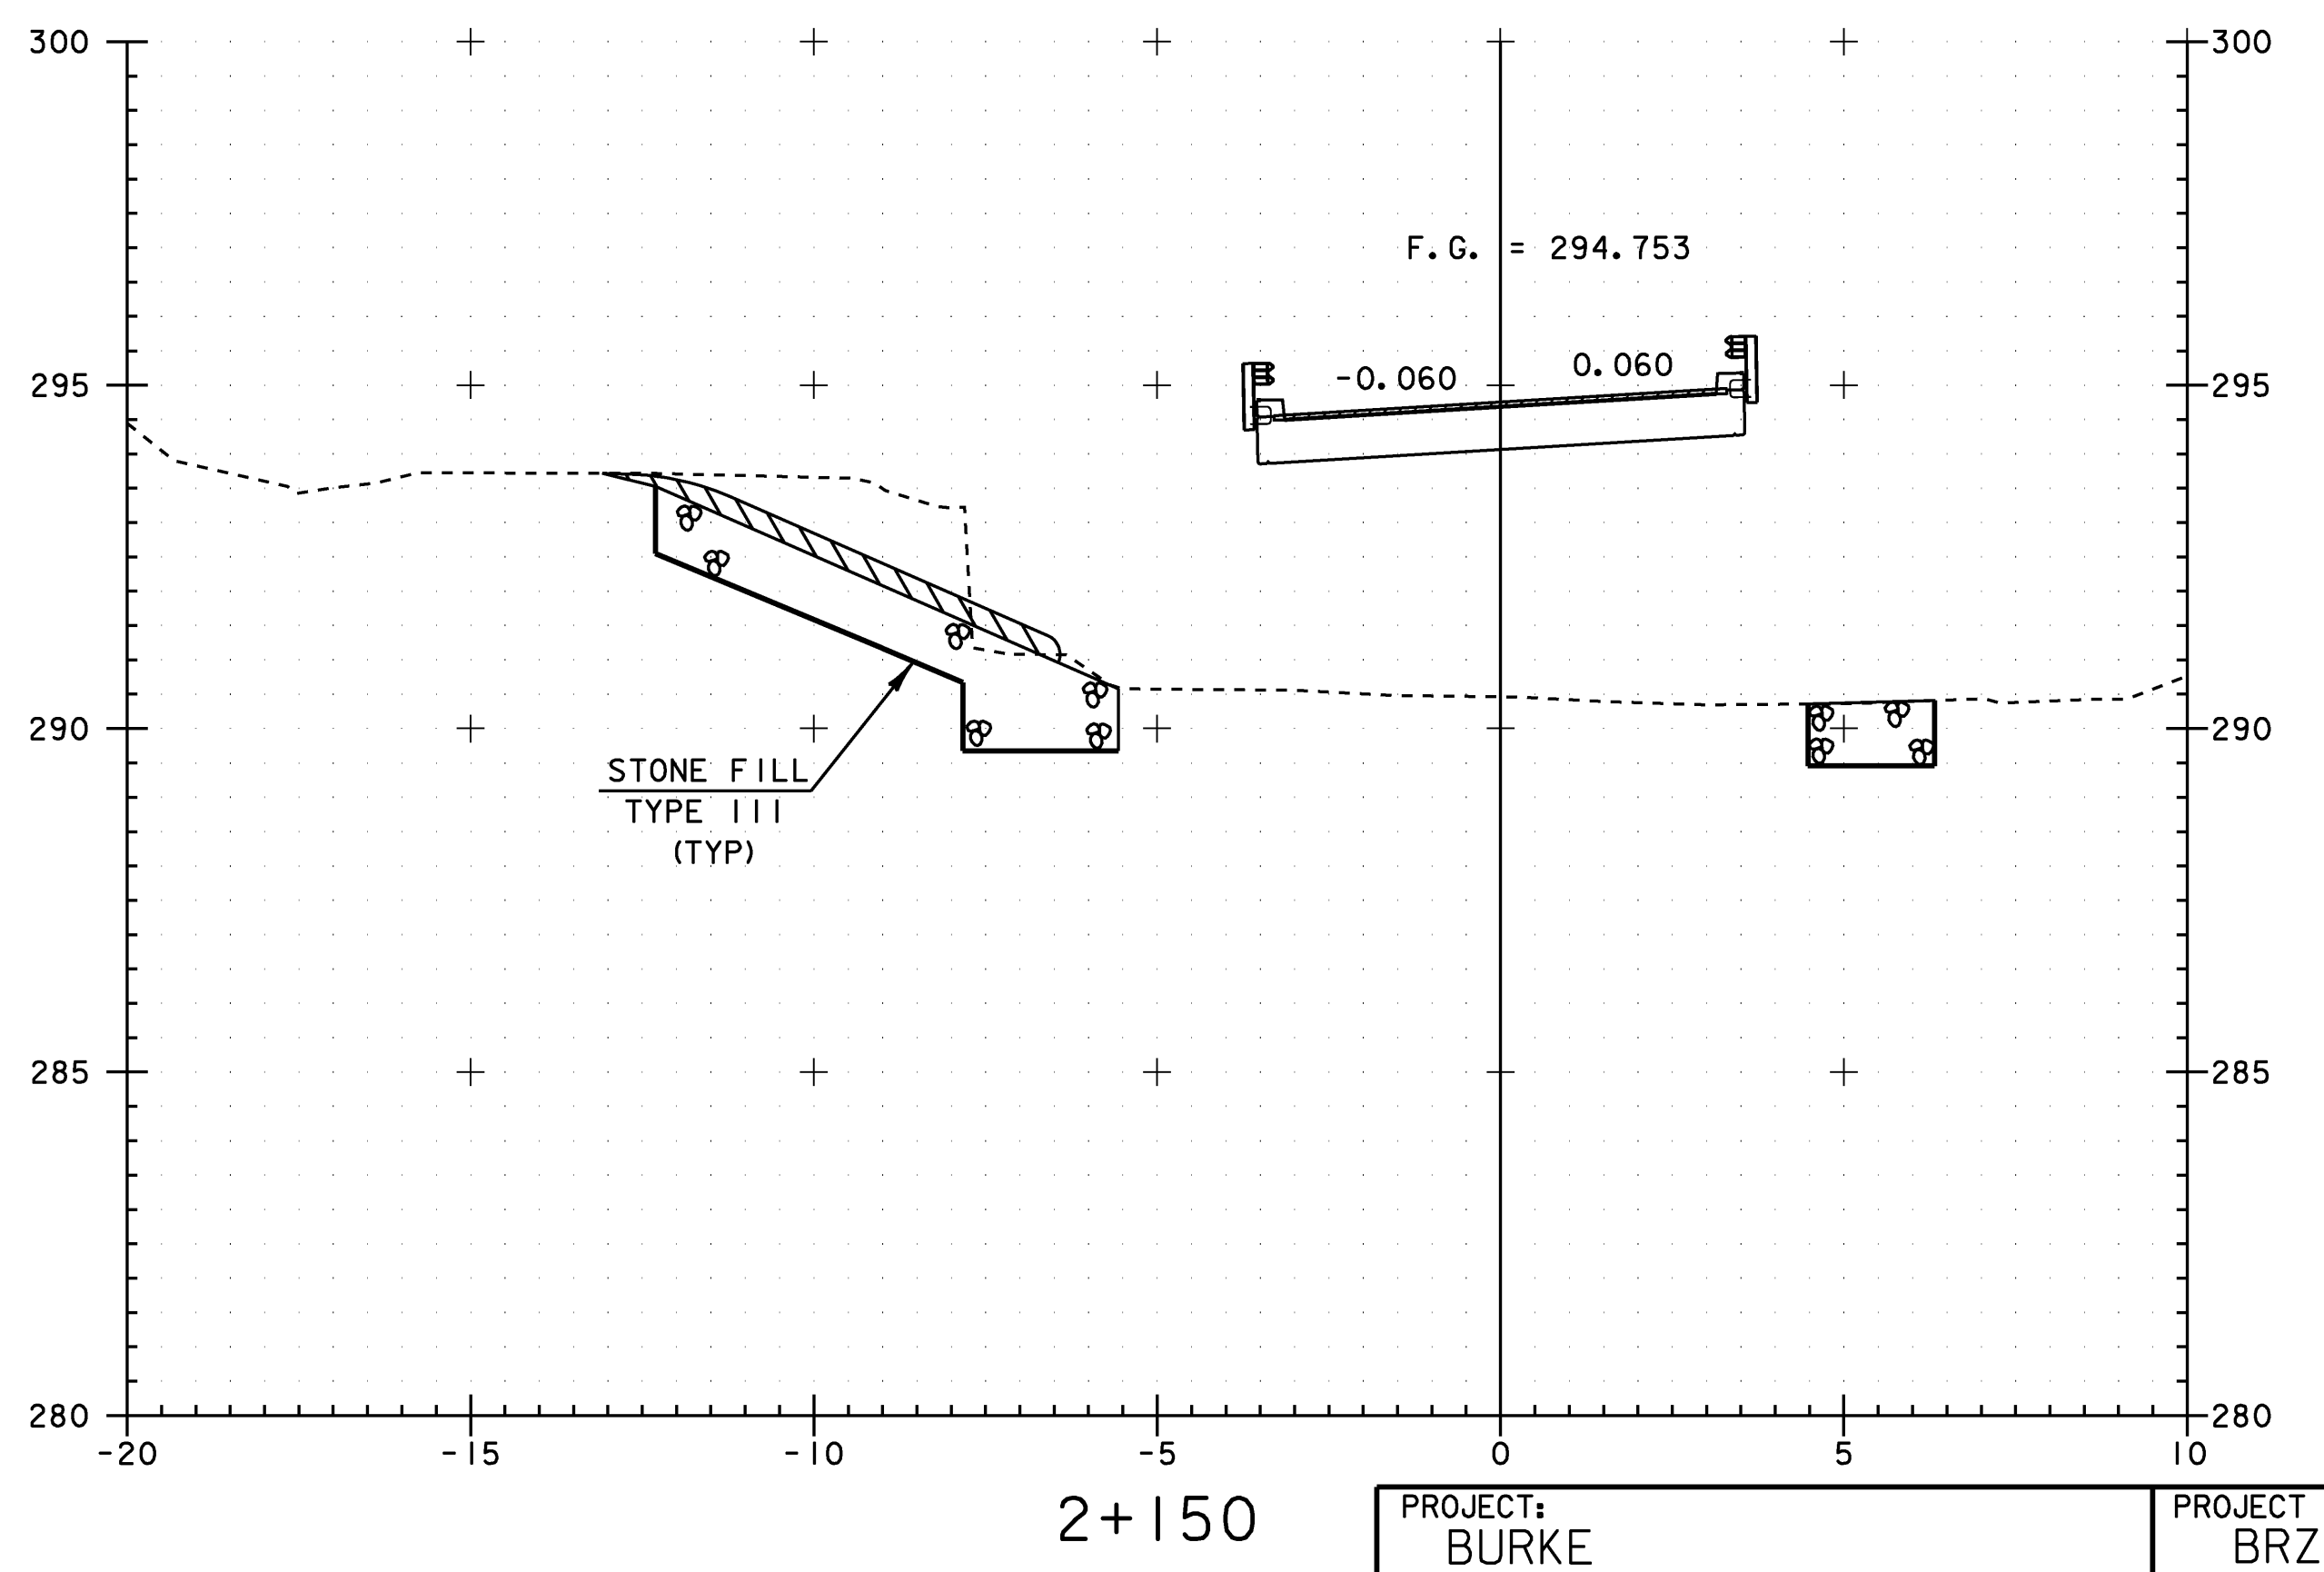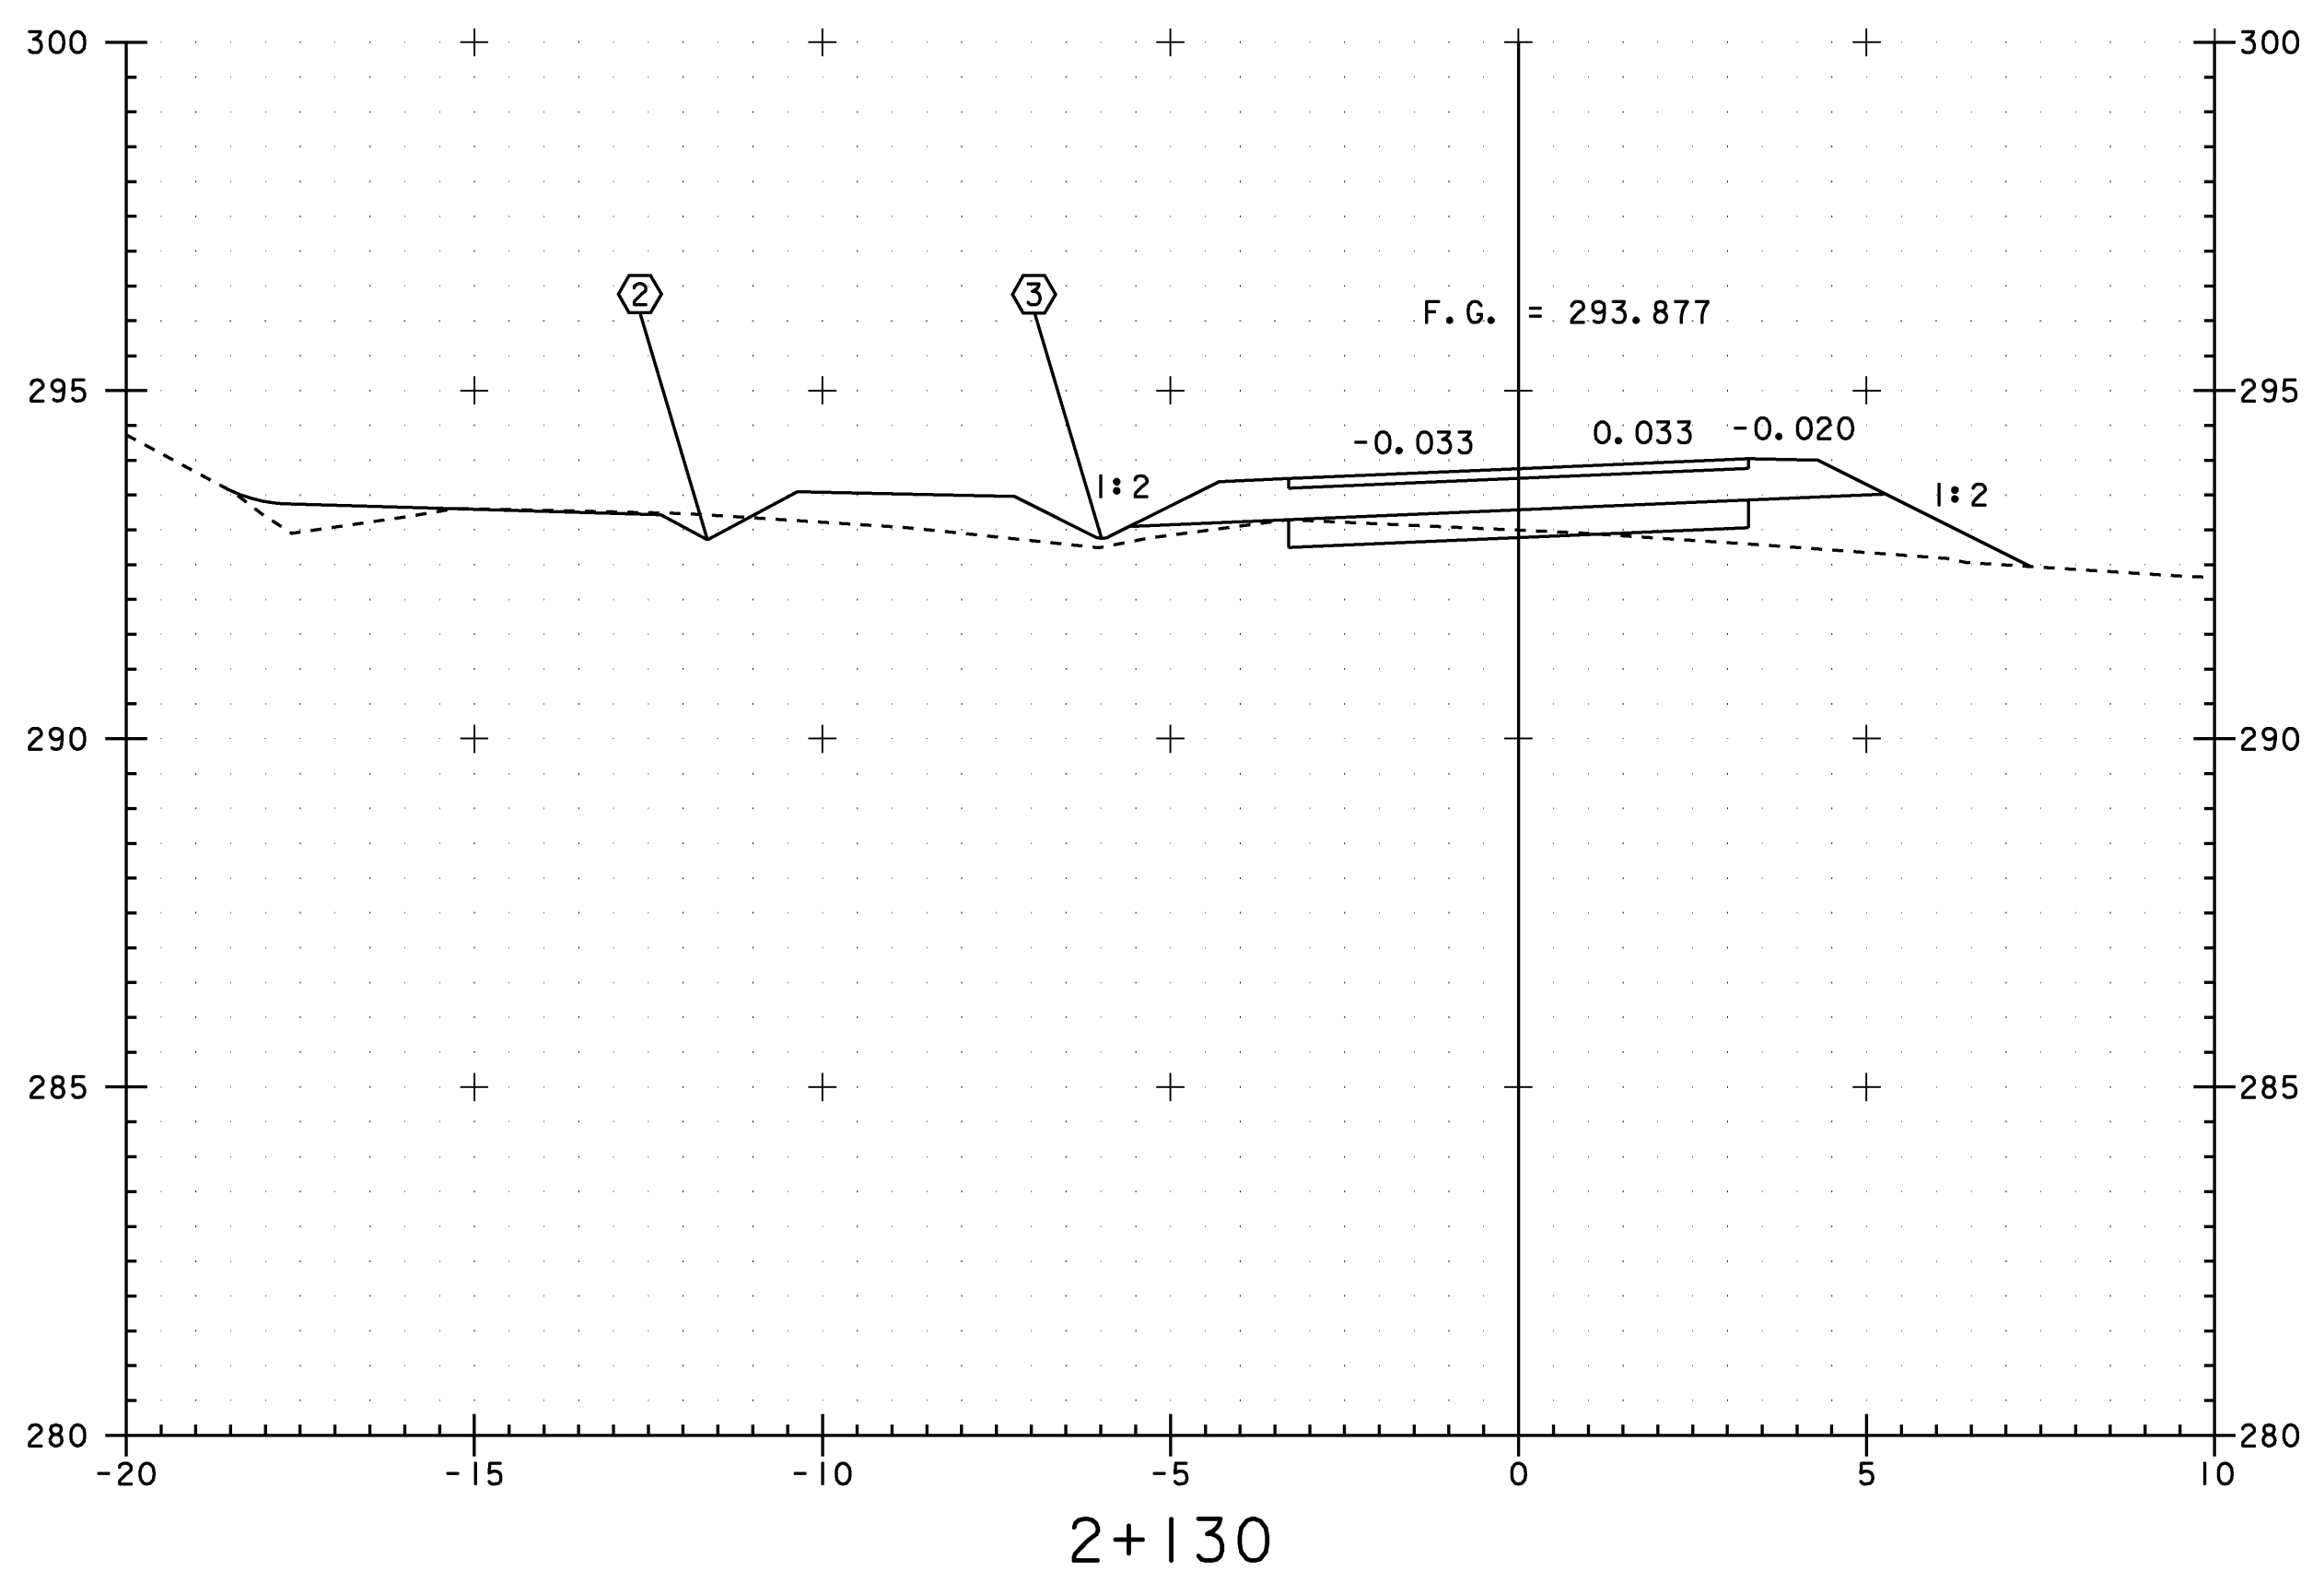

2+130

2+150

PROJECT: BURKE	PROJECT NO.: BRZ 1447 (15)
DESIGN FILE NAME: /str4/87e043/se043xsl.dgn	PLOT DATE: 14-MAR-2008
IPARM FILE NAME: /str4/87e043/se043m4.1	
MAINLINE CROSS SECTIONS	
SECTION 2+130 THROUGH 2+160	
SHEET: 67 OF 81	