



TRANSITION AT BEGIN OF PROJECT
NTS

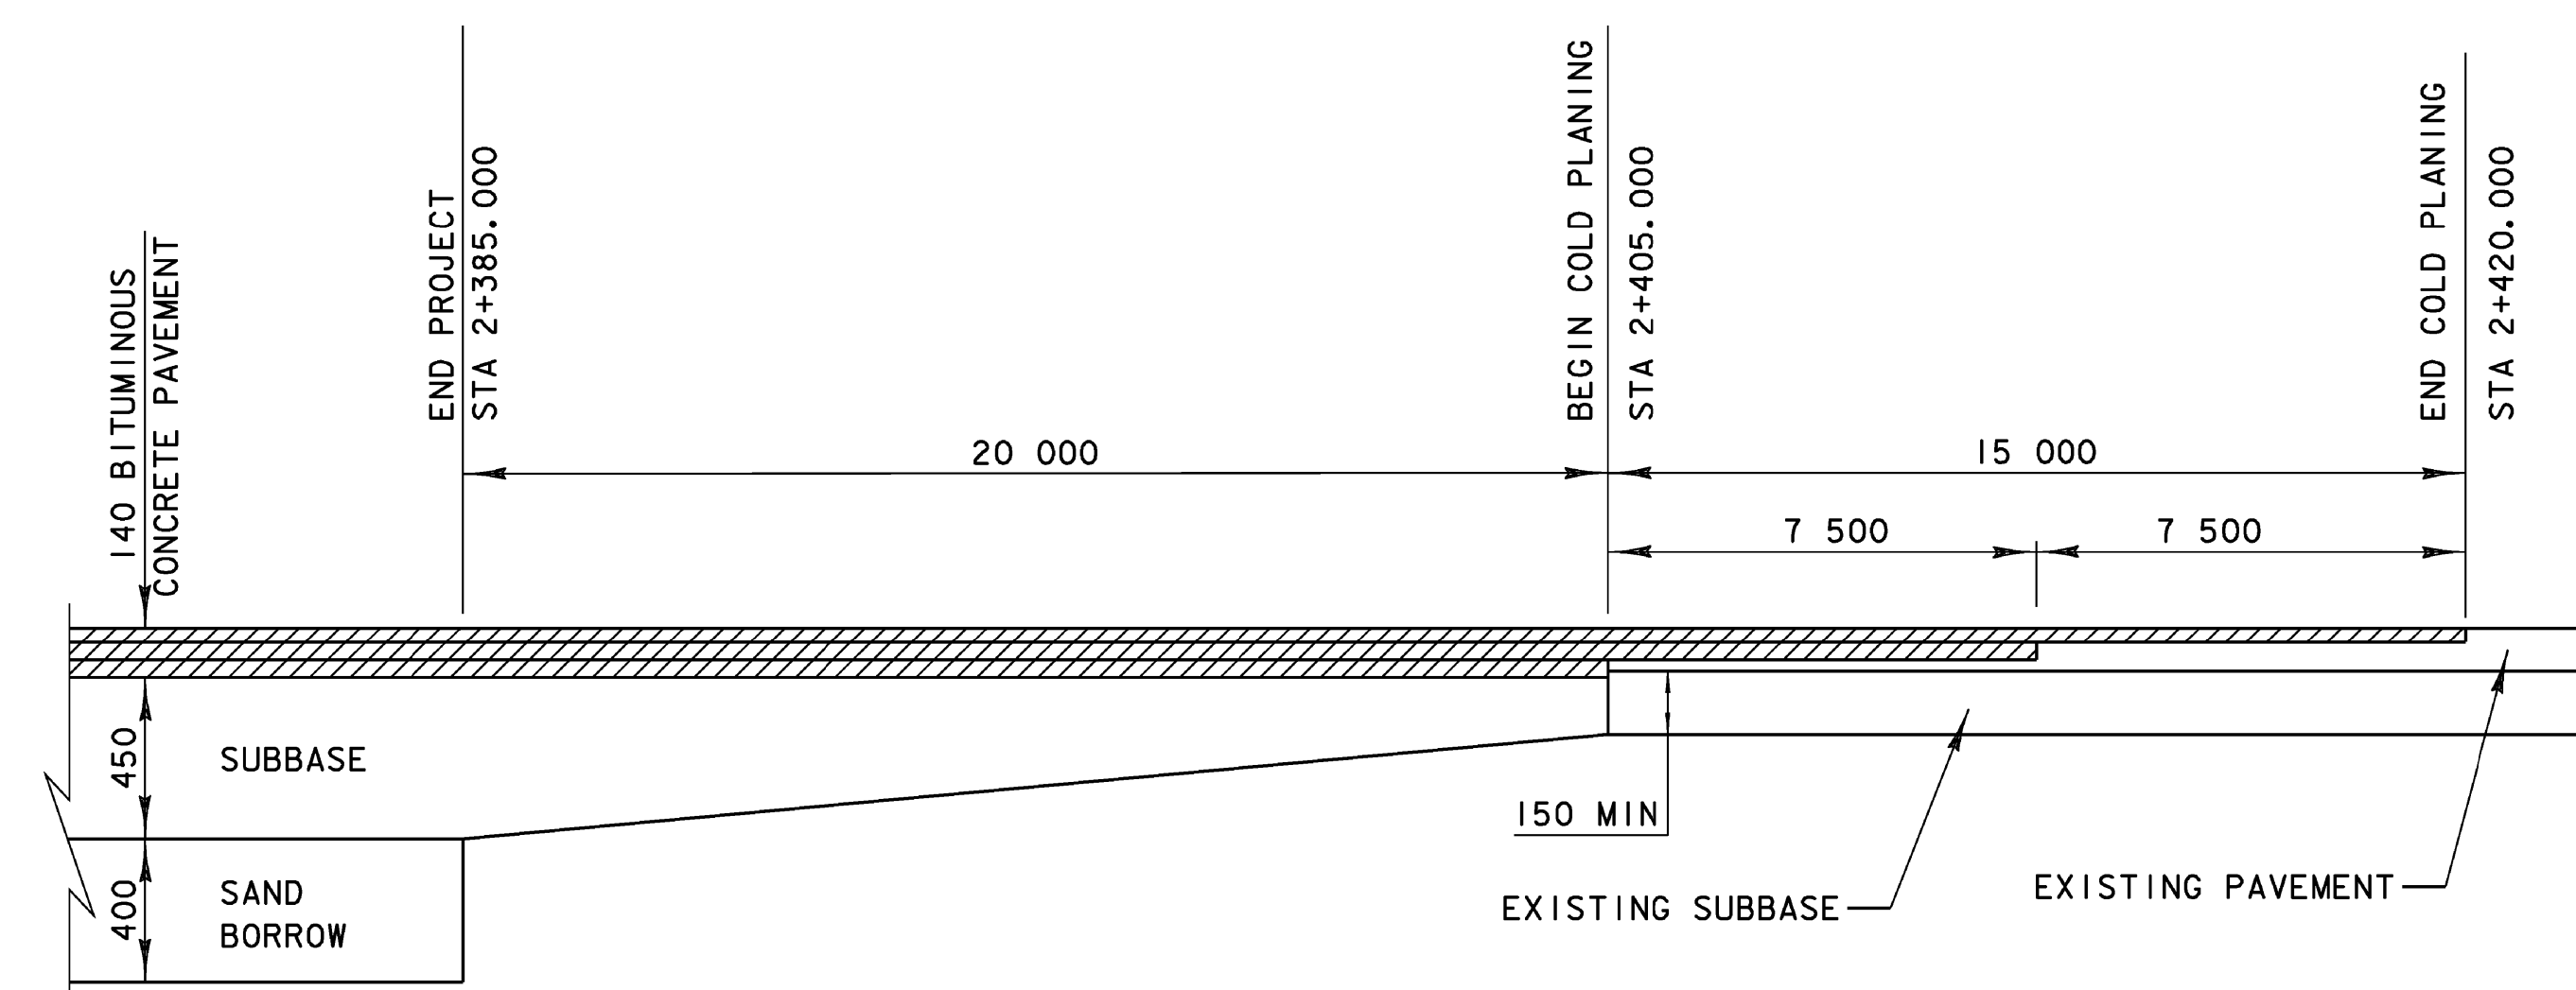

203.15 COMMON EXCAVATION
2+405 NO SECTION
AREA = 6.6m x (0.15m + 0.15m) = 1.98m²

TRANSITION AT END OF PROJECT
NTS

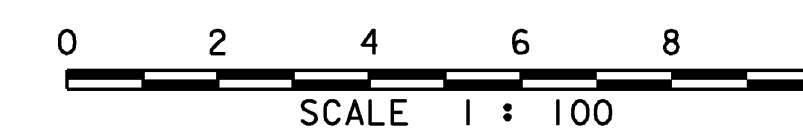

PROJECT: BURKE	PROJECT NO. : BRZ 1447 (15)
DESIGN FILE NAME: /str4/87e043/se043xsl.dgn	PLOT DATE: 10-MAR-2008
IPARM FILE NAME: /str4/87e043/se043mil.l	
MAINLINE CROSS SECTIONS & SUBBASE TRANSITIONS	
SECTION 2+410 THROUGH 2+420	SHEET: 74 OF 81