

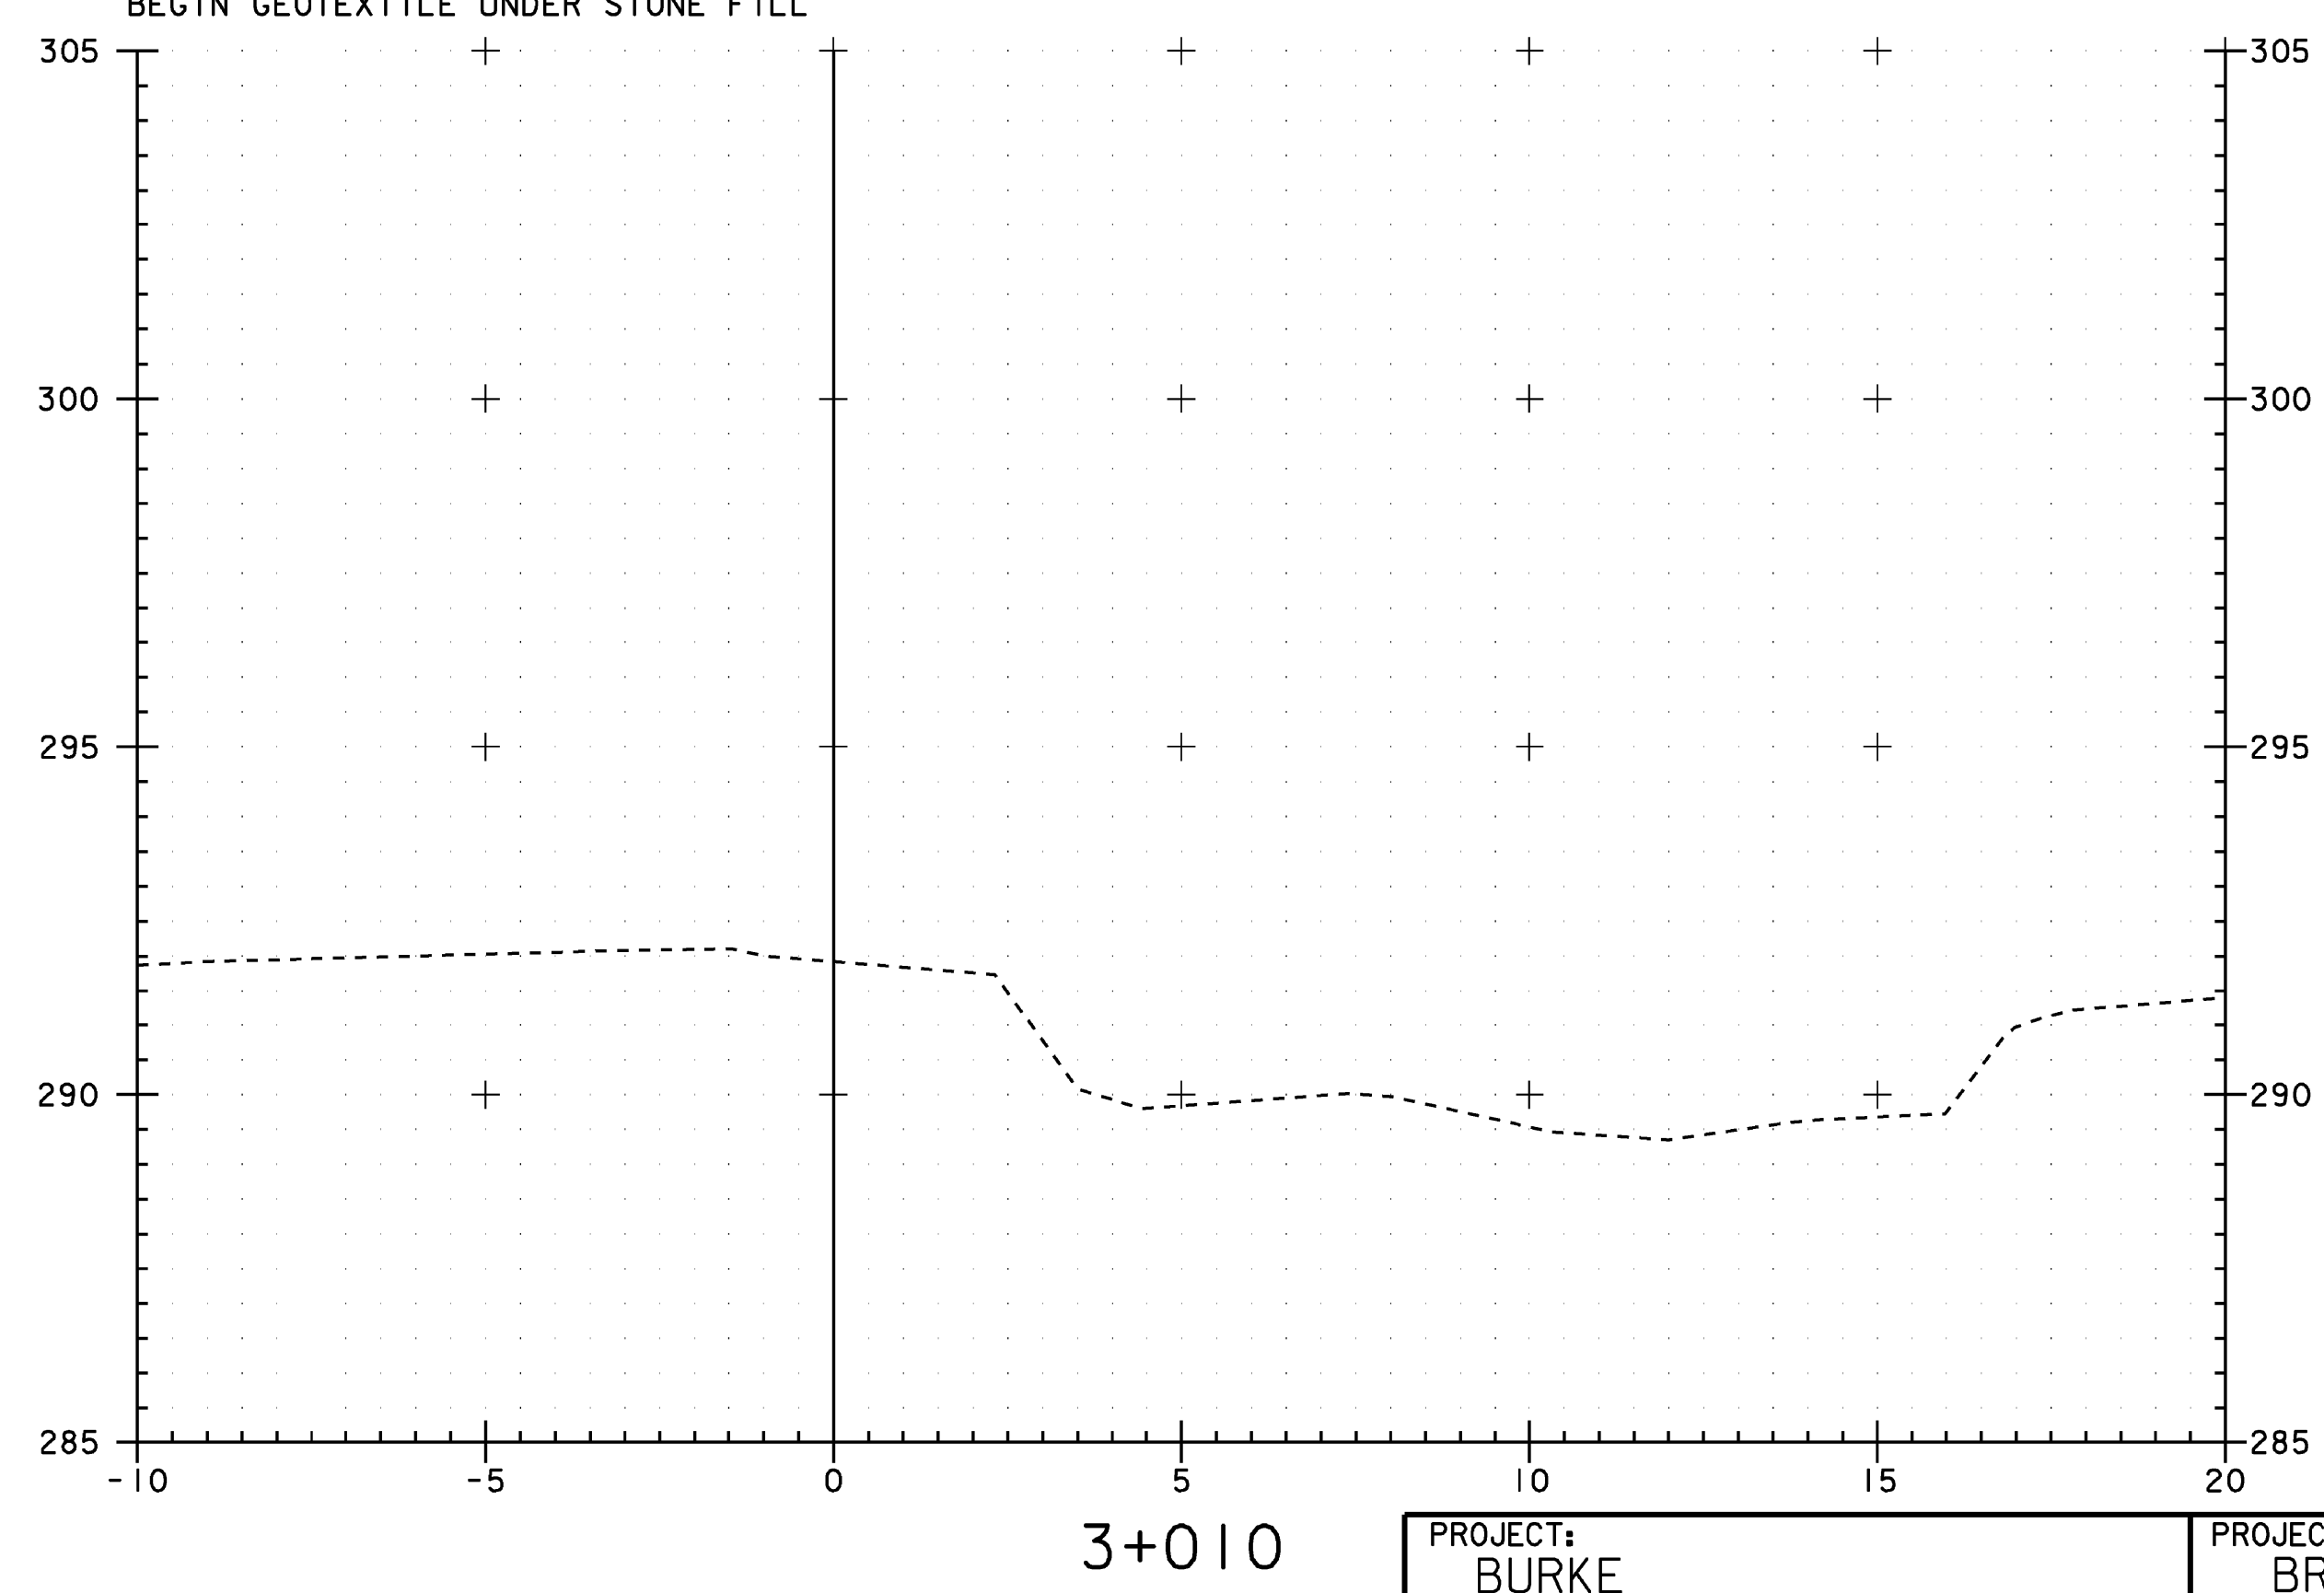


STA. 3+015 RIGHT (ABUTMENT 1)
 BEGIN STONE FILL TYPE III
 BEGIN UNCLASSIFIED EXCAVATION
 BEGIN GRUBBING MATERIAL
 BEGIN GEOTEXTILE UNDER STONE FILL

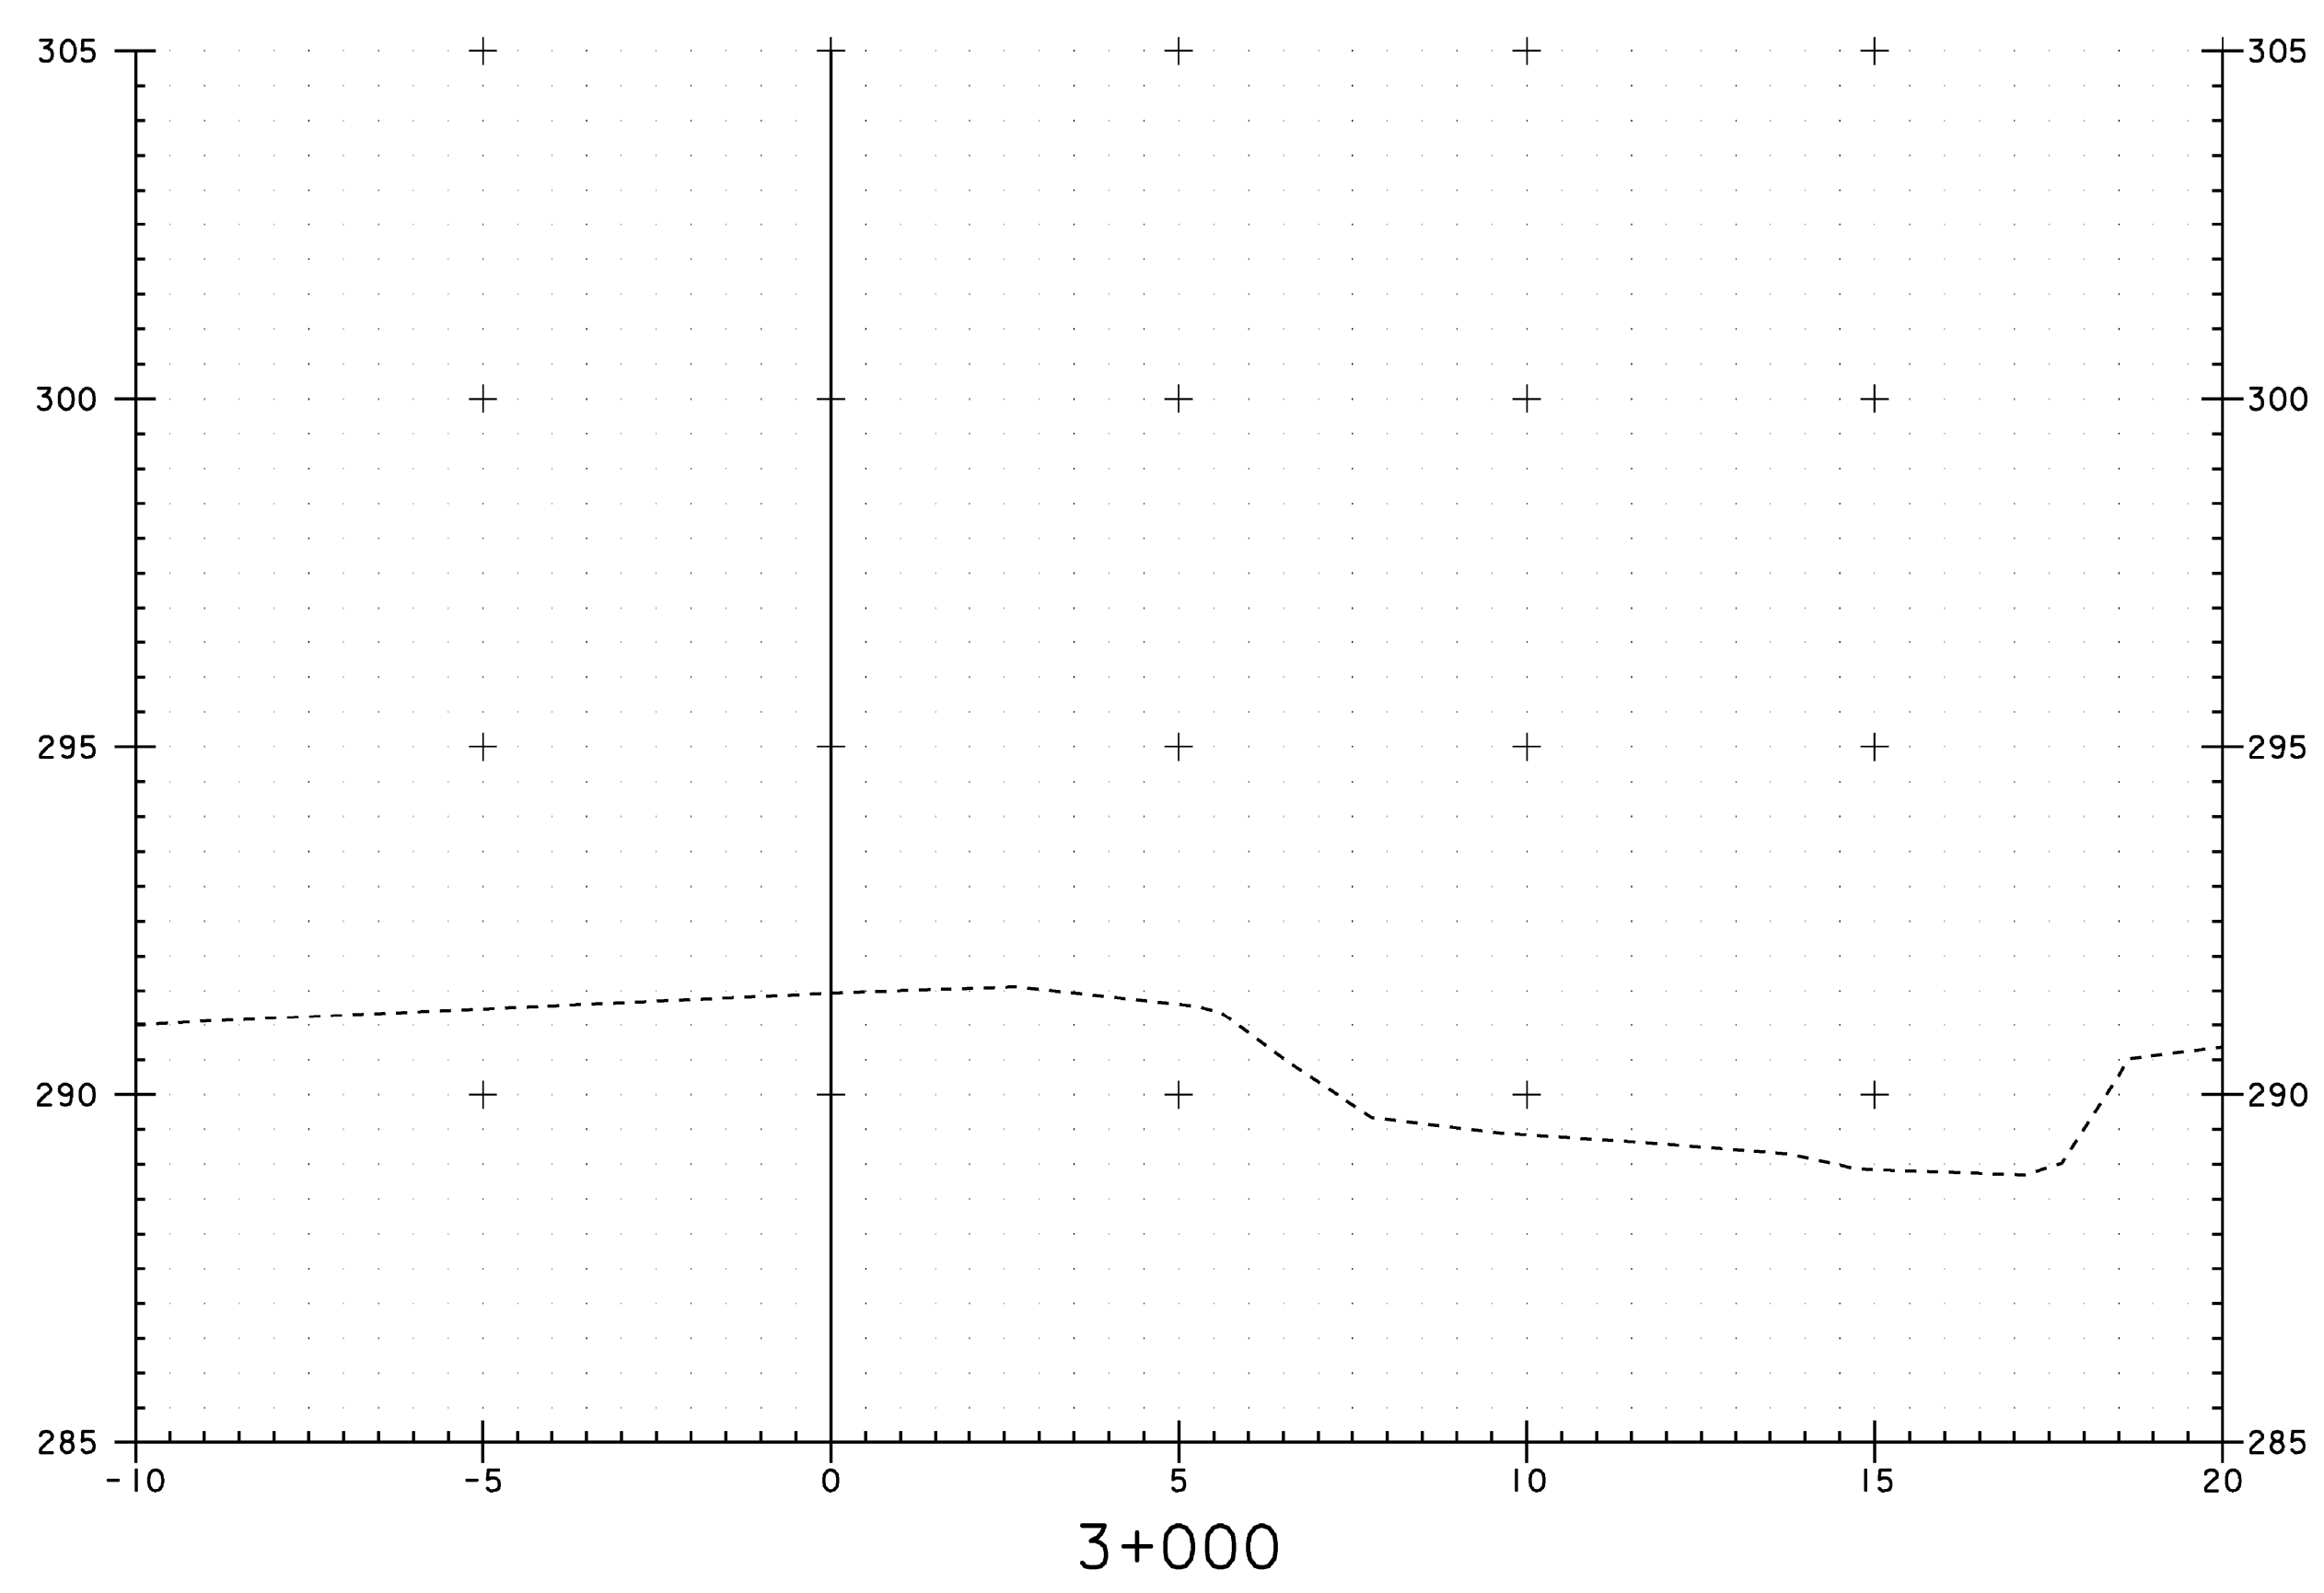

THIS SHEET NOT USED FOR RECORD PLANS. SEE VALUE ENGINEERED DESIGN.

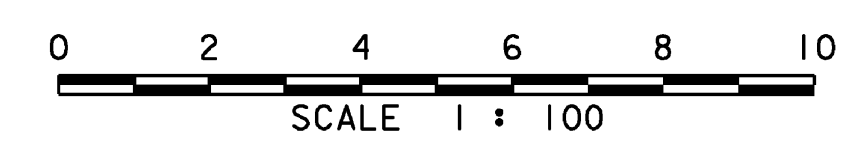

PROJECT: BURKE	PROJECT NO.: BRZ 1447 (15)
DESIGN FILE NAME: /str4/87e043/se043xsl.dgn	PLOT DATE: 10-MAR-2008
IPARM FILE NAME: /str4/87e043/se043chl1	
BRIDGE #16 CHANNEL CROSS SECTIONS	
SECTION 3+000 THROUGH 3+015	SHEET: 75 OF 81