
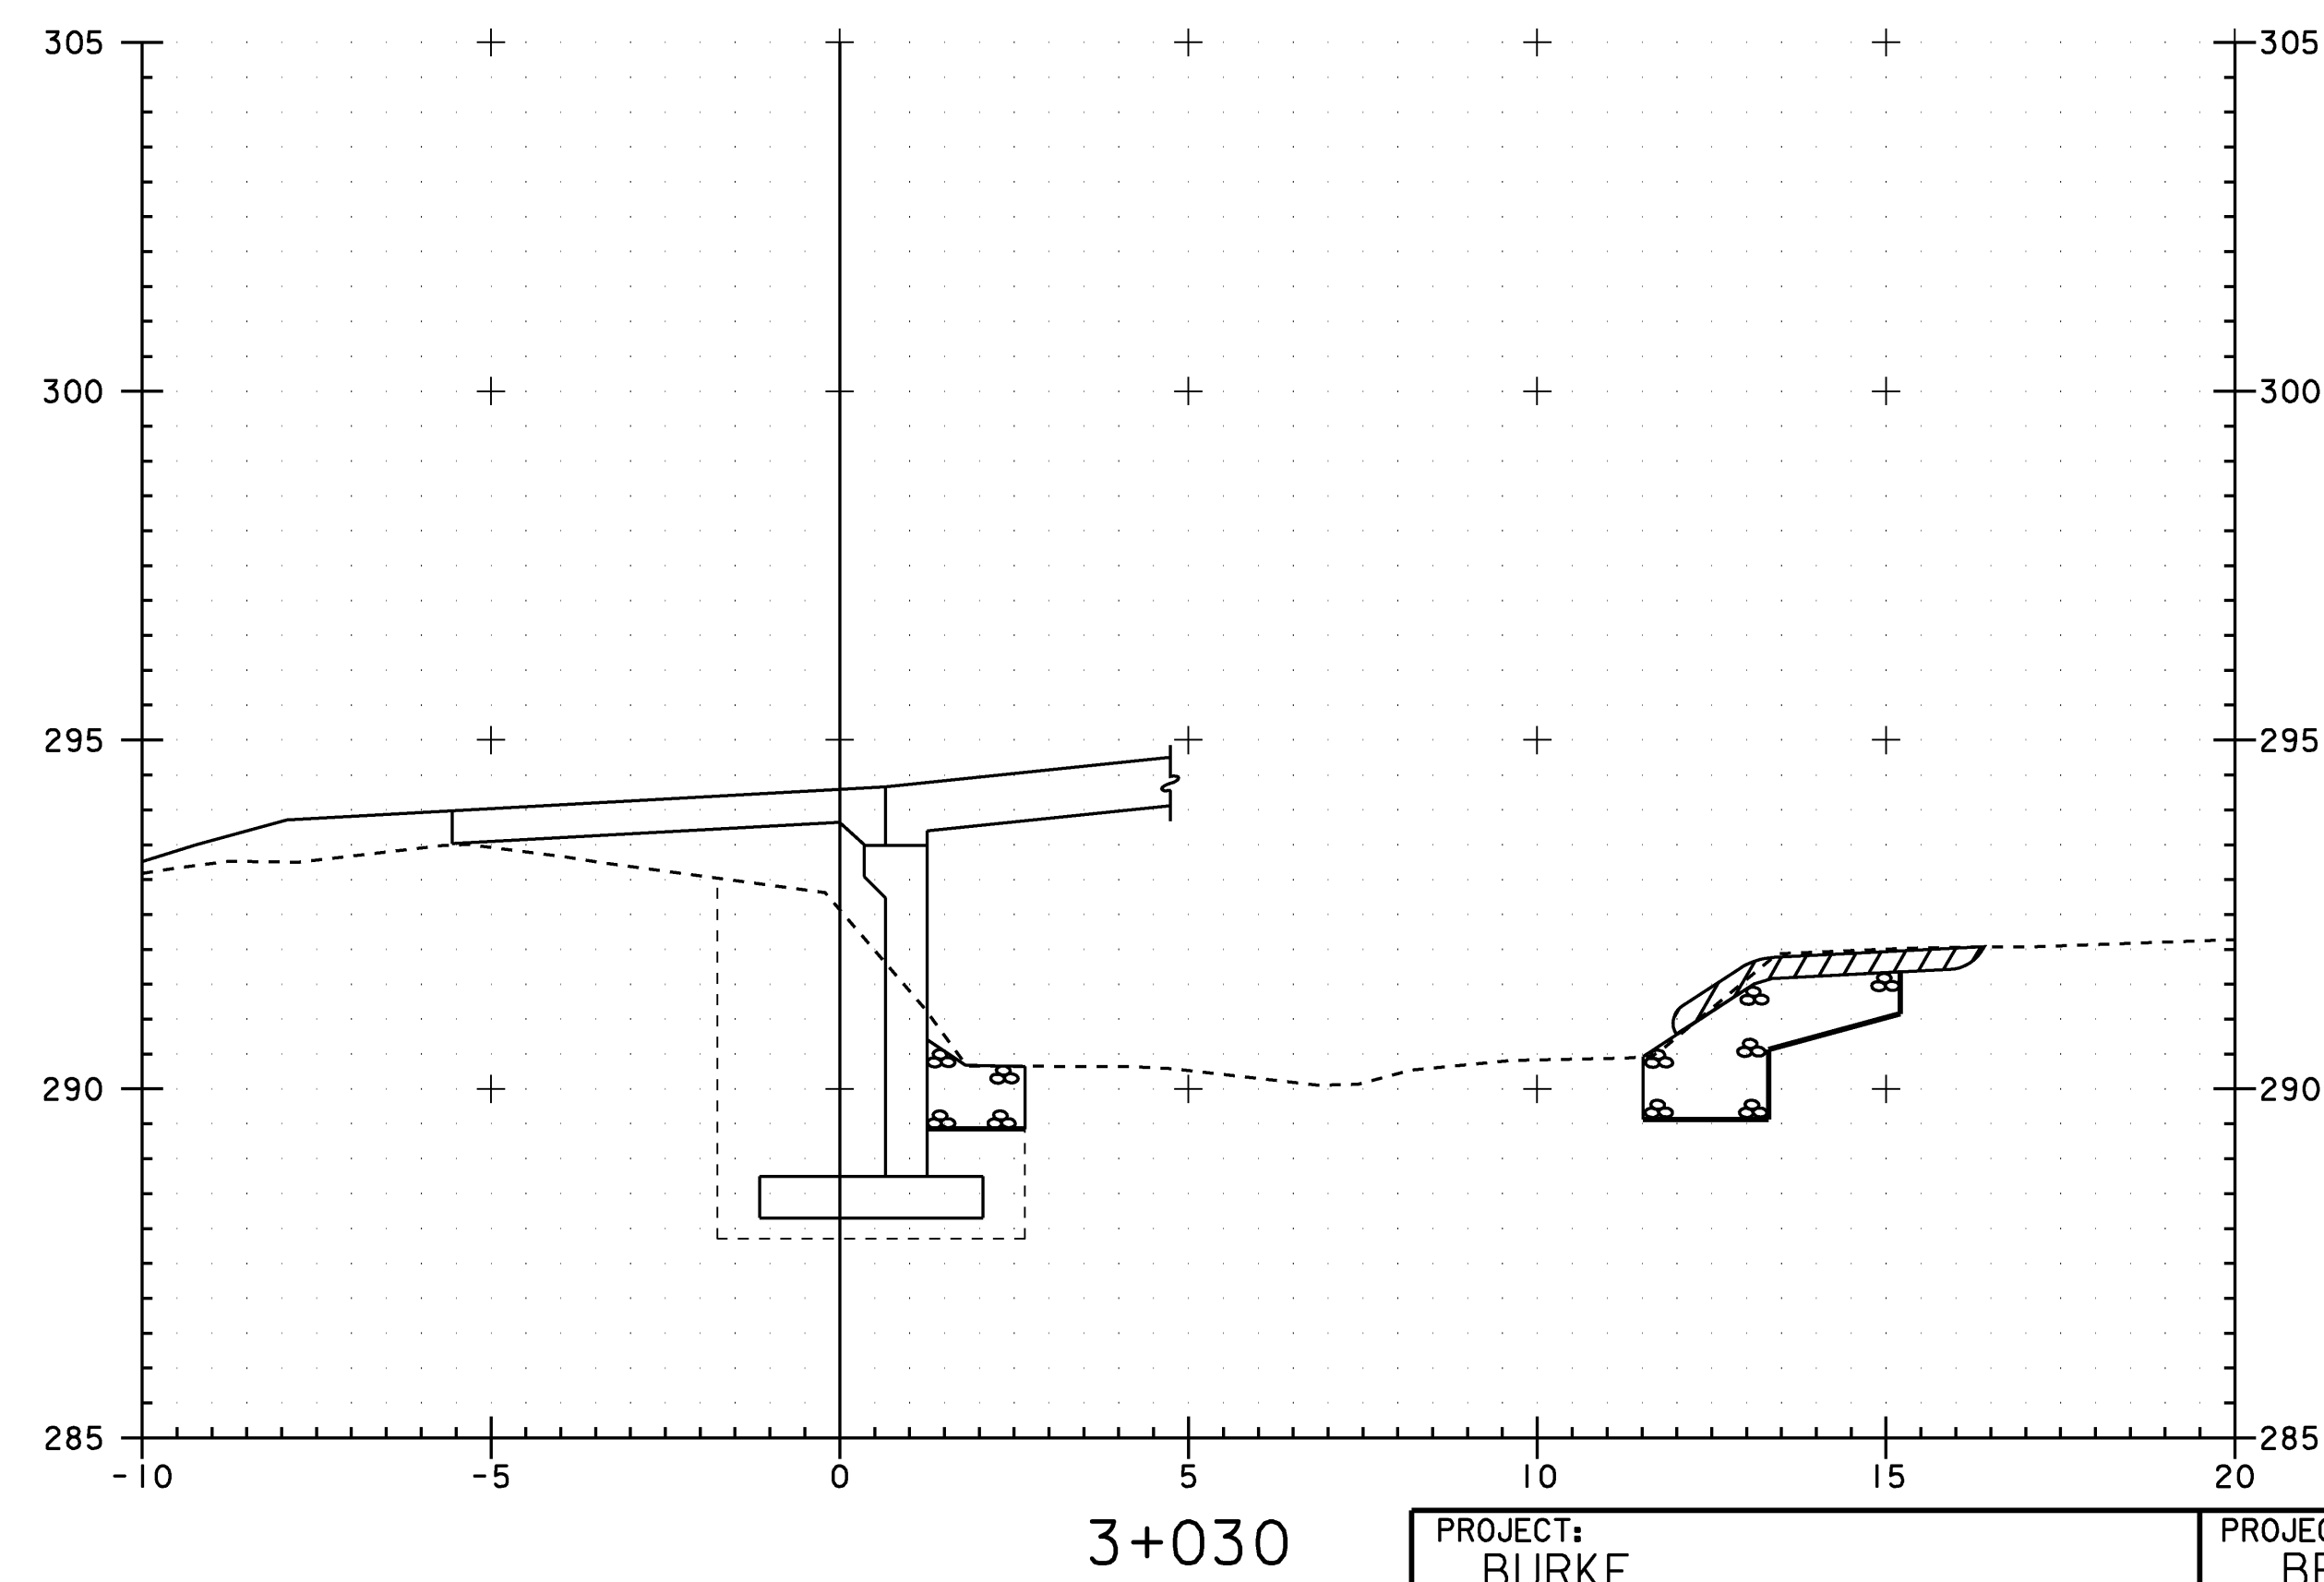
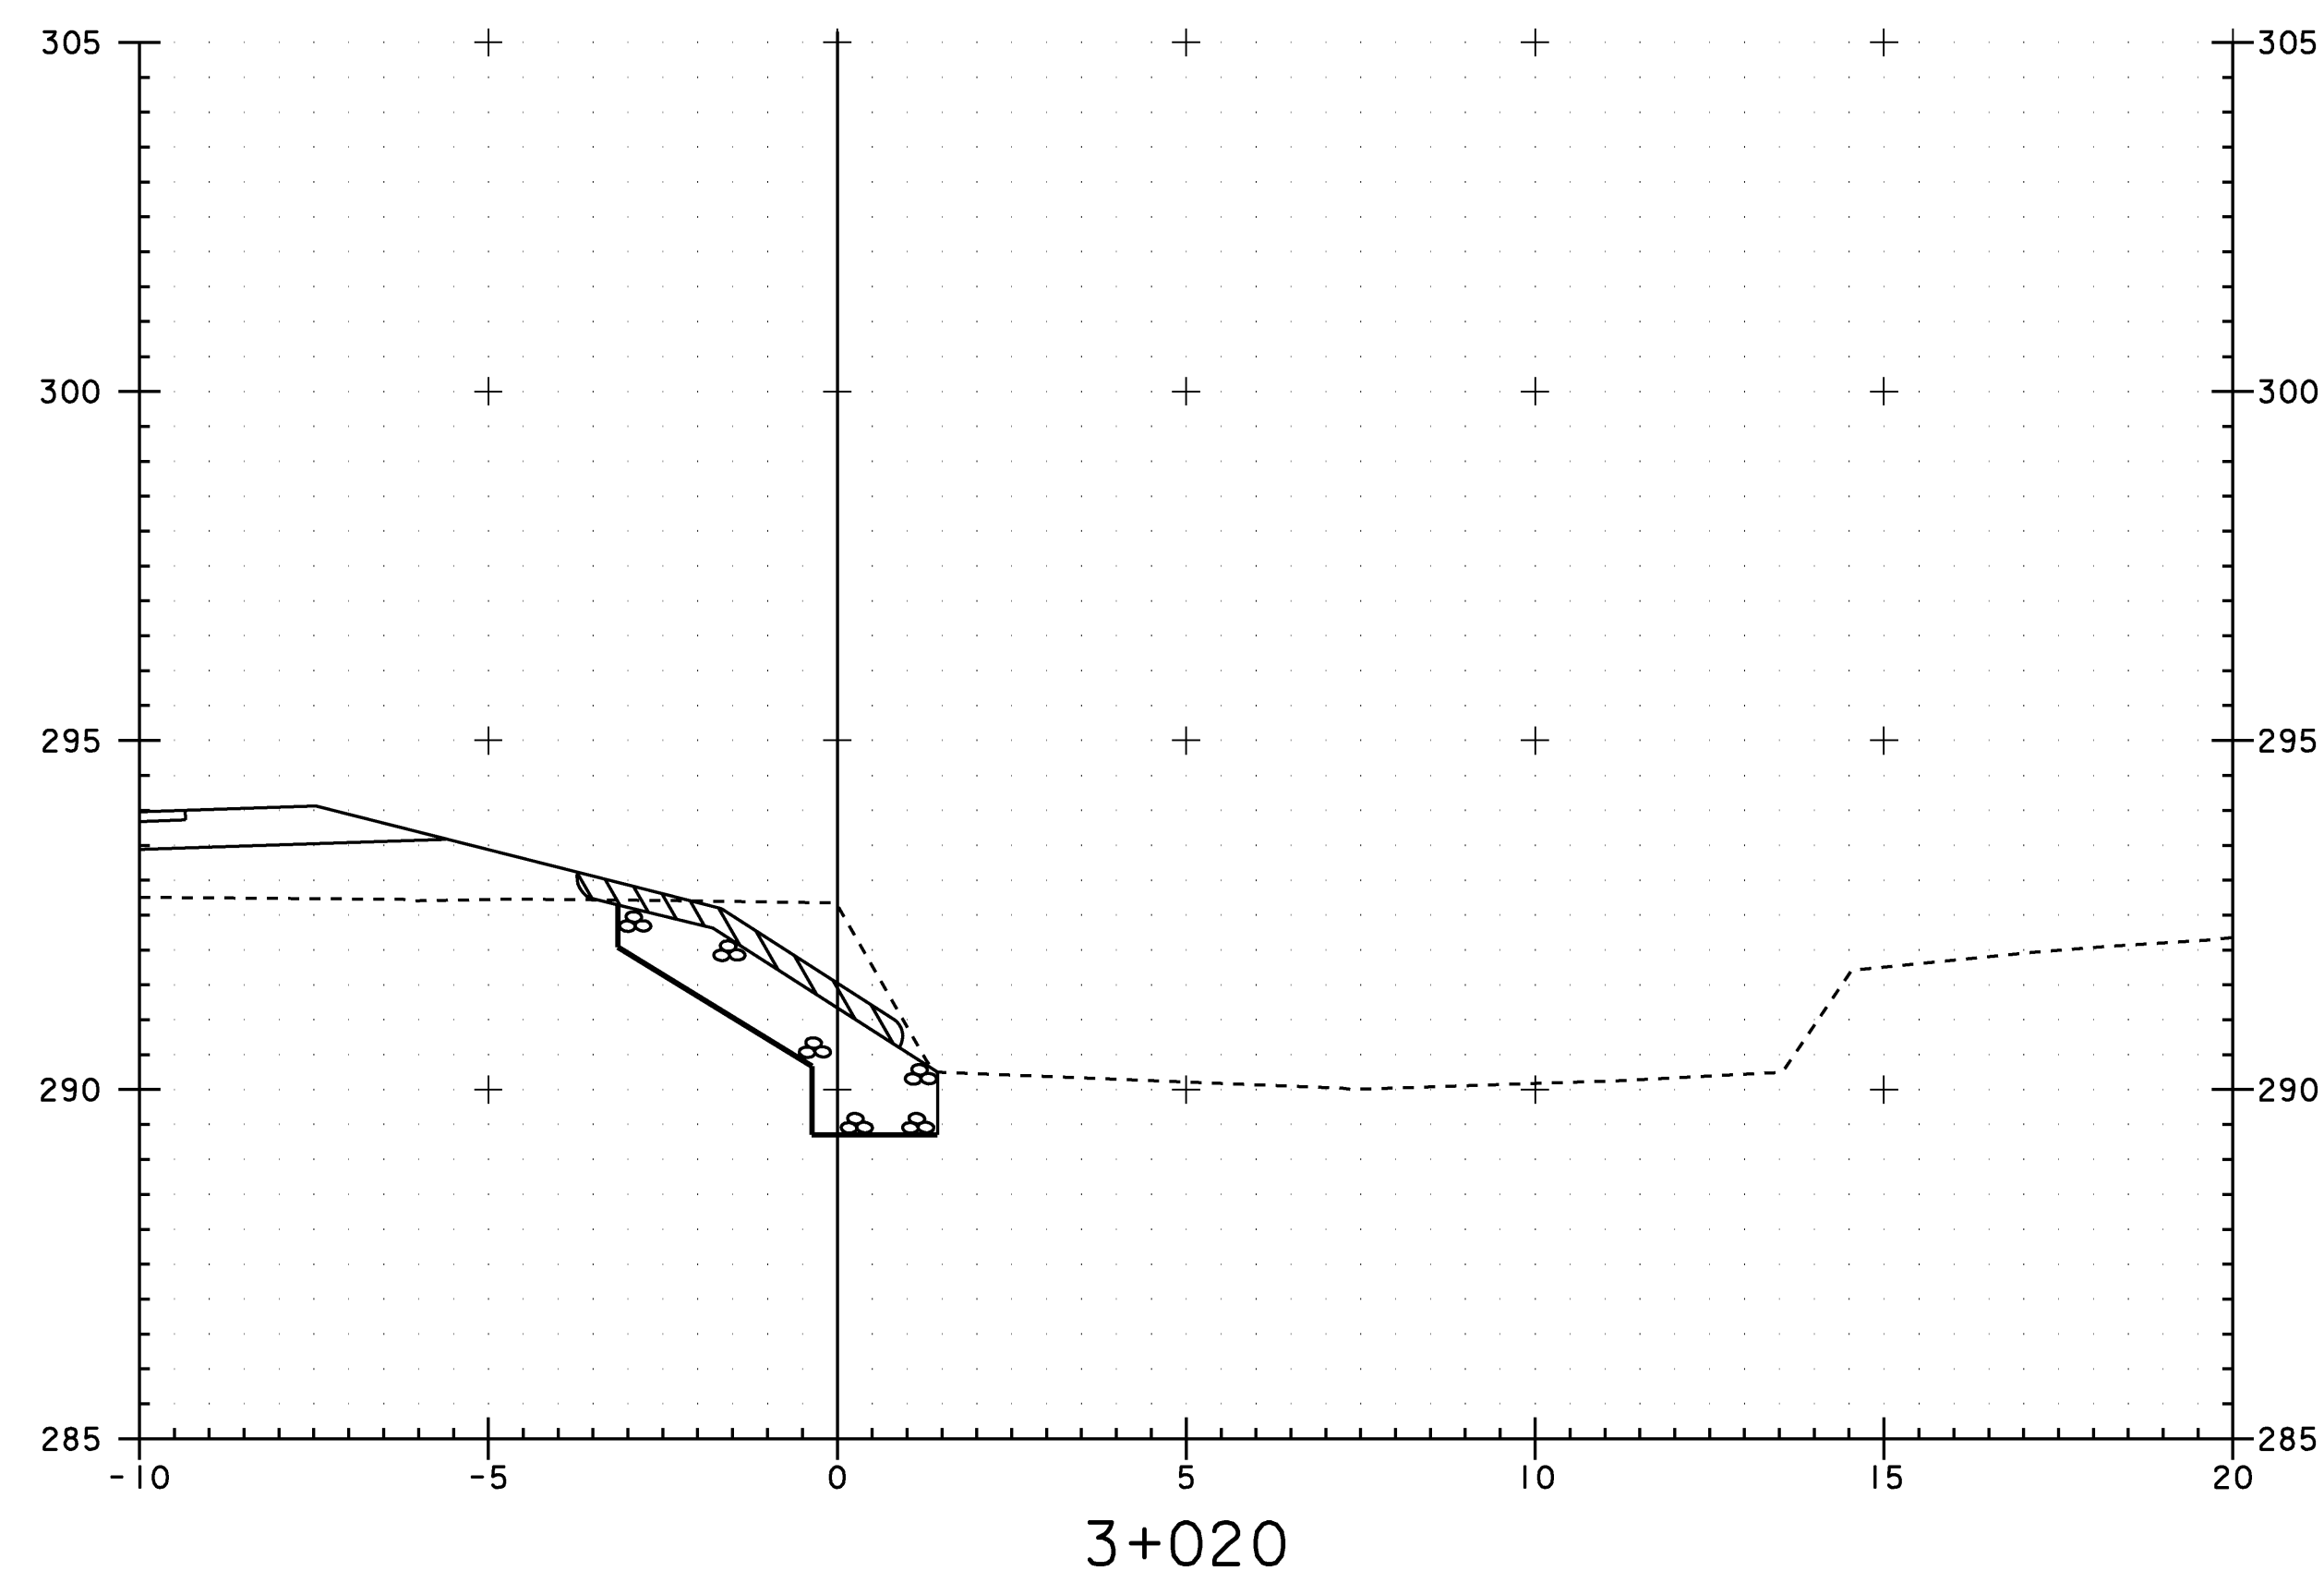
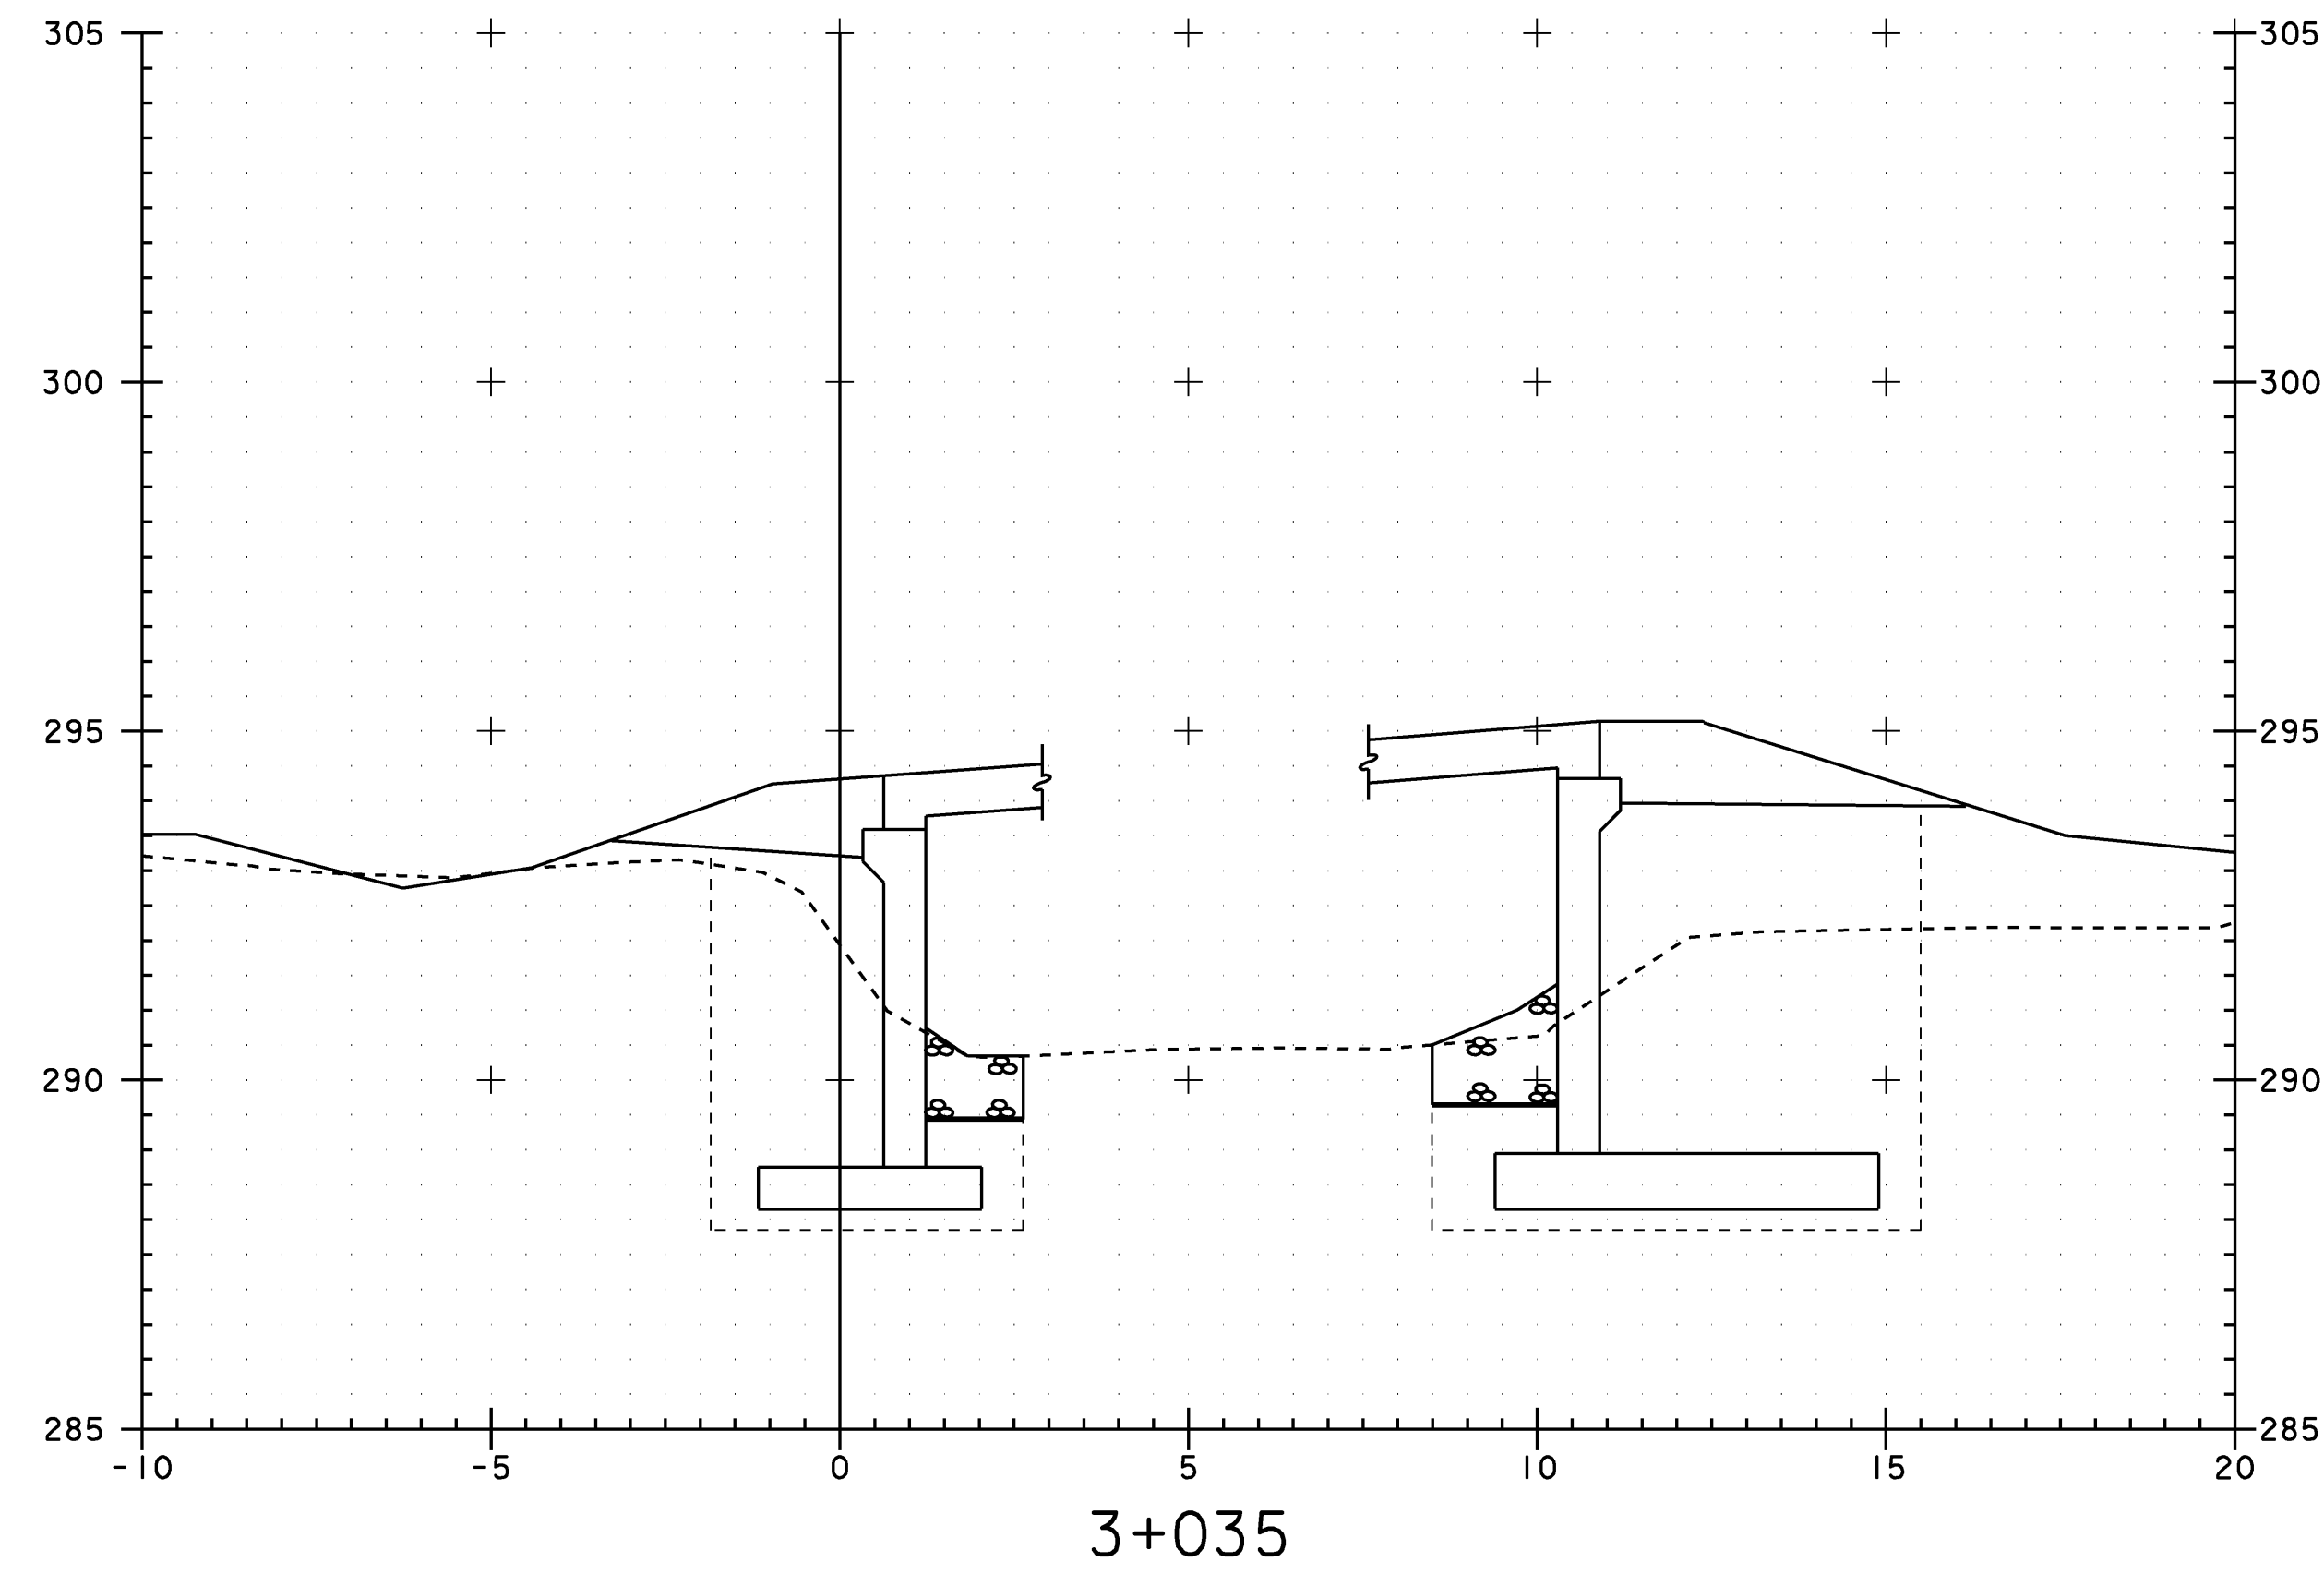


STA. 3+028 RIGHT (ABUTMENT 2)  
 BEGIN STONE FILL TYPE 111  
 BEGIN UNCLASSIFIED CHANNEL EXCAVATION  
 BEGIN GRUBBING MATERIAL  
 BEGIN GEOTEXTILE UNDER STONE FILL

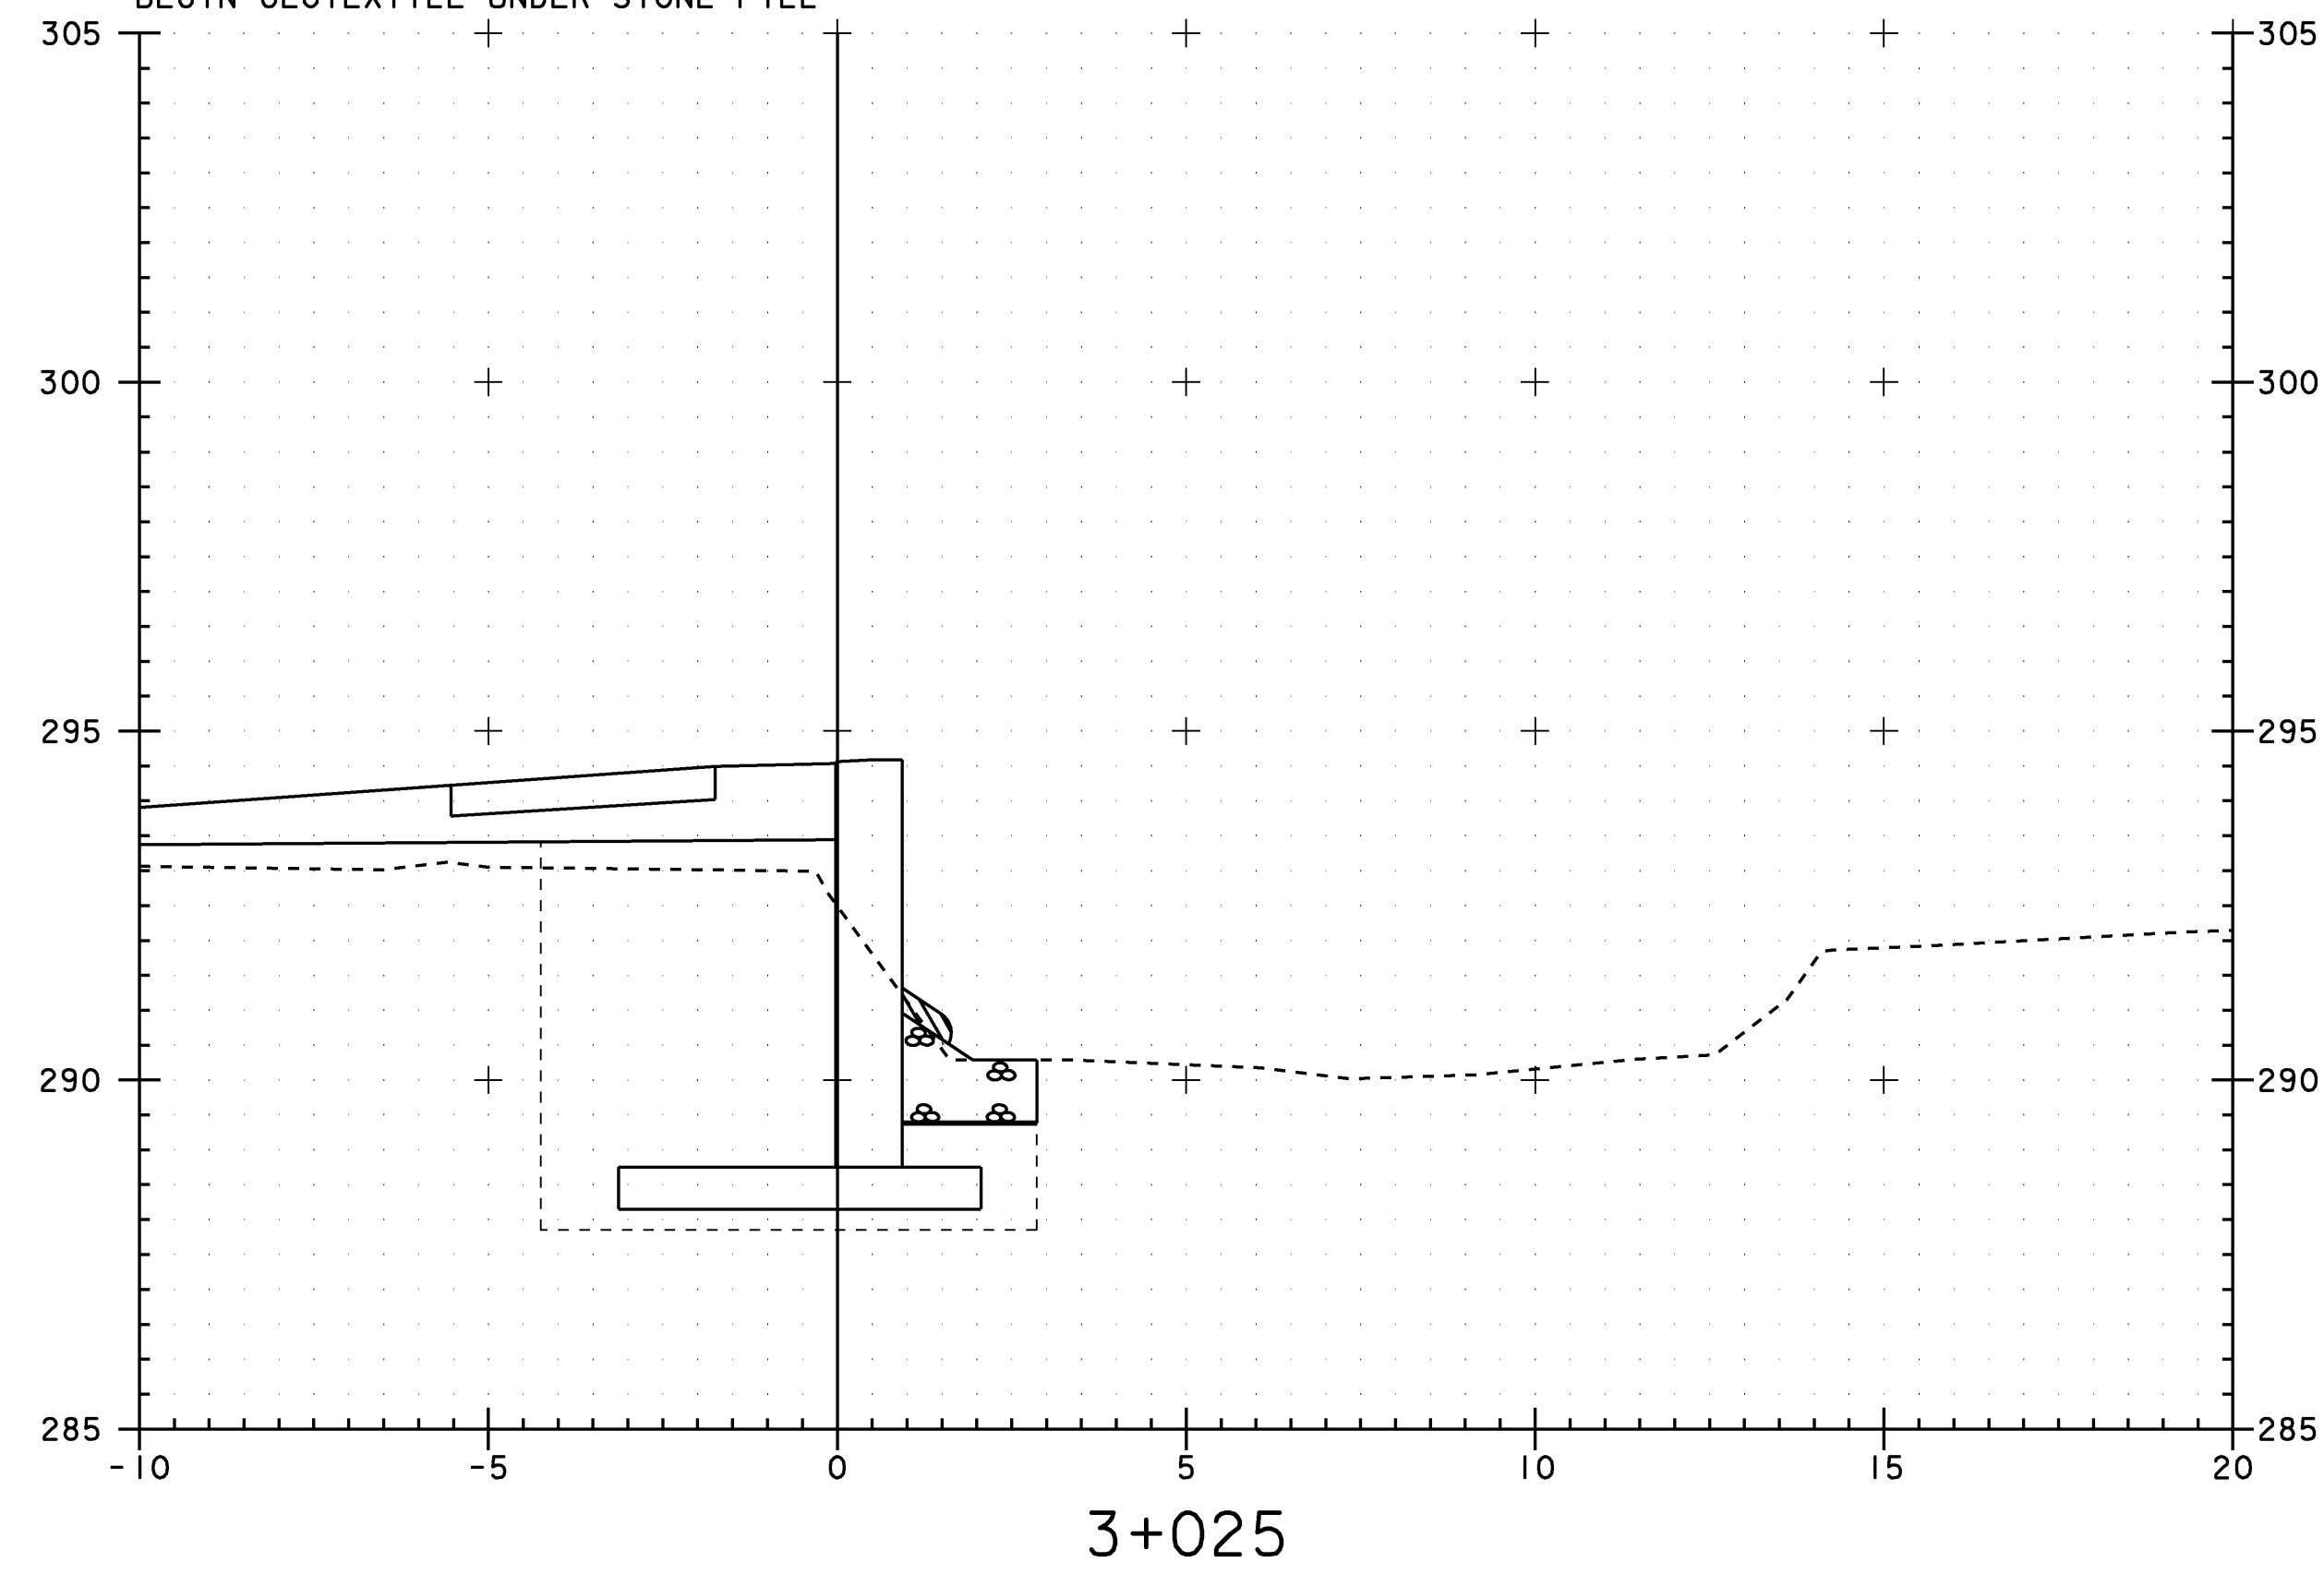

PROJECT: BURKE	PROJECT NO. : BRZ 1447 (15)
DESIGN FILE NAME: /str4/87e043/se043xsl.dgn	PLOT DATE: 14-MAR-2008
IPARM FILE NAME: /str4/87e043/se043ch2.i	
BRIDGE #16 CHANNEL CROSS SECTIONS	
SECTION 3+020 THROUGH 3+035	
SHEET: 76 OF 81	