




**3+065**  
 STA. 3+060.300 RIGHT (ABUTMENT 2)  
 END STONE FILL TYPE III  
 END UNCLASSIFIED CHANNEL EXCAVATION  
 END GRUBBING MATERIAL  
 END GEOTEXTILE UNDER STONE FILL

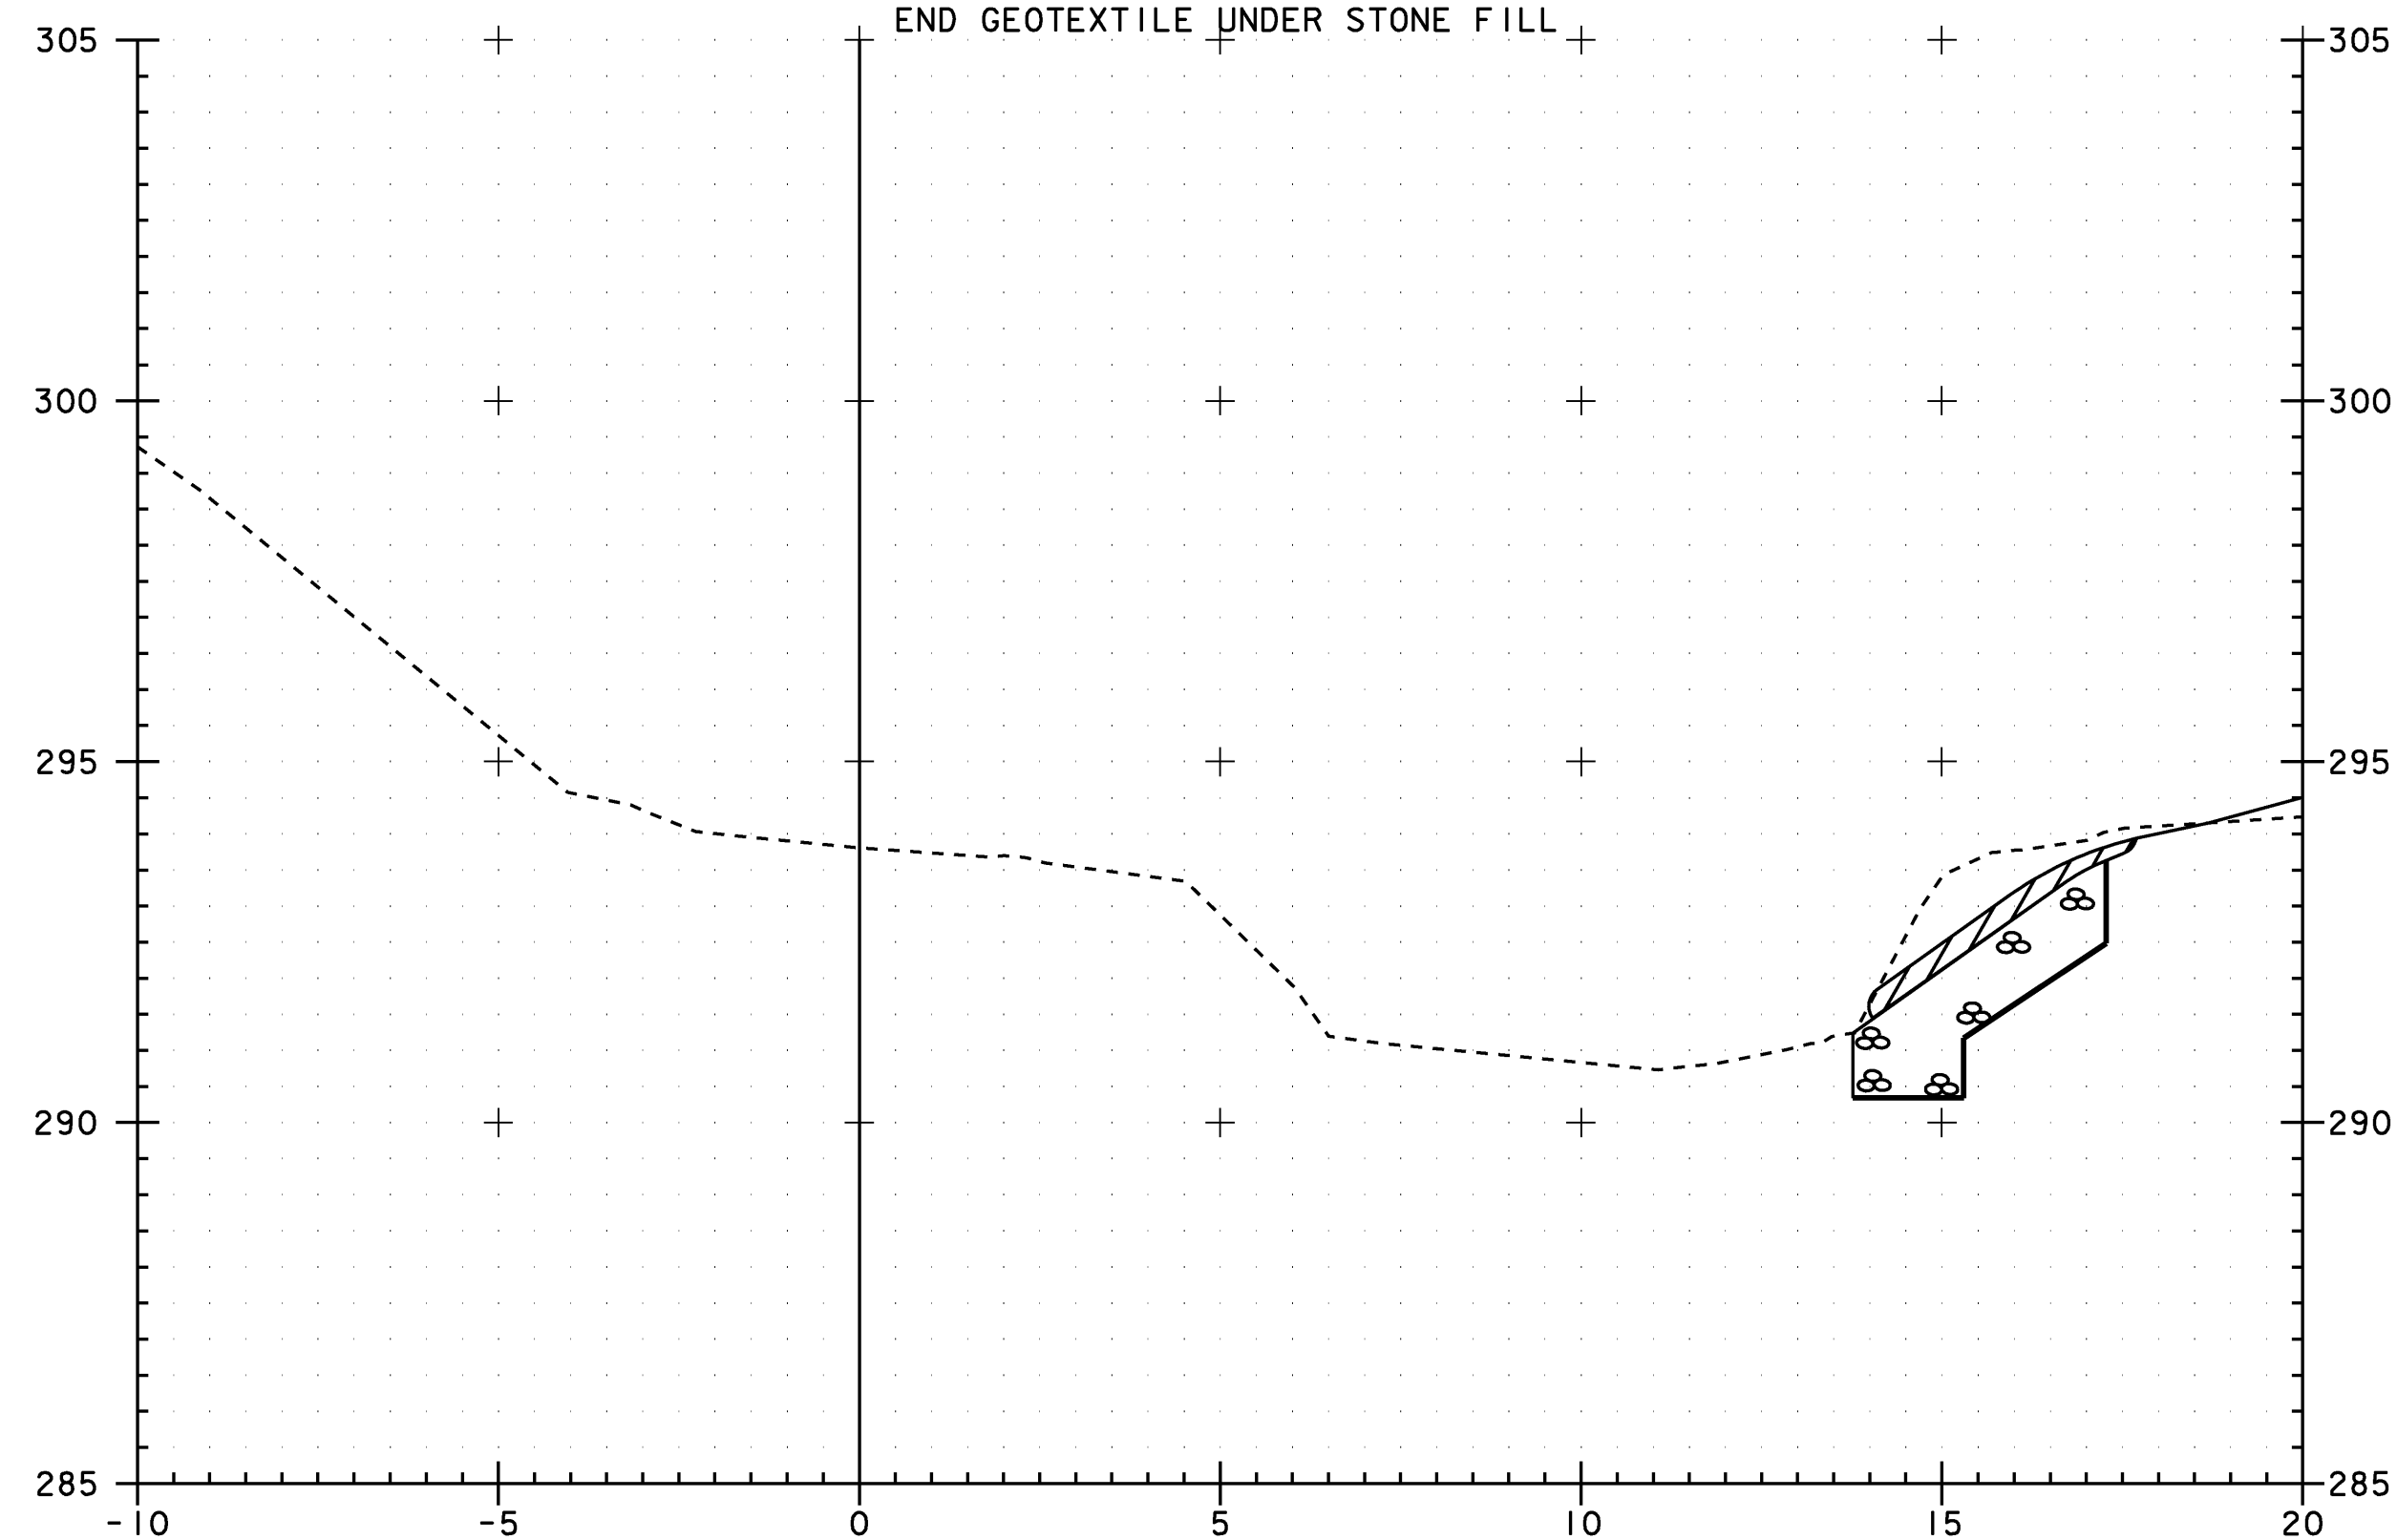

**3+060**

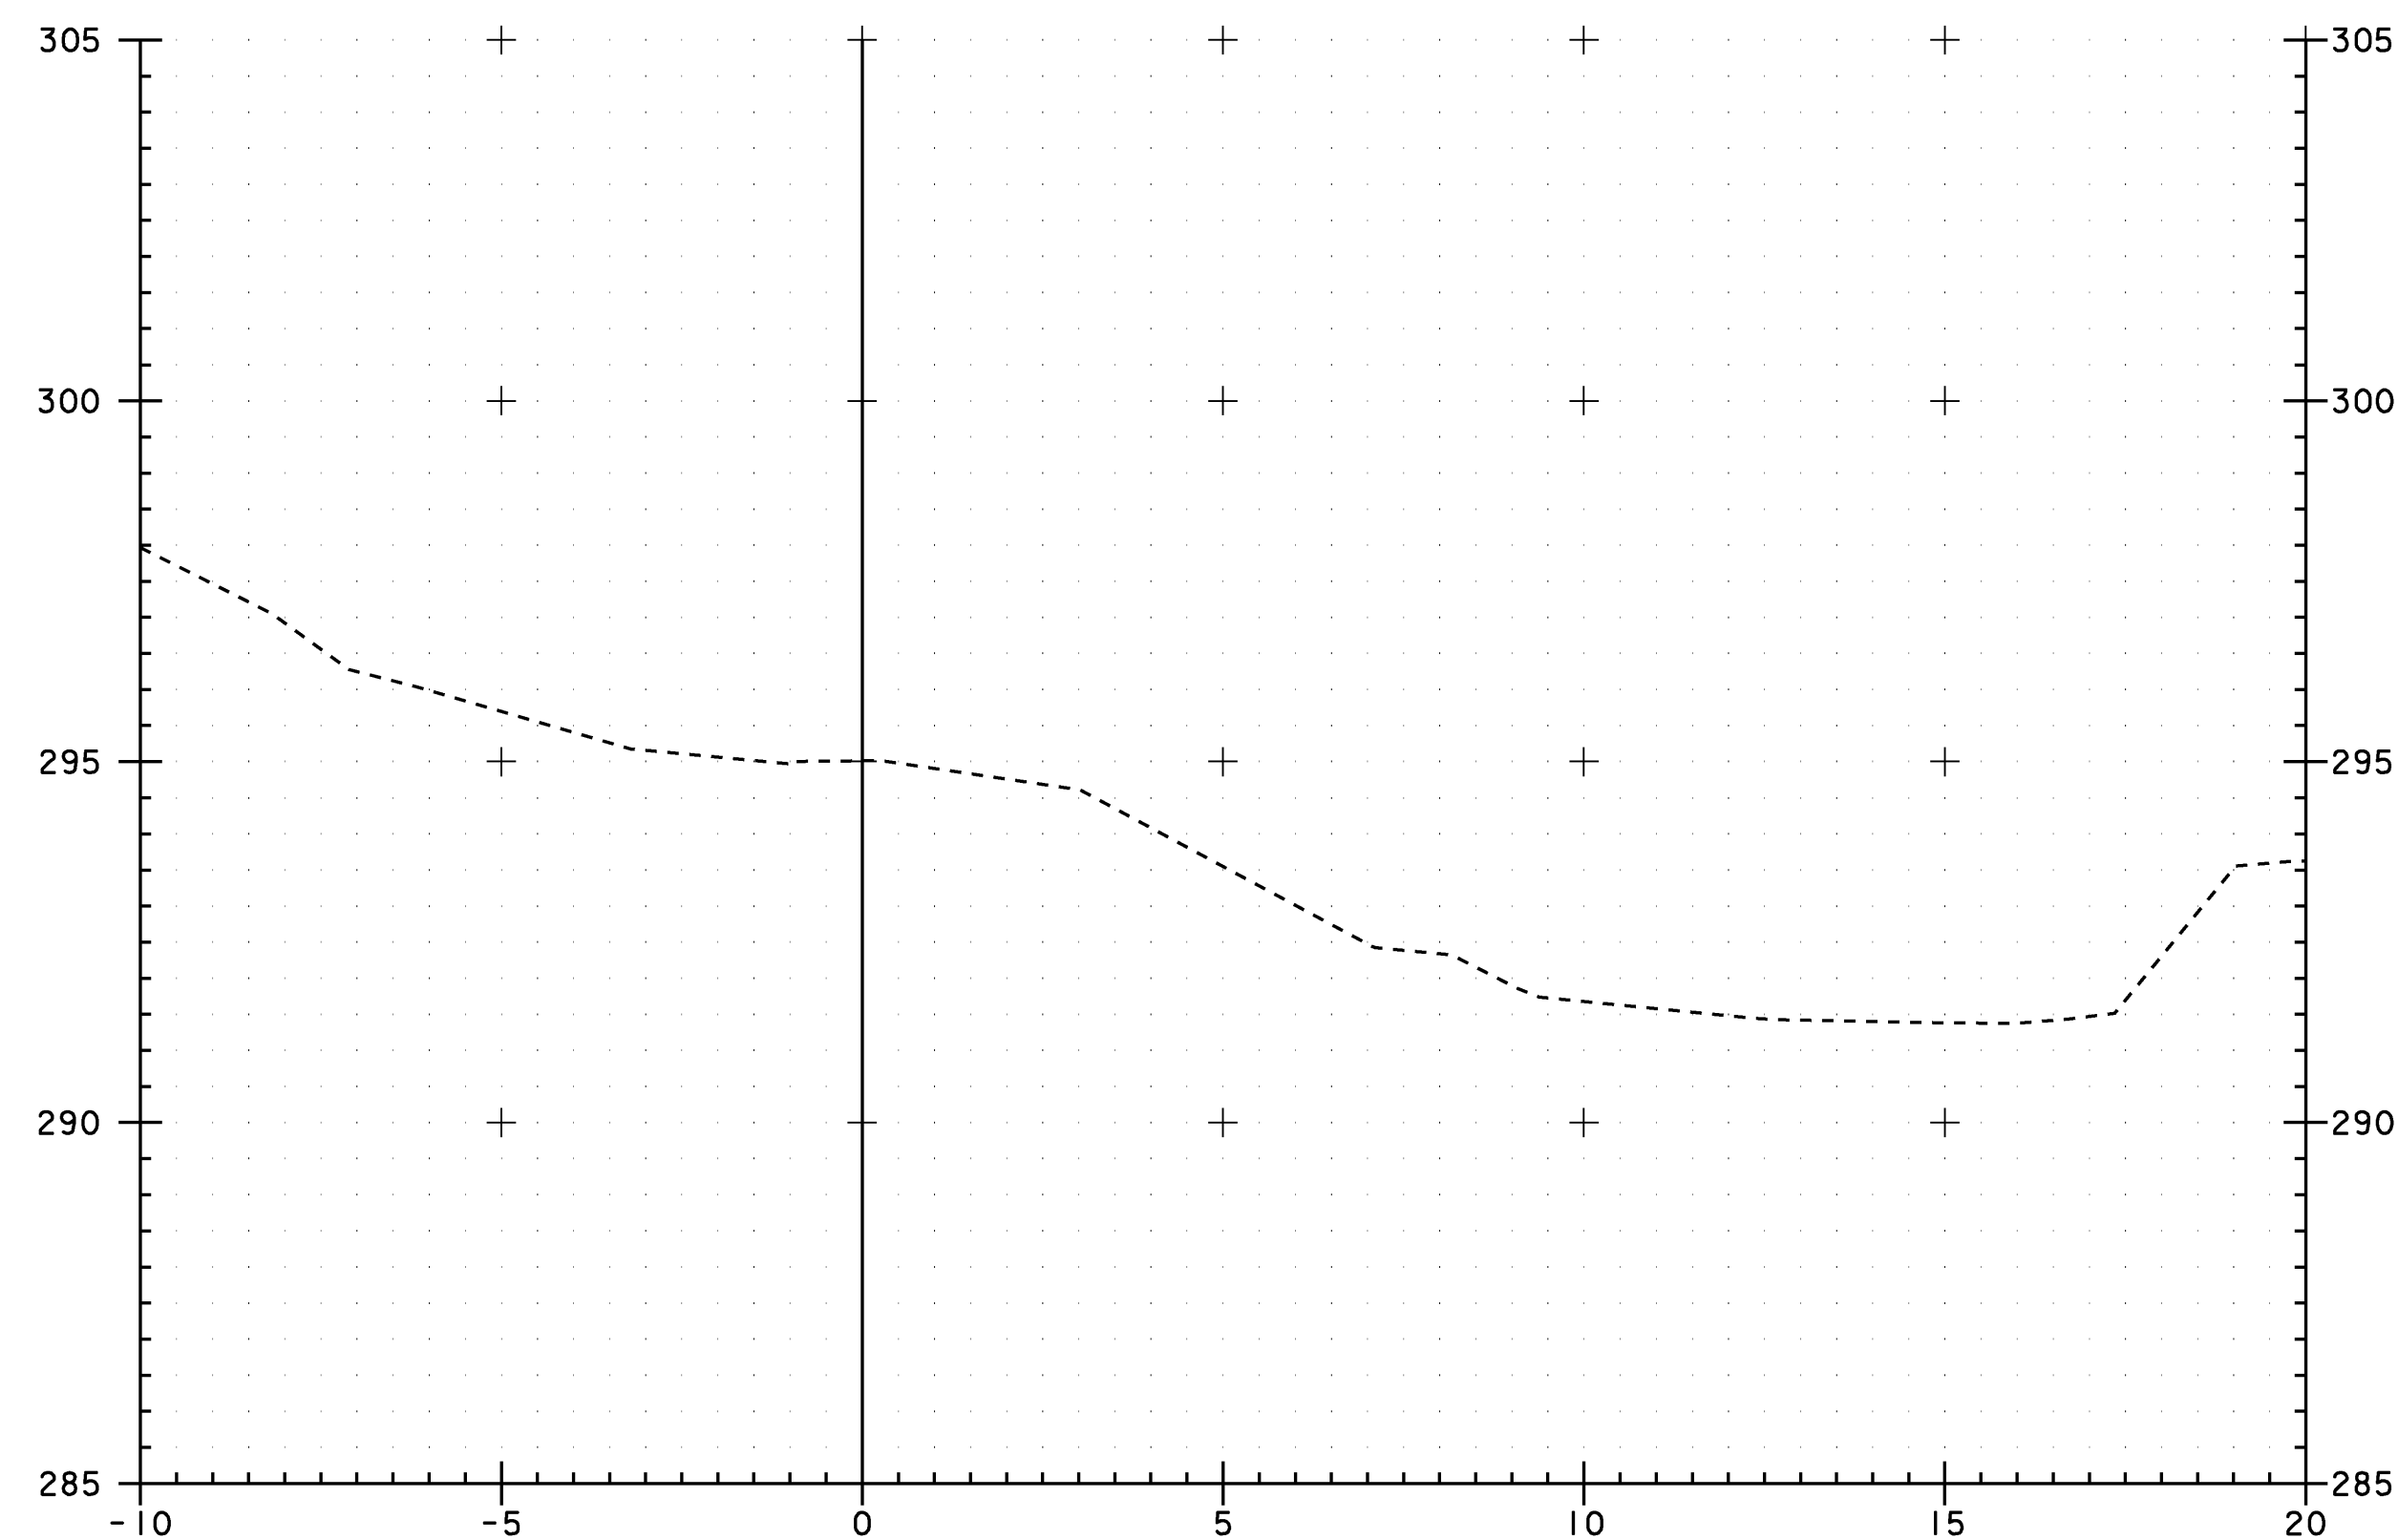

**3+070**

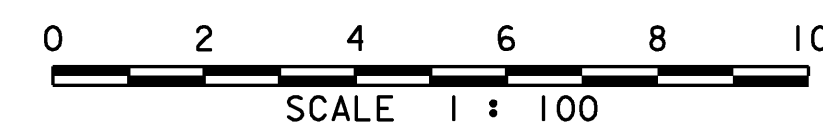

PROJECT: BURKE	PROJECT NO. : BRZ 1447 (15)
DESIGN FILE NAME: /str4/87e043/se043xsl.dgn	PLOT DATE: 14-MAR-2008
IPARM FILE NAME: /str4/87e043/se043ch4.t	
BRIDGE #16 CHANNEL CROSS SECTIONS	
SECTION 3+060 THROUGH 3+070	
SHEET: 78 OF 81	