



Date 4/3/2009

Username Eric Calderwood

Filename \\76_br_08_BURKE_G2.dwg Workgroup Structures Division

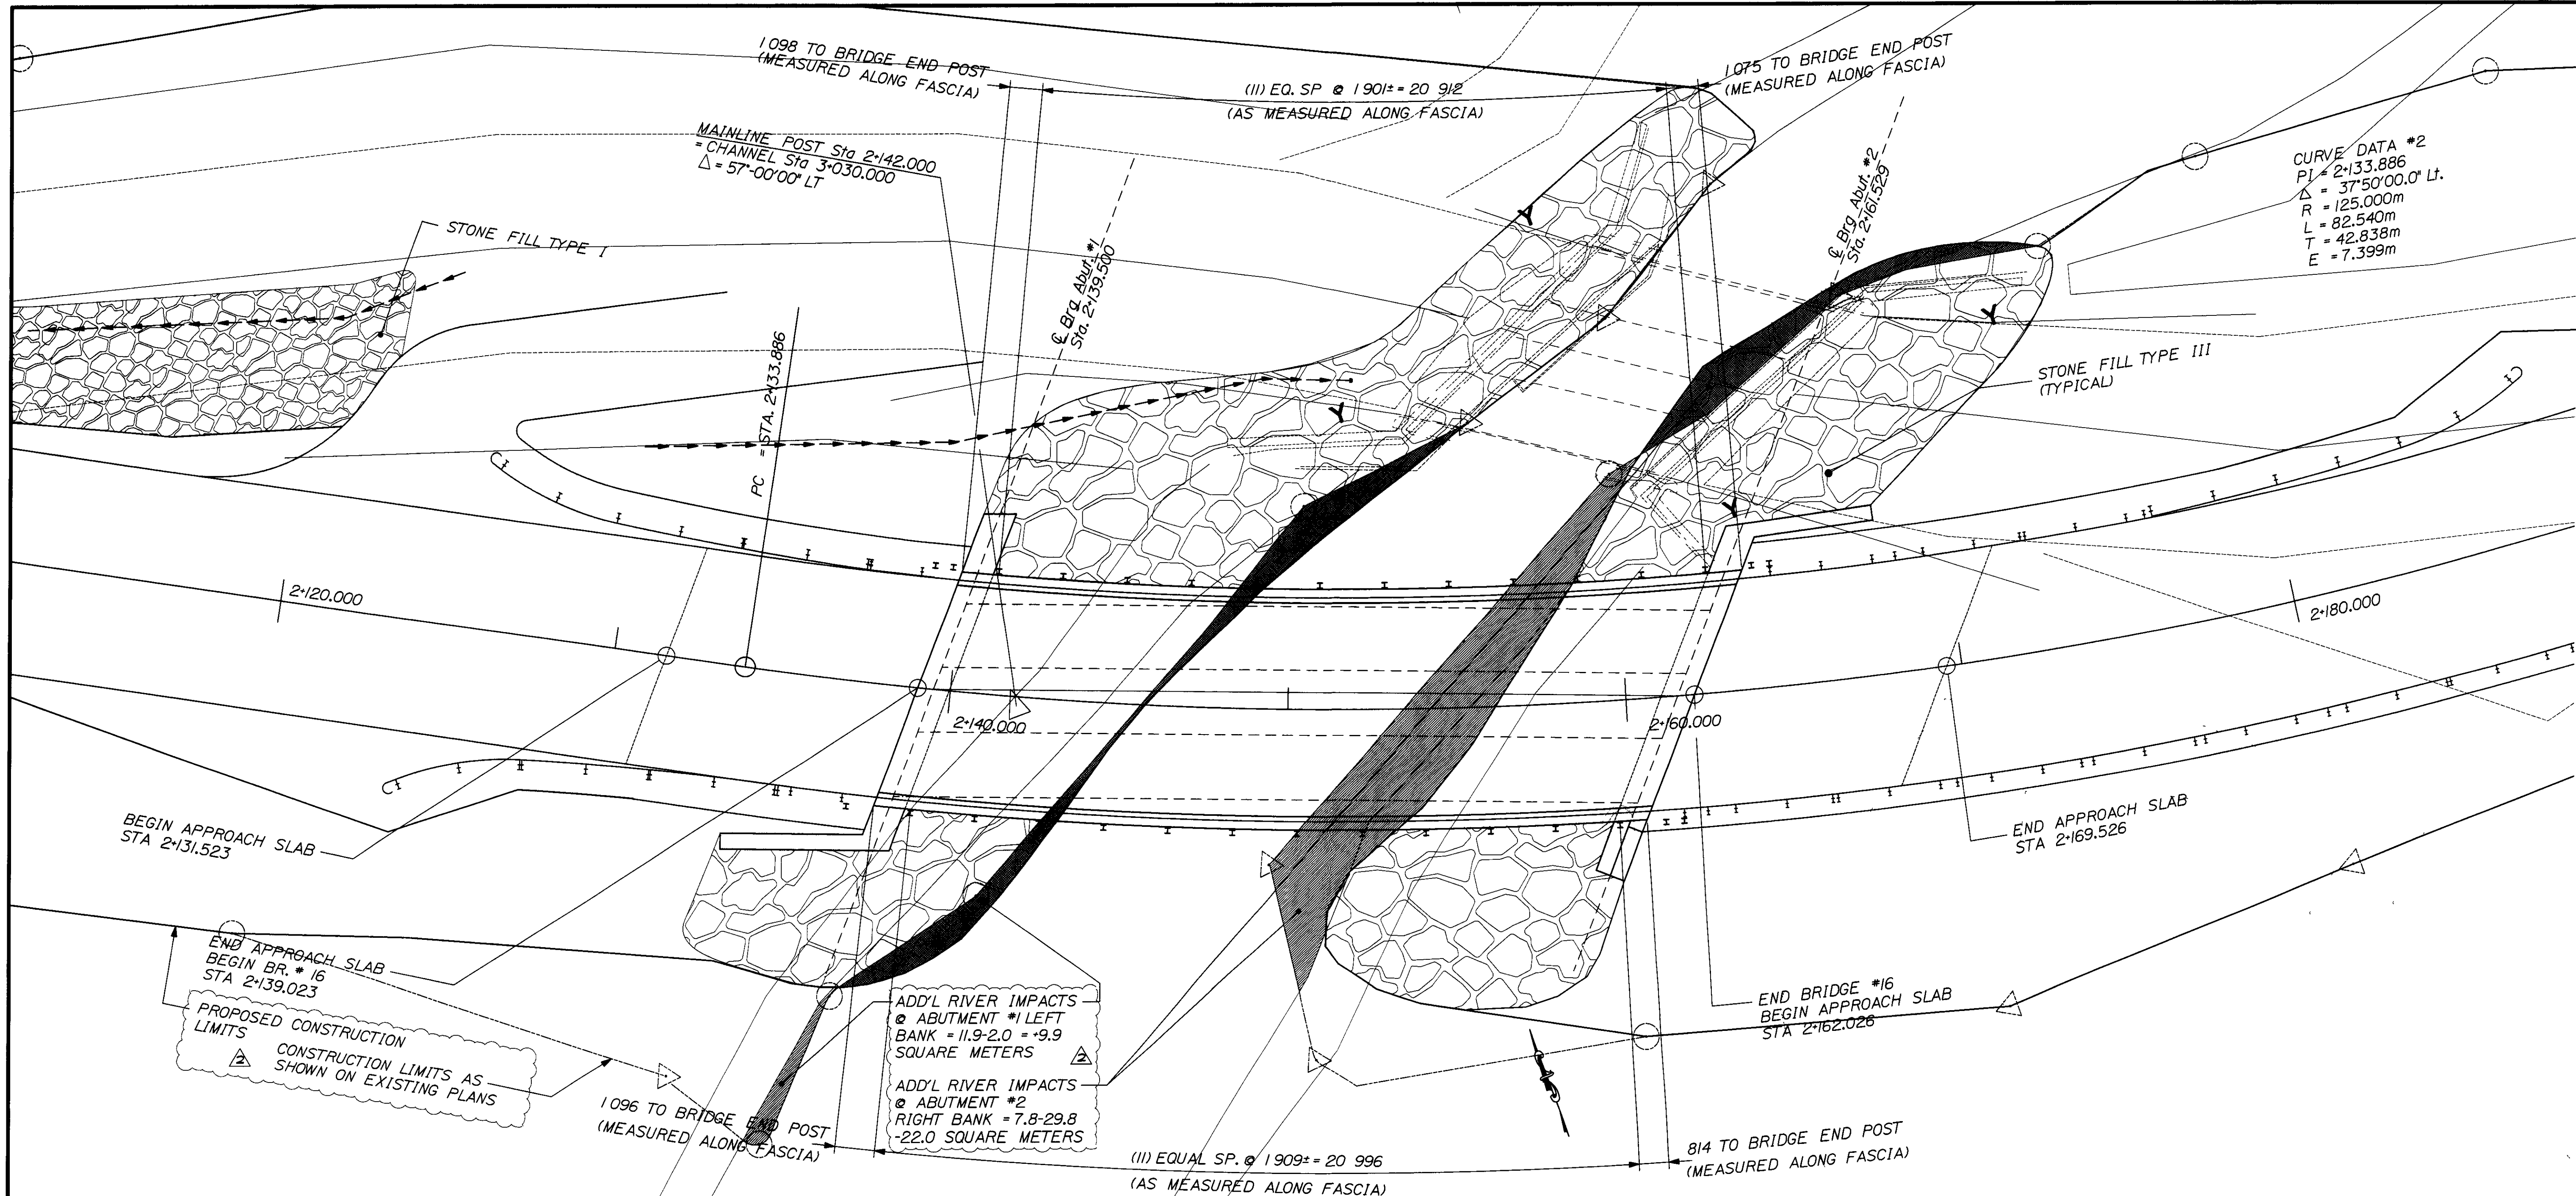


GENERAL BRIDGE PLAN & ALIGNMENT
ROADWAY CROSS SECTIONS & PROFILE ARE AS PER CONTRACT DETAILS

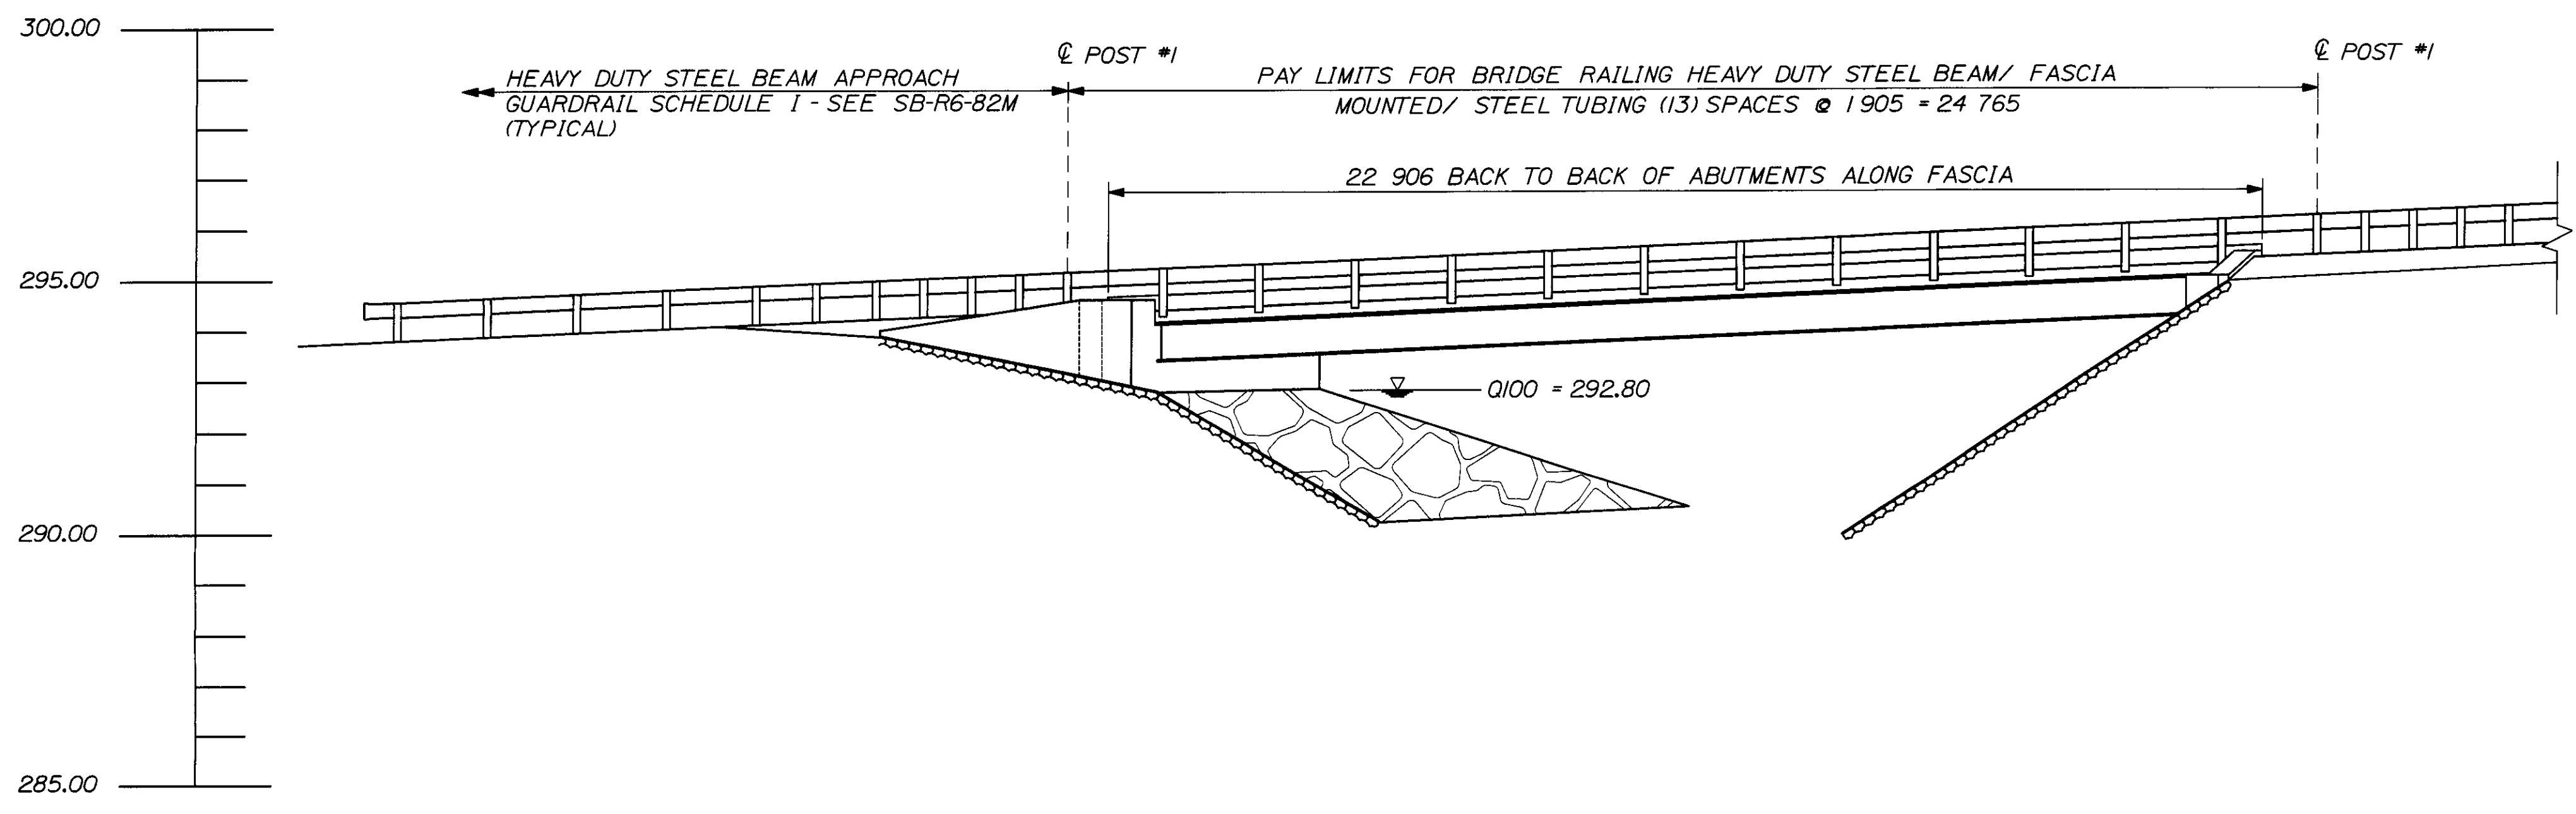

CALDERWOOD ENGINEERING, ETC.
STRUCTURAL ENGINEERING • DETAILING SERVICES
222 RIVER ROAD, RICHMOND, NE 06887 PH/FX (207) 737-4801

PREPARED FOR AUSTIN CONST., INC
BURKE - VALUE ENGINEERING
PROJ. BRZ 1447 (16)

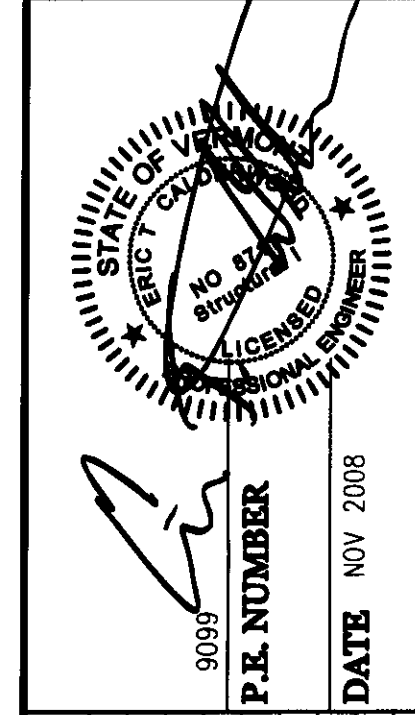

DATE	BY	DESIGN-DETAILED	NO REVISIONS THIS SHEET
NOV 08	ETC		
		CHECKED-REVIEWED	NO REVISIONS THIS SHEET
			NO CHANGES THIS SHEET
			NO CHANGES THIS SHEET
			NO CHANGES THIS SHEET
			FIELD CHANGES

BURKE
VALUE ENGINEERED DESIGN
BRIDGE #16 PLAN & ELEVATION

SHEET NUMBER
G2