


WORKING POINT COORDINATES (ABUTMENT #1)

	W.P. #1	W.P. #2	W.P. #3	W.P. #4
NORTHING	232266.781	232264.606	232262.814	232270.794
EASTING	545135.032	545127.511	545132.179	545139.119

ABUTMENT #1 PILE CUTOFF ELEVATIONS:
 PILE @ G1 - 291.610
 PILE @ G2 - 291.700
 PILE @ G3 - 291.795
 PILE @ G4 - 291.890

ABUTMENT #1 PLAN & ELEVATION

CALDERWOOD ENGINEERING, ETC.
 STRUCTURAL ENGINEERING • DETAILING SERVICES
 222 RIVER ROAD, RICHMOND, ME 04267 PH/FX (207)751-4801
 PREPARED FOR AUSTIN CONST., INC
 BURKE - VALUE ENGINEERING
 PROJ. BRZ-1447 (16)

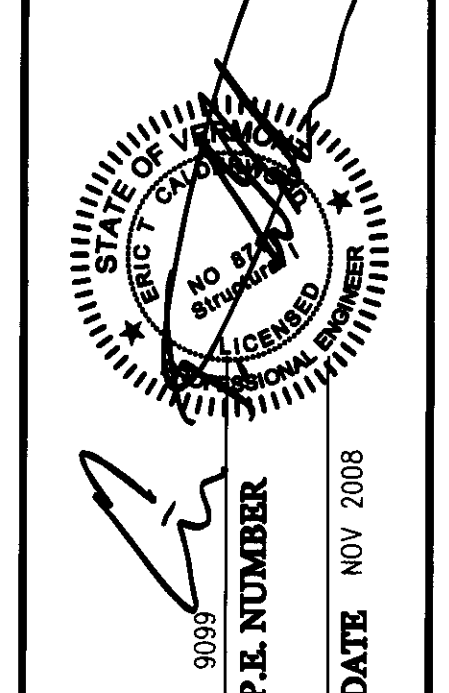

DATE	BY	DESIGN-DETAILED	CHECKED-REVIEWED	REVISIONS	FIELD CHANGES
NOV 08	ETC				
JAN 09				NO CHANGE THIS SHIT	
MAR 09				NO CHANGE THIS SHIT	
APR 09				NO CHANGE THIS SHIT	

BURKE
 VALUE ENGINEERED DESIGN
 ABUT. #1 DIMENSIONAL PLAN & ELEV.

SHEET NUMBER
 A1