


ABUTMENT #2 PLAN & ELEVATION

CALDERWOOD ENGINEERING, ETC.  
 STRUCTURAL ENGINEERING • DETAILING SERVICES  
 222 RIVER ROAD, RICHMOND, ME 04867 PH/FX (207)787-4801  
 PREPARED FOR AUSTIN CONST., INC  
 BURKE - VALUE ENGINEERING  
 PROJ. BRZ-1447 (16)

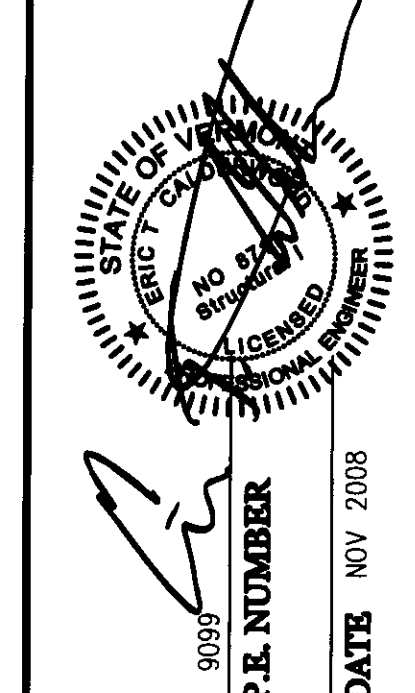

DATE	BY	DESIGN-DETAILED	CHECKED-REVIEWED	REVISIONS 1	REVISIONS 2	REVISIONS 3	FIELD CHANGES
NOV 08	ETC			NO CHANGE THIS SHIT	NO CHANGE THIS SHIT	NO CHANGE THIS SHIT	

**BURKE**  
 VALUE ENGINEERED DESIGN  
 ABUT. #2 DIMENSIONAL PLAN & ELEV.

SHEET NUMBER  
**A2**