


CALDERWOOD ENGINEERING, ETC.  
 STRUCTURAL ENGINEERING • DETAILING SERVICES  
 222 RIVER ROAD, RICHMOND, NE 06897 PH#4 (207)737-4801  
 PREPARED FOR AUSTIN CONST., INC  
 BURKE - VALUE ENGINEERING  
 PROJ. BRZ 1447 (16)

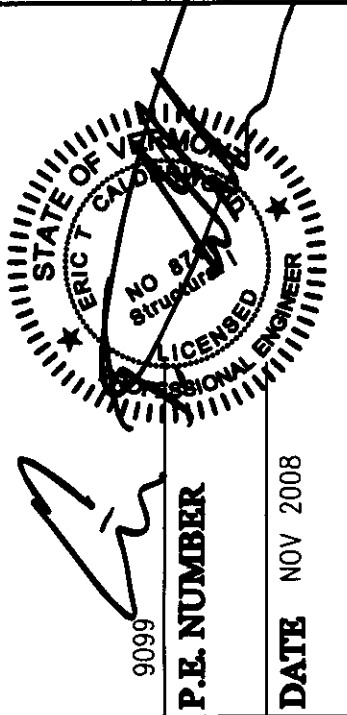

| DESIGN-DETAILED  | BY  | DATE   | REVISIONS                  |
|------------------|-----|--------|----------------------------|
| CHECKED-REVIEWED | ETC | NOV 08 | NO CHANGE THIS SHIT JAN 09 |
|                  |     |        | NO CHANGE THIS SHIT MAR 09 |
|                  |     |        | NO CHANGE THIS SHIT APR 09 |
|                  |     |        | NO CHANGE THIS SHIT        |
|                  |     |        | FIELD CHANGES              |

**BURKE**  
 VALUE ENGINEERED DESIGN  
 ABUT. #1 REINFORCING PLAN & ELEV.

SHEET NUMBER  
**A3**