



ABUTMENT DIMENSIONAL SECTION

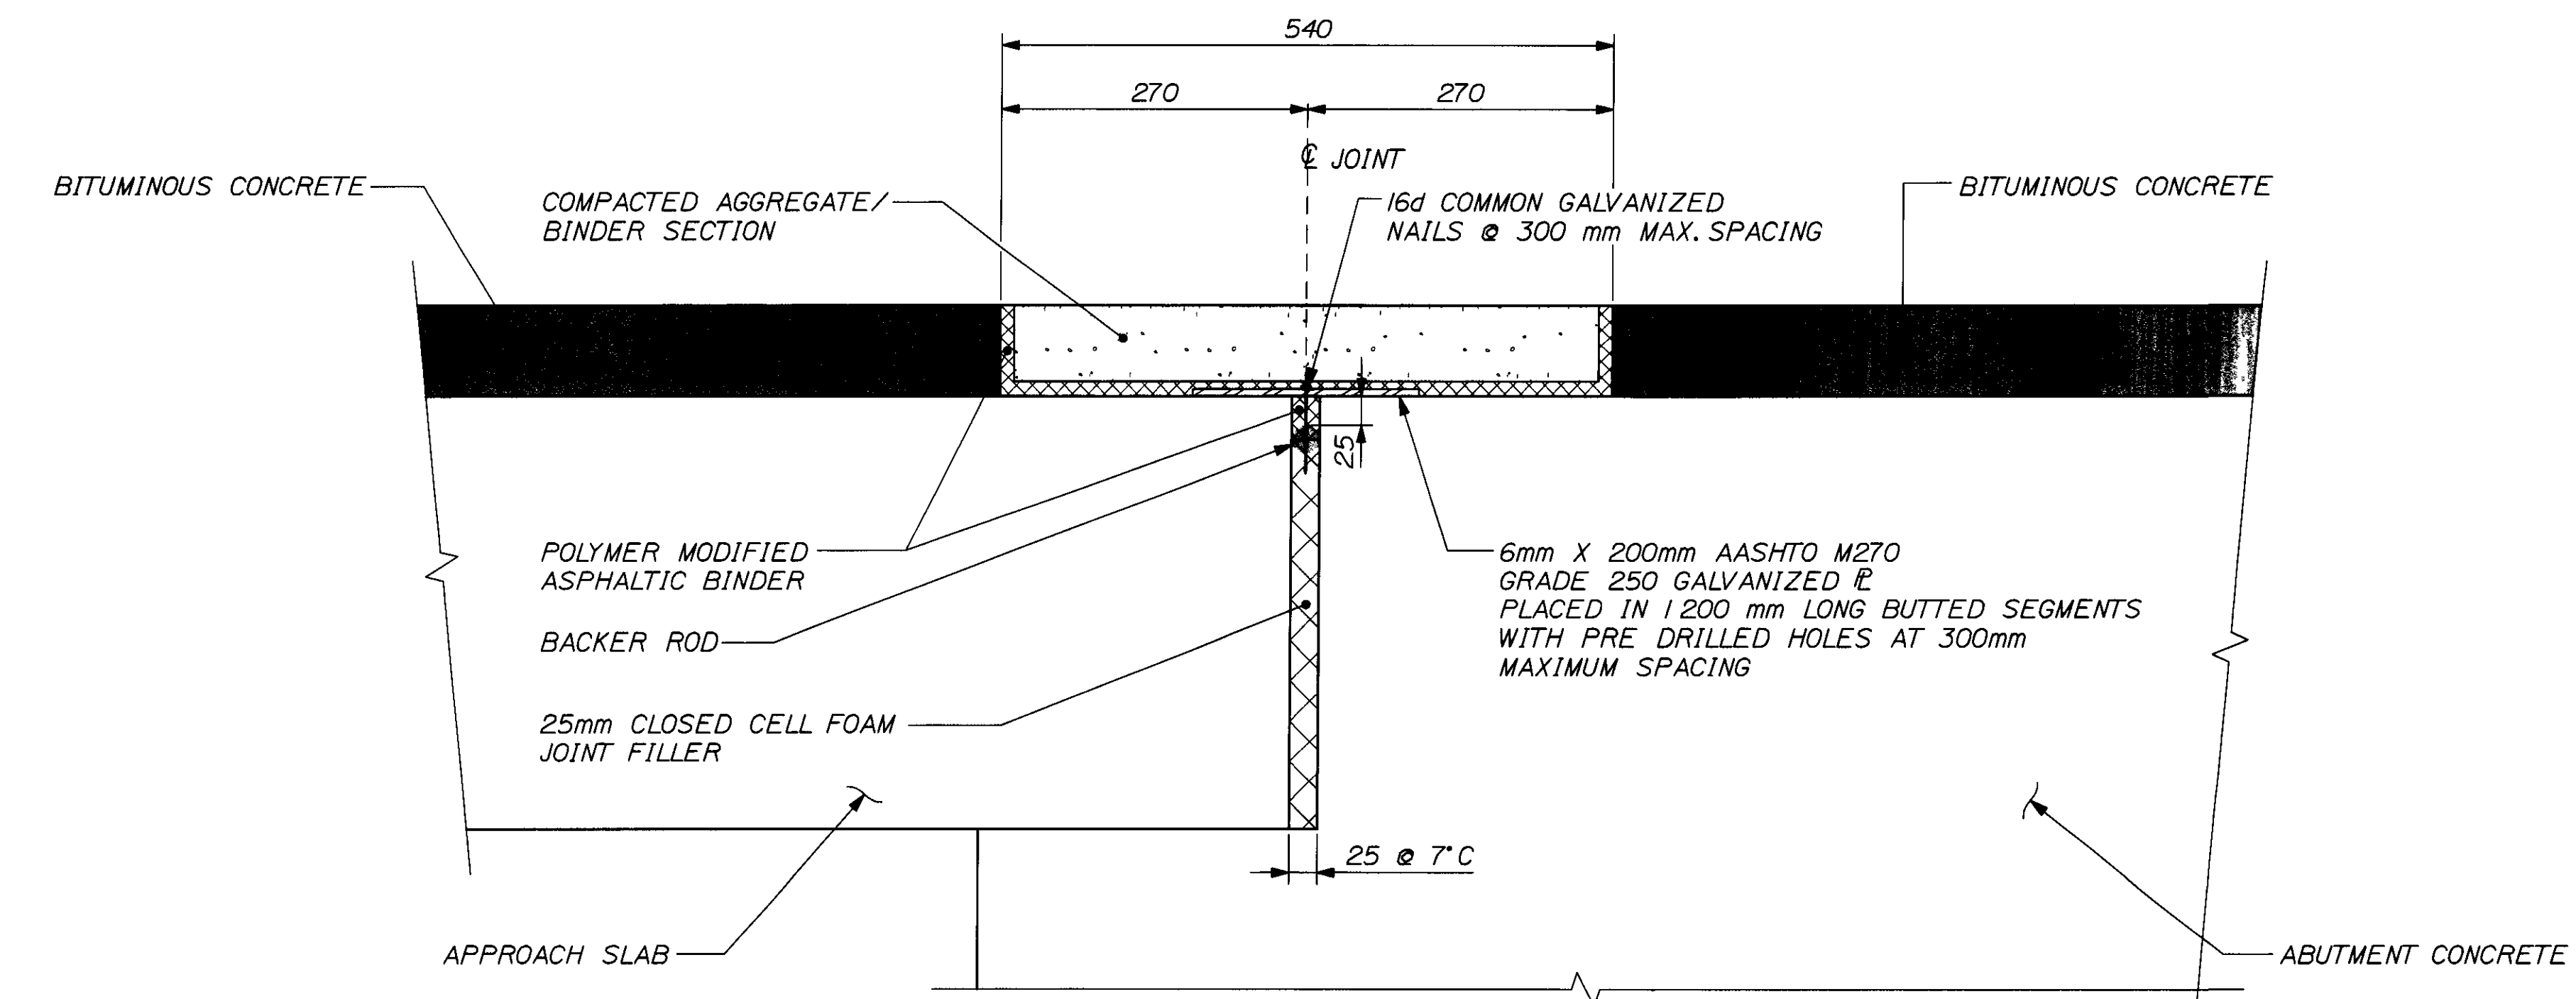


ASPHALTIC BRIDGE JOINT DETAIL

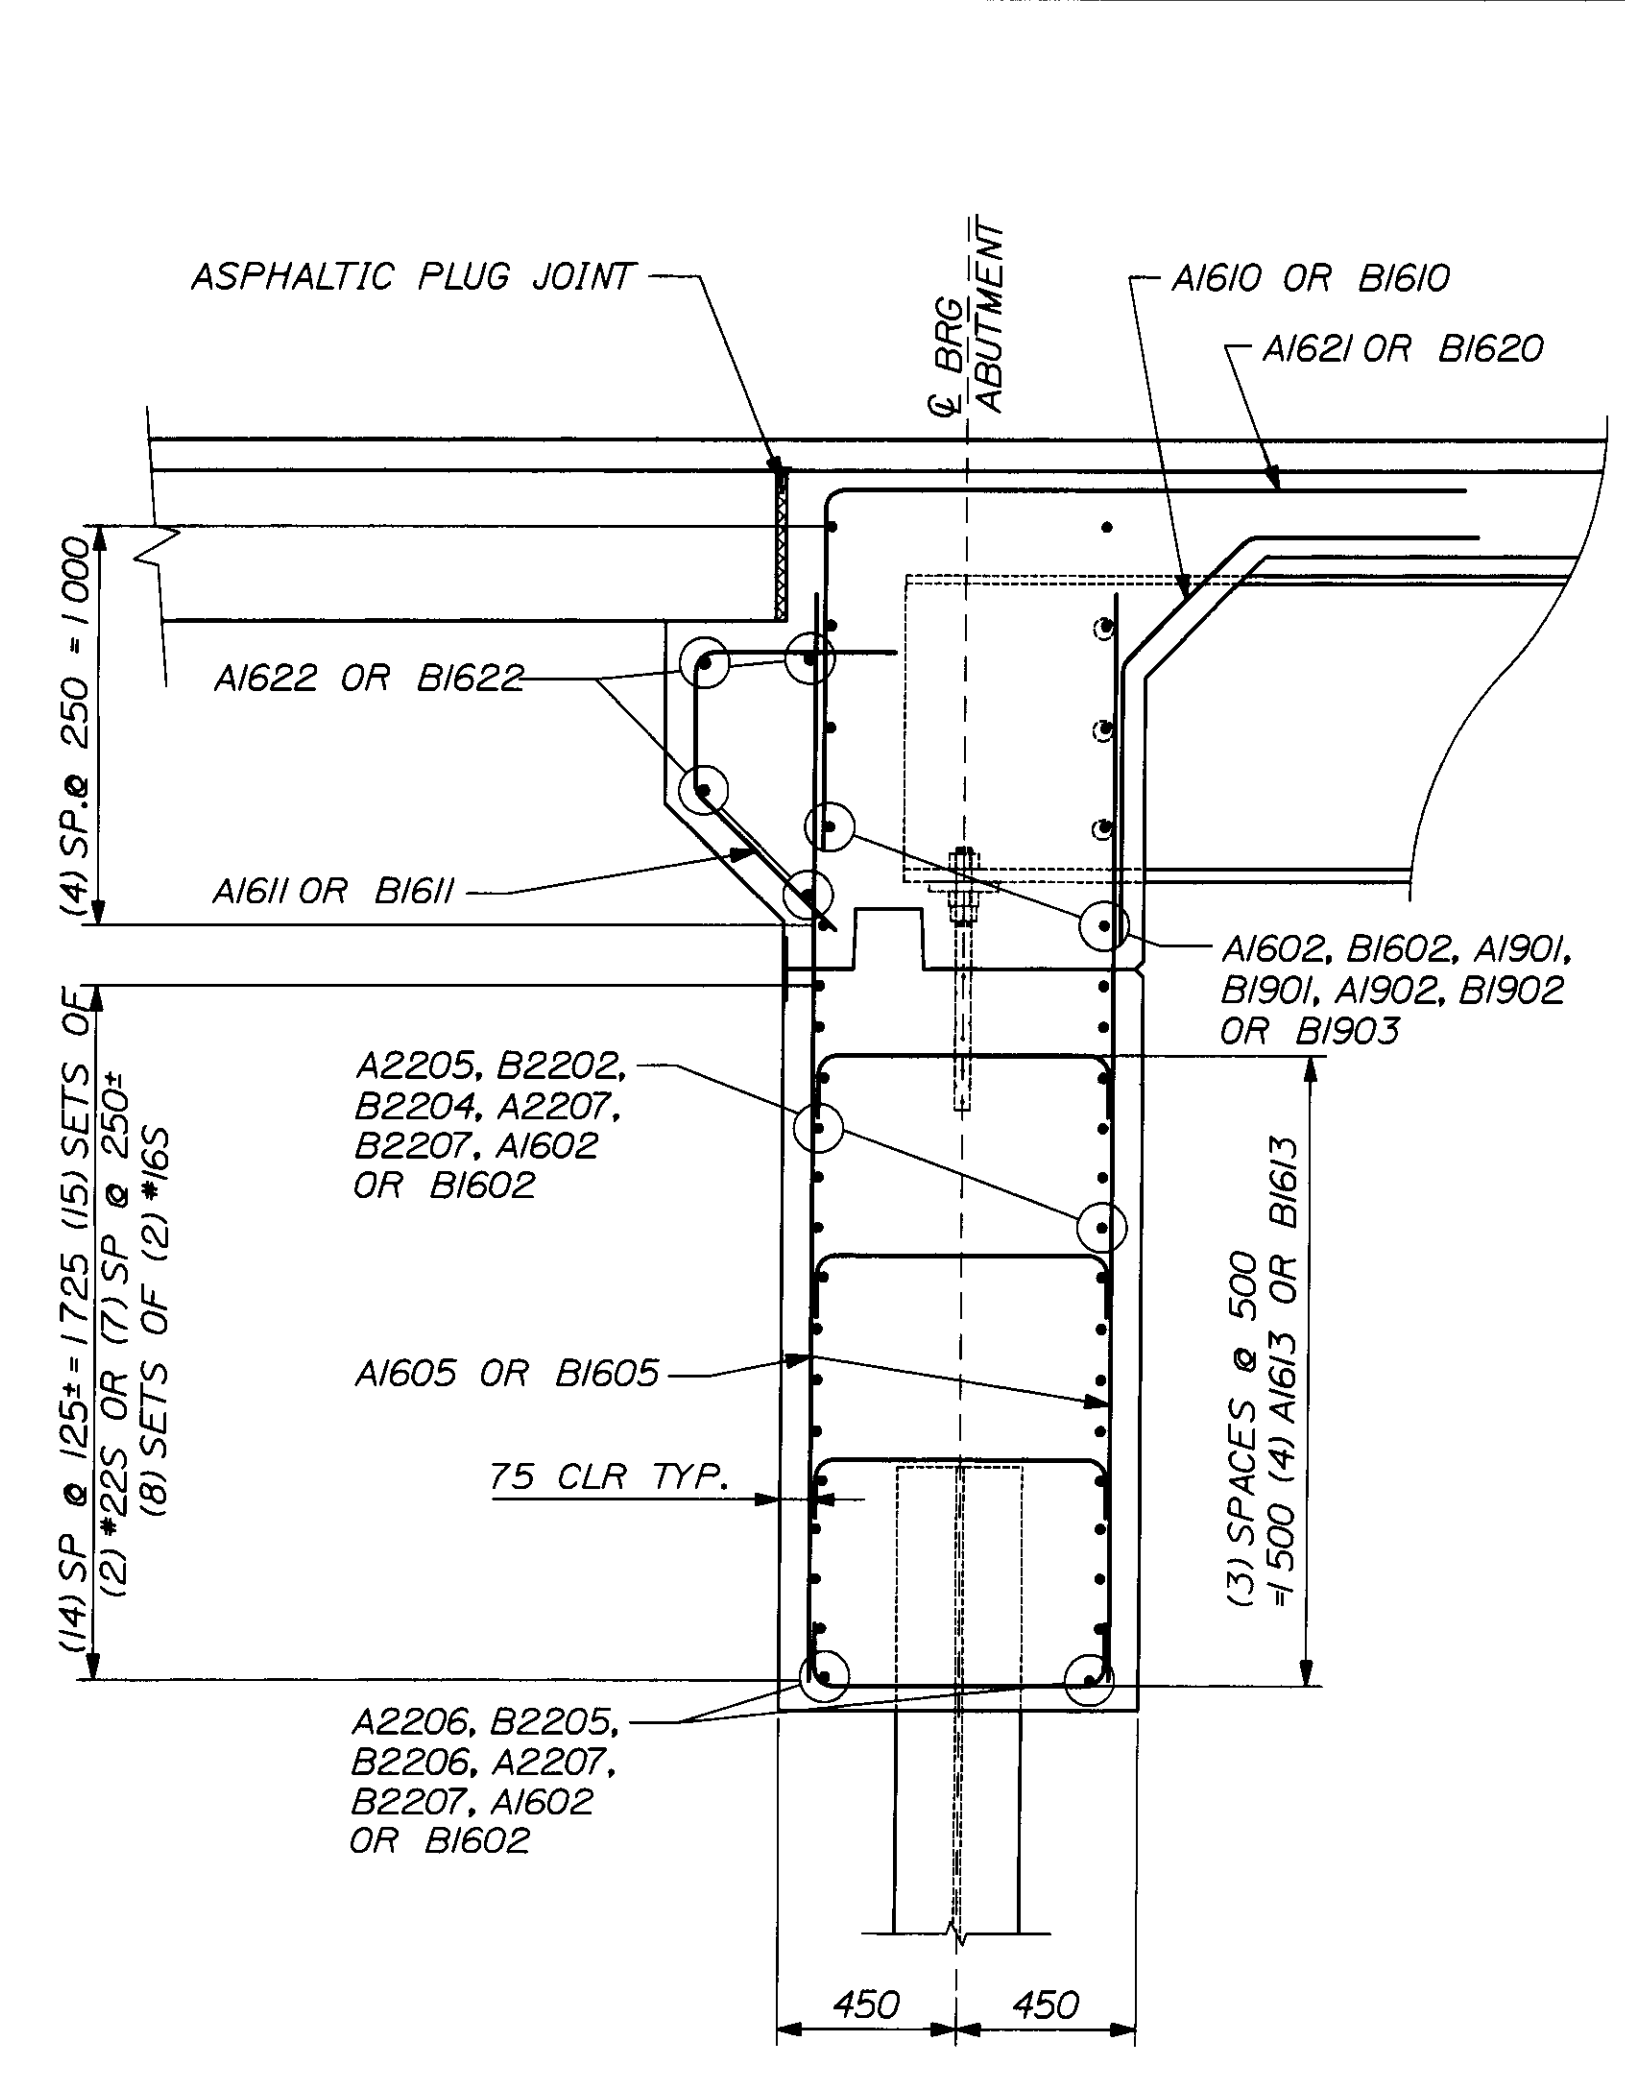

ABUTMENT REINFORCING SECTION

FOR DECK SLAB REINFORCING DETAILS REFERENCE DECK SLAB SHEETS

CALDERWOOD ENGINEERING, ETC.
STRUCTURAL ENGINEERING • DETAILING SERVICES
222 RIVER ROAD, RICHMOND, NE 04857 PH/FX (603)731-4801
PREPARED FOR AUSTIN CONST., INC
BURKE - VALUE ENGINEERING
PROJ. BRZ 1447 (16)

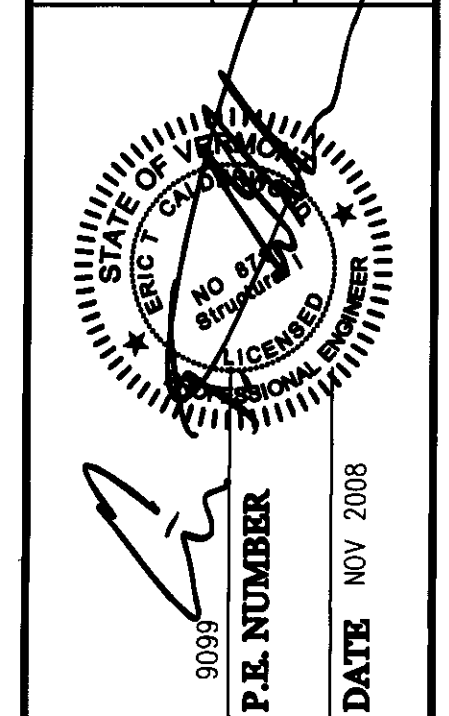

| DESIGN-DETAILED | CHECKED-REVIEWED | BY | DATE |
|-----------------|------------------|--------------------------|--------|
| | | ETC | NOV 08 |
| REVISIONS 1 | | REVISOR | JAN 09 |
| REVISIONS 2 | | NO CHANGES THIS SHEET | MAR 09 |
| REVISIONS 3 | | REVISED PER DRIVING COND | APR 09 |
| REVISIONS 4 | | | |
| FIELD CHANGES | | | |

BURKE
VALUE ENGINEERED DESIGN
ABUT DIMENSIONAL & REINF. SECTIONS

SHEET NUMBER
A5