



DECK REINFORCING PLAN

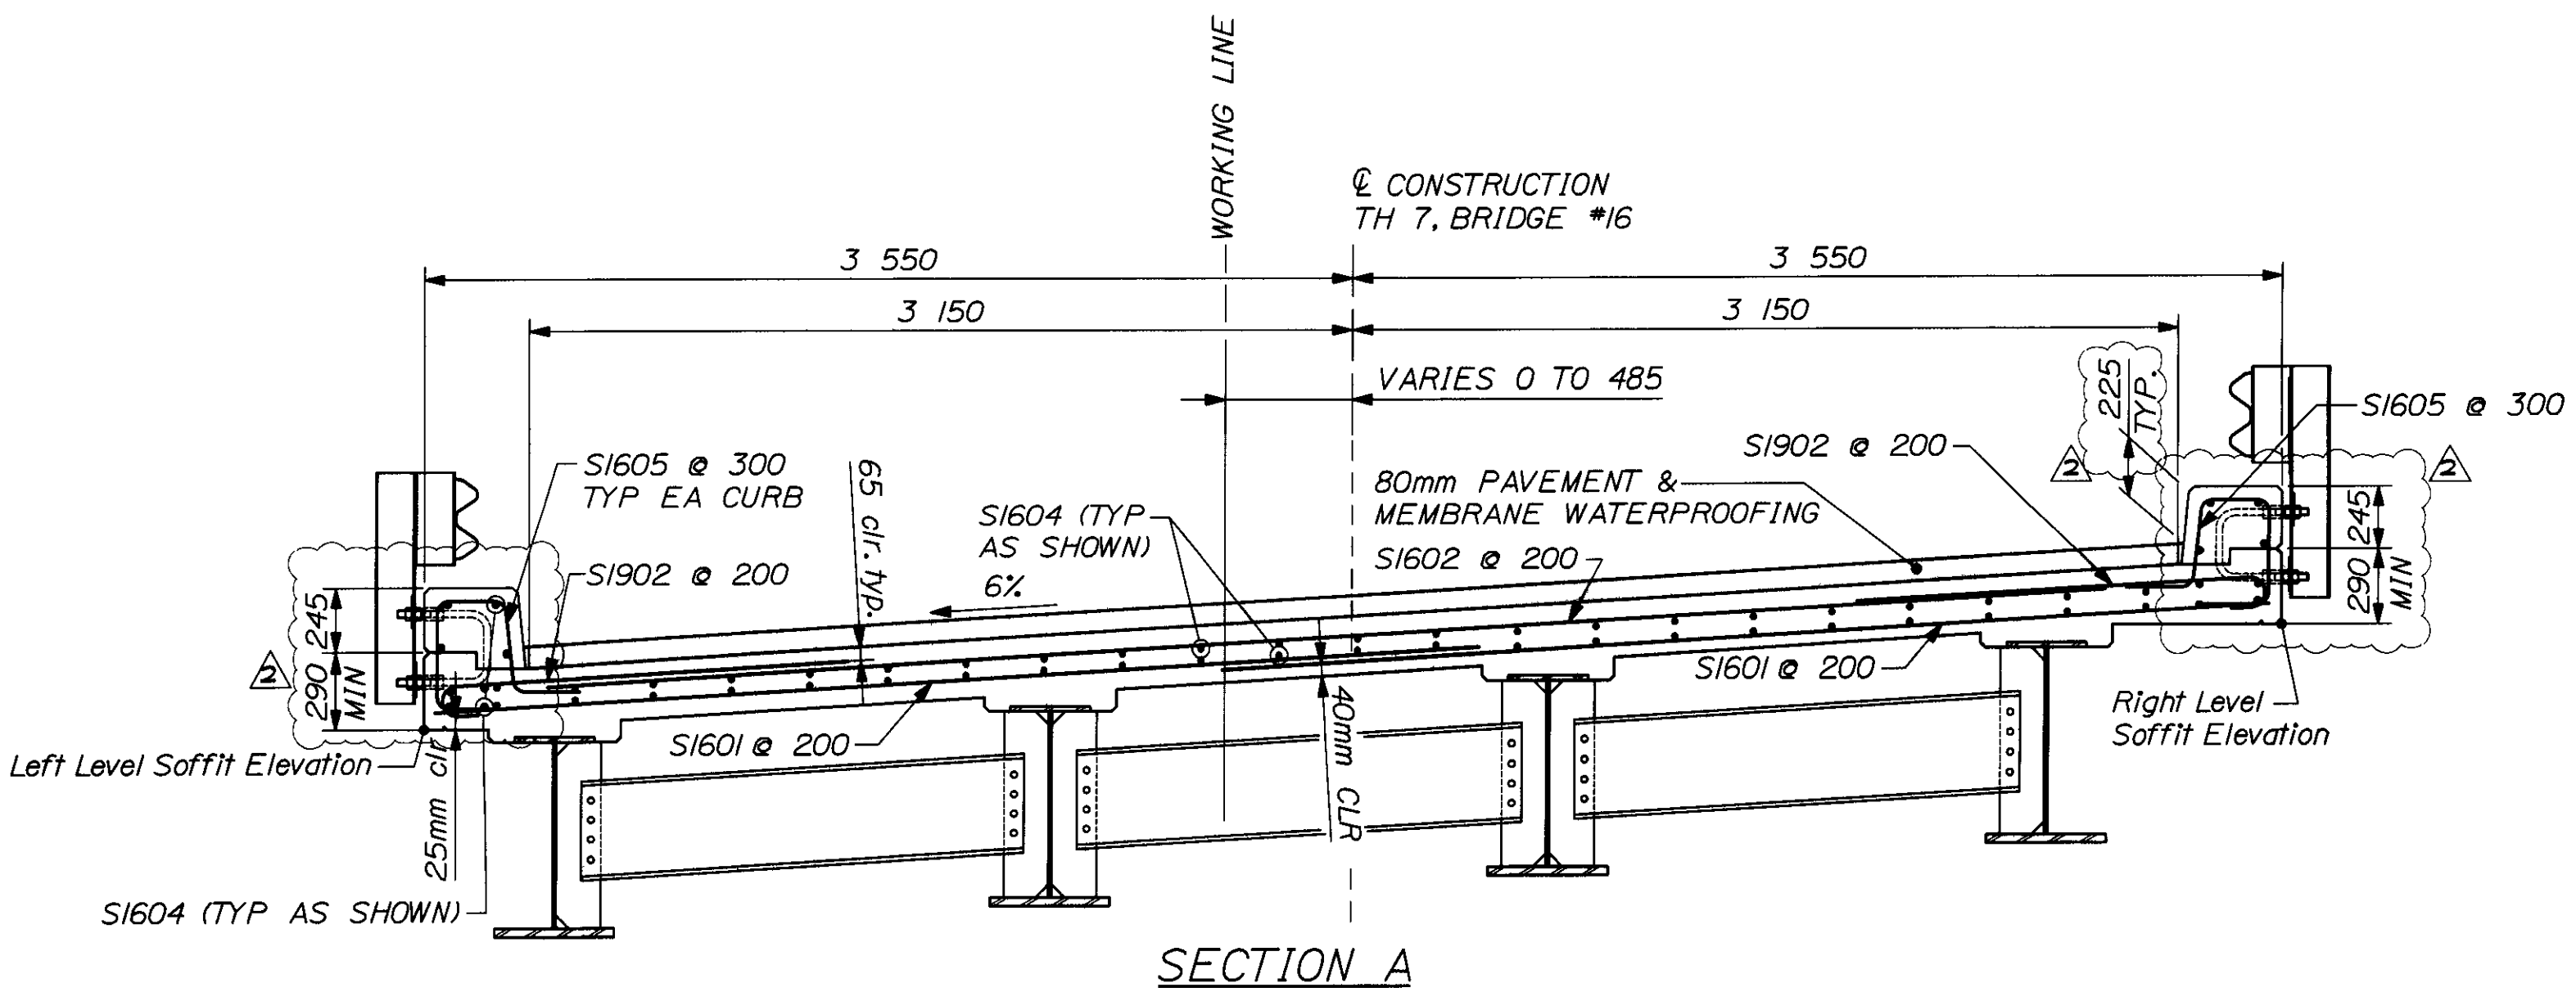

SECTION A

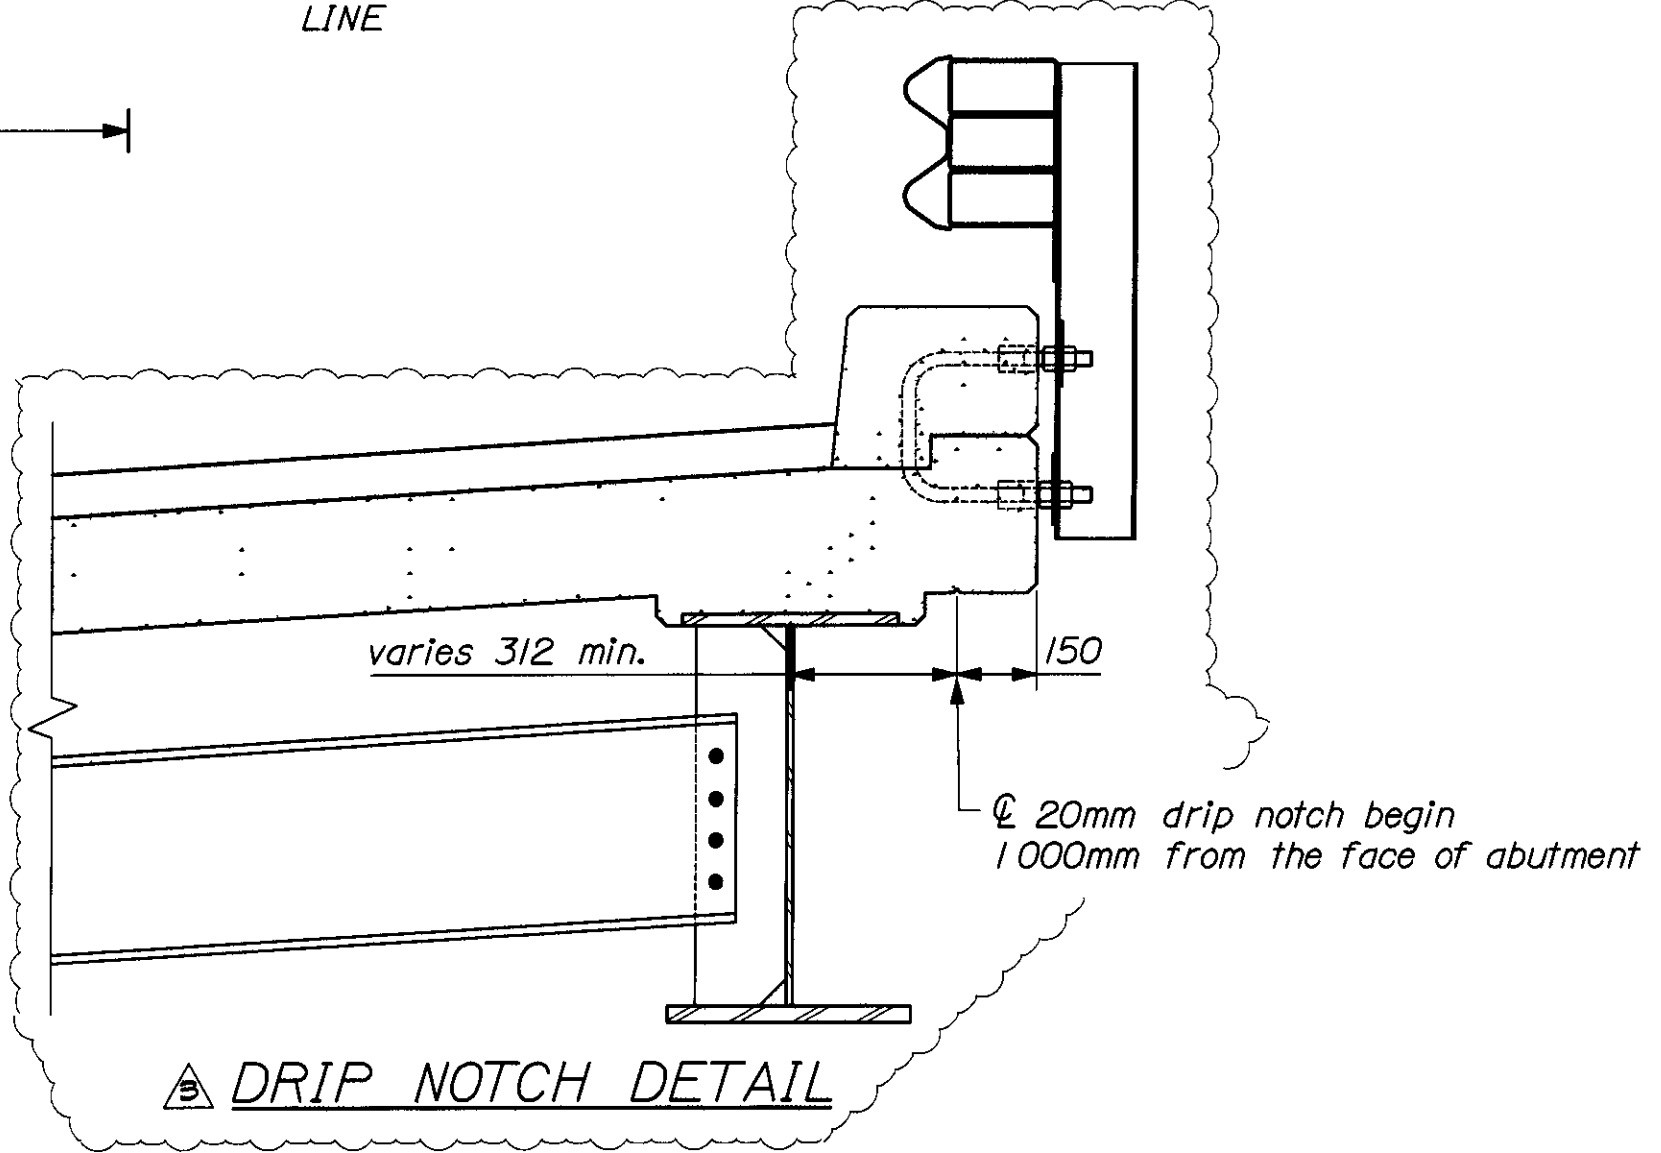


DRIP NOTCH DETAIL

**BOTTOM OF SLAB ELEVATIONS**

	A	B	C	D	E	F	G	H	I	J	K
	ABUT. 1	2200	4400	6600	8800	11000	13200	15400	17600	19800	ABUT. 2
G1	293.870	293.975	294.075	294.180	294.285	294.385	294.485	294.580	294.675	294.770	294.865
G2	293.965	294.065	294.170	294.270	294.375	294.475	294.570	294.660	294.755	294.845	294.935
G3	294.060	294.160	294.260	294.360	294.460	294.555	294.650	294.740	294.830	294.920	295.010
G4	294.155	294.250	294.345	294.445	294.540	294.635	294.730	294.820	294.905	294.995	295.085

FOR LEFT AND RIGHT BOTTOM OF DECK SOFFIT LOCATIONS REFERENCE SHEET S2  
BOTTOM OF SLAB ELEVATIONS ACCOUNT FOR FLUID LOAD DEFLECTIONS

CALDERWOOD ENGINEERING, ETC.  
STRUCTURAL ENGINEERING • DETAILING SERVICES  
222 RIVER ROAD, RICHMOND, NE 06887 PH/FX (207) 737-4801  
PREPARED FOR AUSTIN CONST., INC  
BURKE - VALUE ENGINEERING  
PROJ. BRZ 1447 (16)

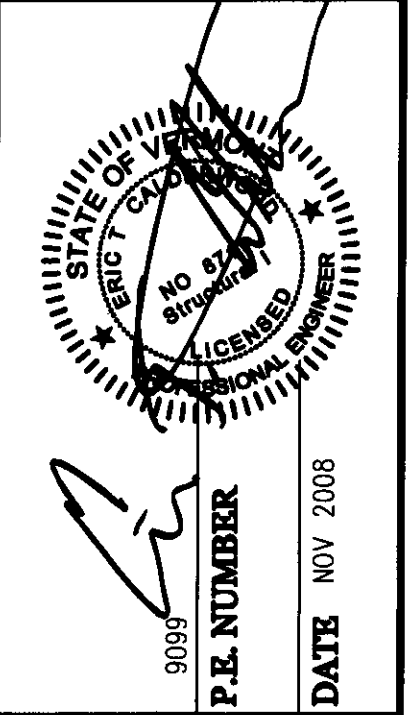

DESIGN DETAILED	DATE	NOV 08
CHECKED/REVIEWED	BY	ETC
REVISIONS 1	ADDRESS A/C COMMENTS	JAN 09
REVISIONS 2	MISC REVISIONS	MAR 09
REVISIONS 3	MISC REVISIONS	APR 09
REVISIONS 4	MISC REVISIONS	
FIELD CHANGES		

BURKE  
VALUE ENGINEERED DESIGN  
DECK REINFORCING PLAN

SHEET NUMBER  
**S1**