


**CALDERWOOD ENGINEERING, ETC.**  
 STRUCTURAL ENGINEERING • DETAILING SERVICES  
 222 RIVER ROAD, RICHMOND, ME 04857 PH:FX (207)787-4801  
**PREPARED FOR AUSTIN CONST., INC**  
 BURKE - VALUE ENGINEERING  
 PROJ. BRZ 1447 (16)

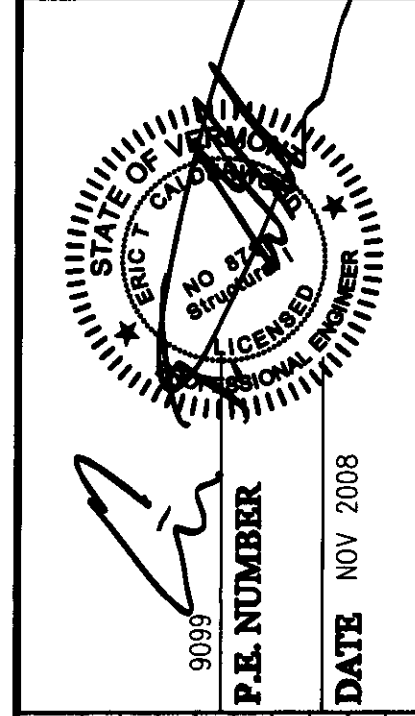

DESIGN-DETAILED	CHECKED-REVISED	BY	DATE
		ETC	NOV 08
REVISIONS 1	NO REVISIONS THIS SHEET		JAN 09
REVISIONS 2	NO REVISIONS THIS SHEET		MAR 09
REVISIONS 3	NO REVISIONS THIS SHEET		APR 09
REVISIONS 4			
FIELD CHANGES			

**BURKE**  
 VALUE ENGINEERED DESIGN  
 CROSS SECTIONS

**SHEET NUMBER**  
 C2