


3+050

CALDERWOOD ENGINEERING, ETC.
 STRUCTURAL ENGINEERING • DETAILING SERVICES
 222 RIVER ROAD, RICHMOND, ME 04857 PH/FX (207)757-4801
PREPARED FOR AUSTIN CONST., INC
 BURKE - VALUE ENGINEERING
 PROJ. BRZ 1447 (16)

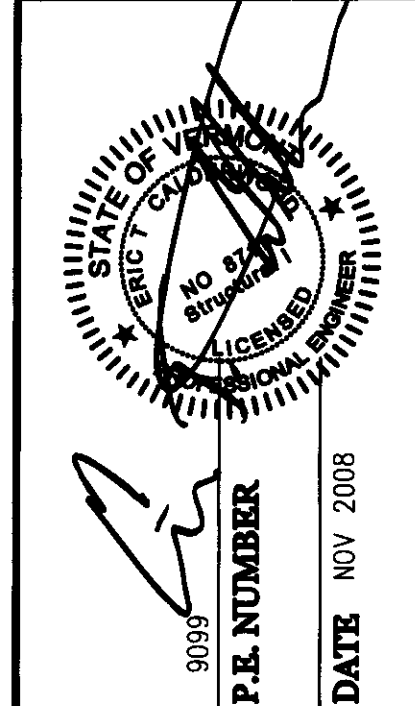

DESIGN-DETAILED	BY	DATE
CHECKED-REVIEWED	ETC	NOV 08
REVISIONS 1	NO REVISIONS THIS SHEET	JAN 09
REVISIONS 2	NO REVISIONS THIS SHEET	MAR 09
REVISIONS 3	NO REVISIONS THIS SHEET	APR 09
REVISIONS 4	NO REVISIONS THIS SHEET	
FIELD CHANGES		

BURKE
VALUE ENGINEERED DESIGN
CROSS SECTIONS

SHEET NUMBER
C5