



# BRIDGE # 17

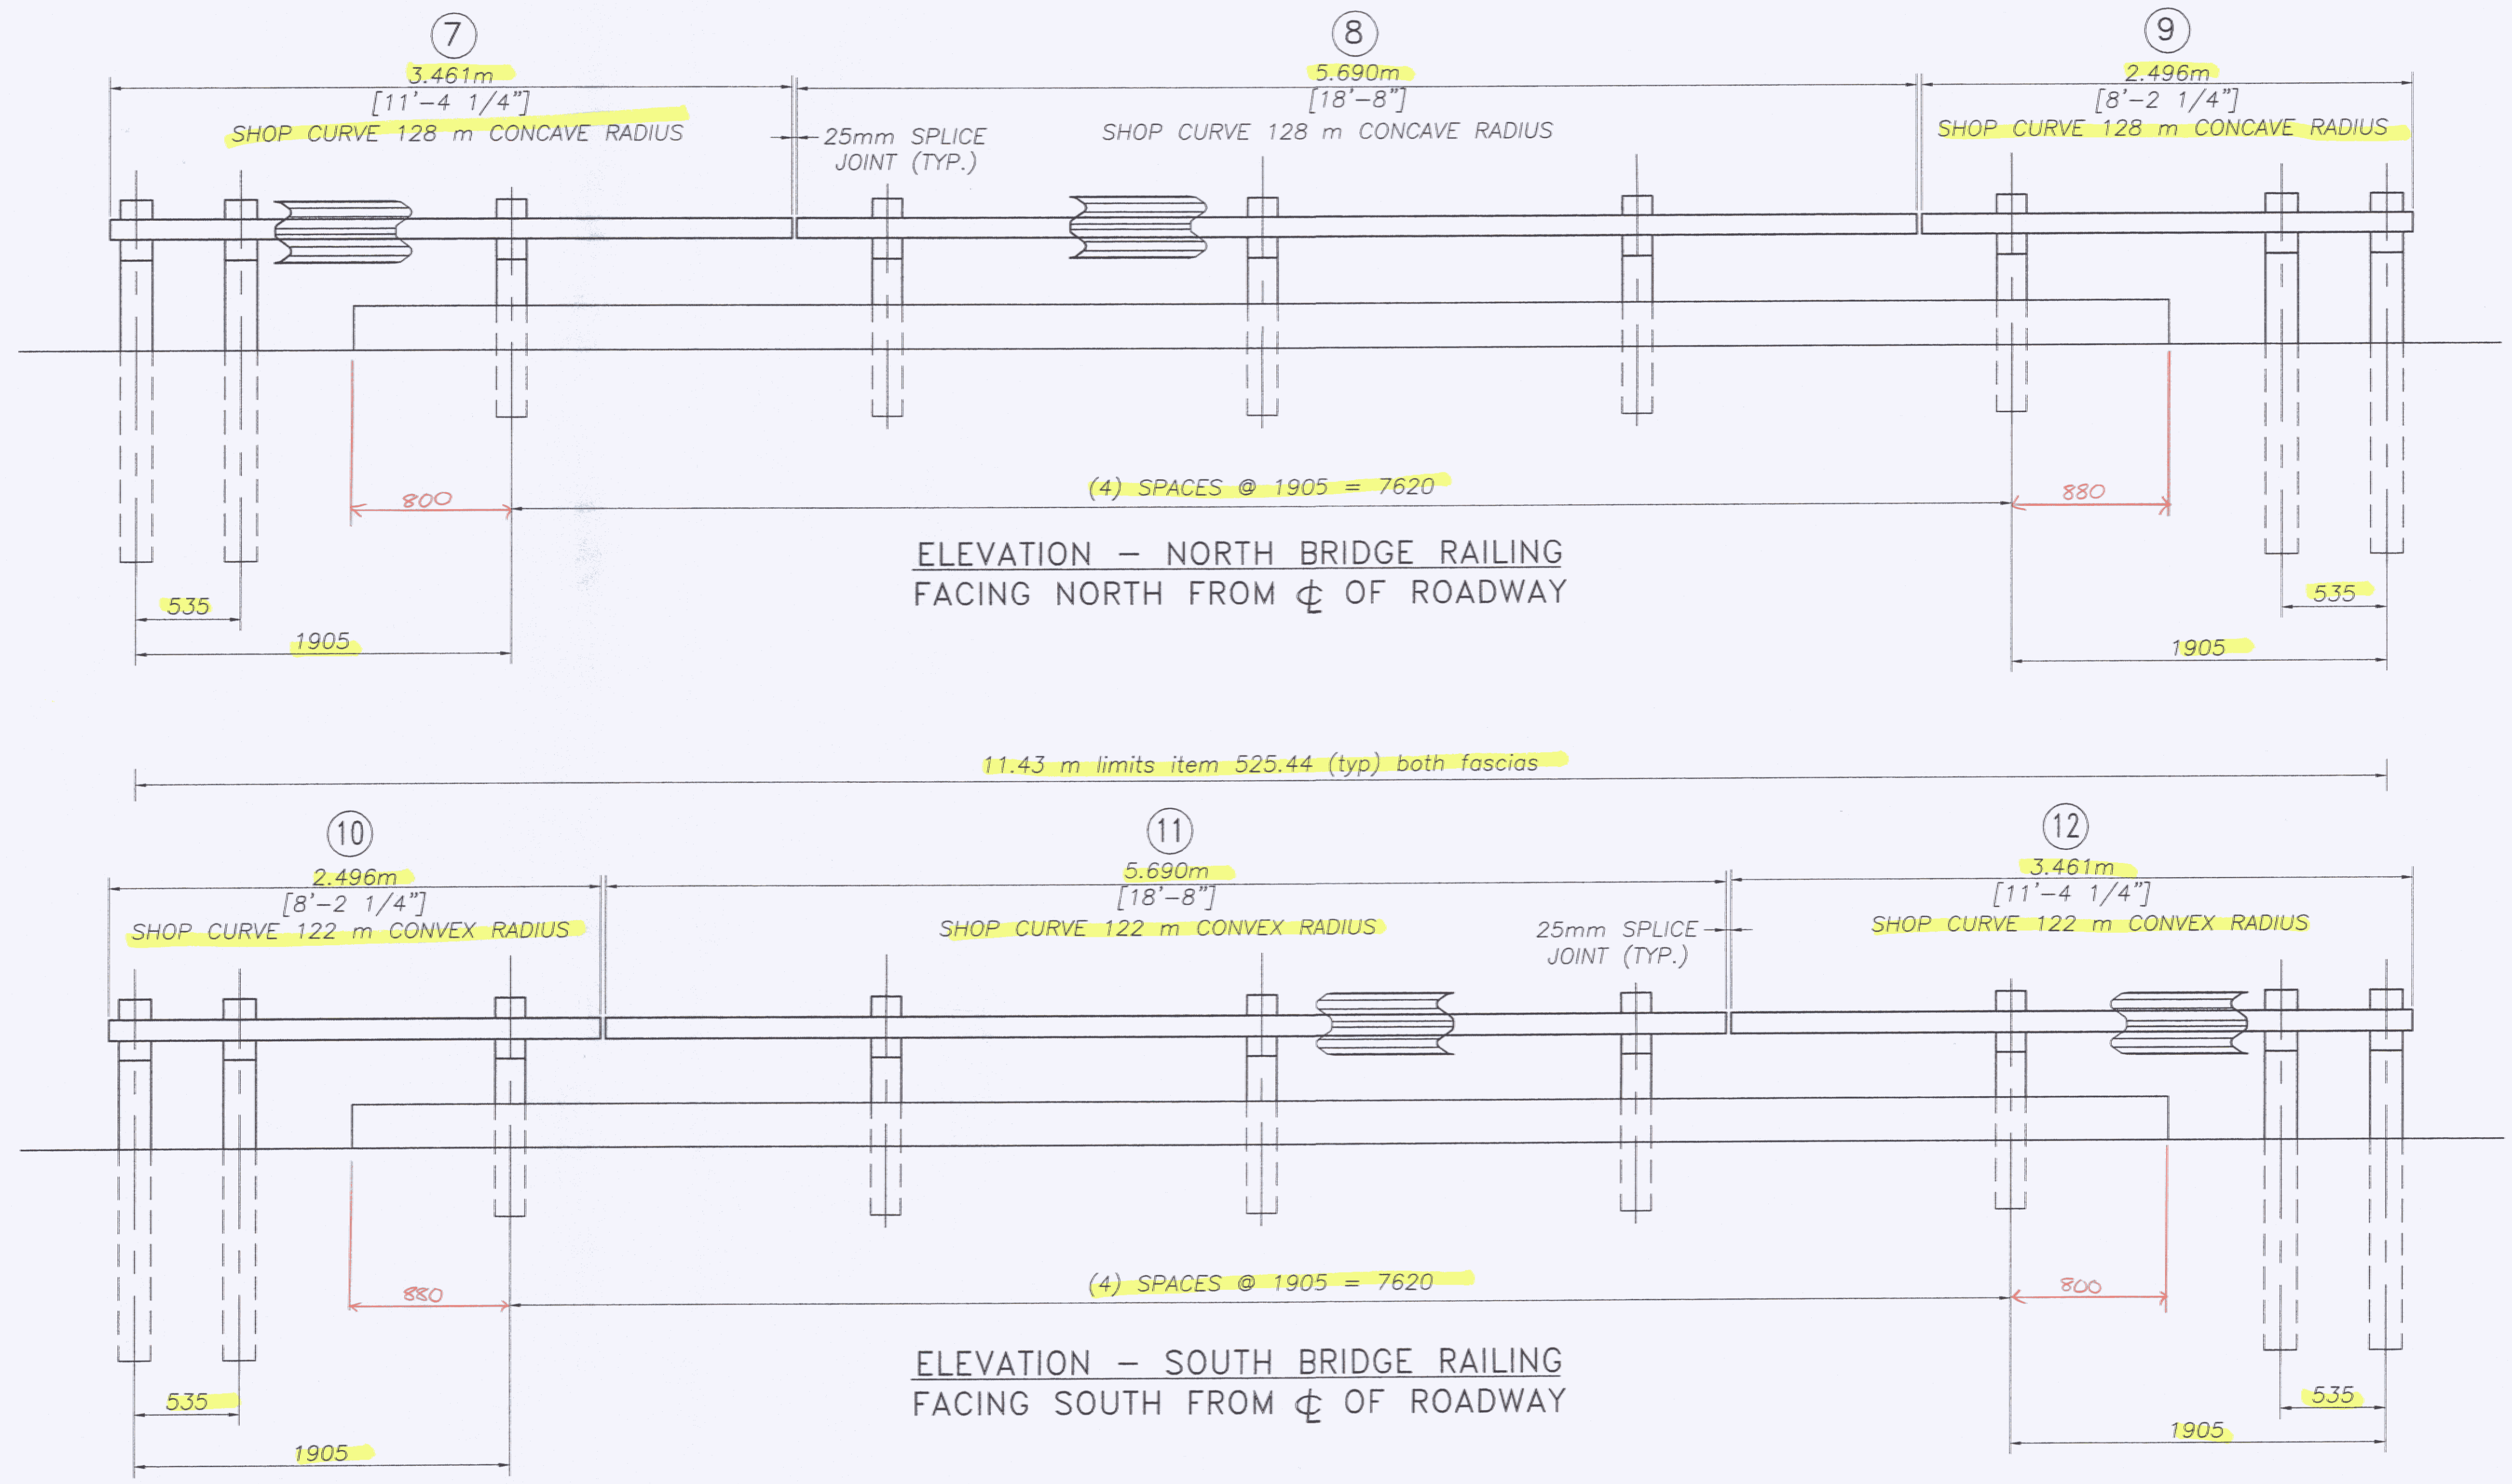

11.43 m limits item 525.44 (typ) both fascias

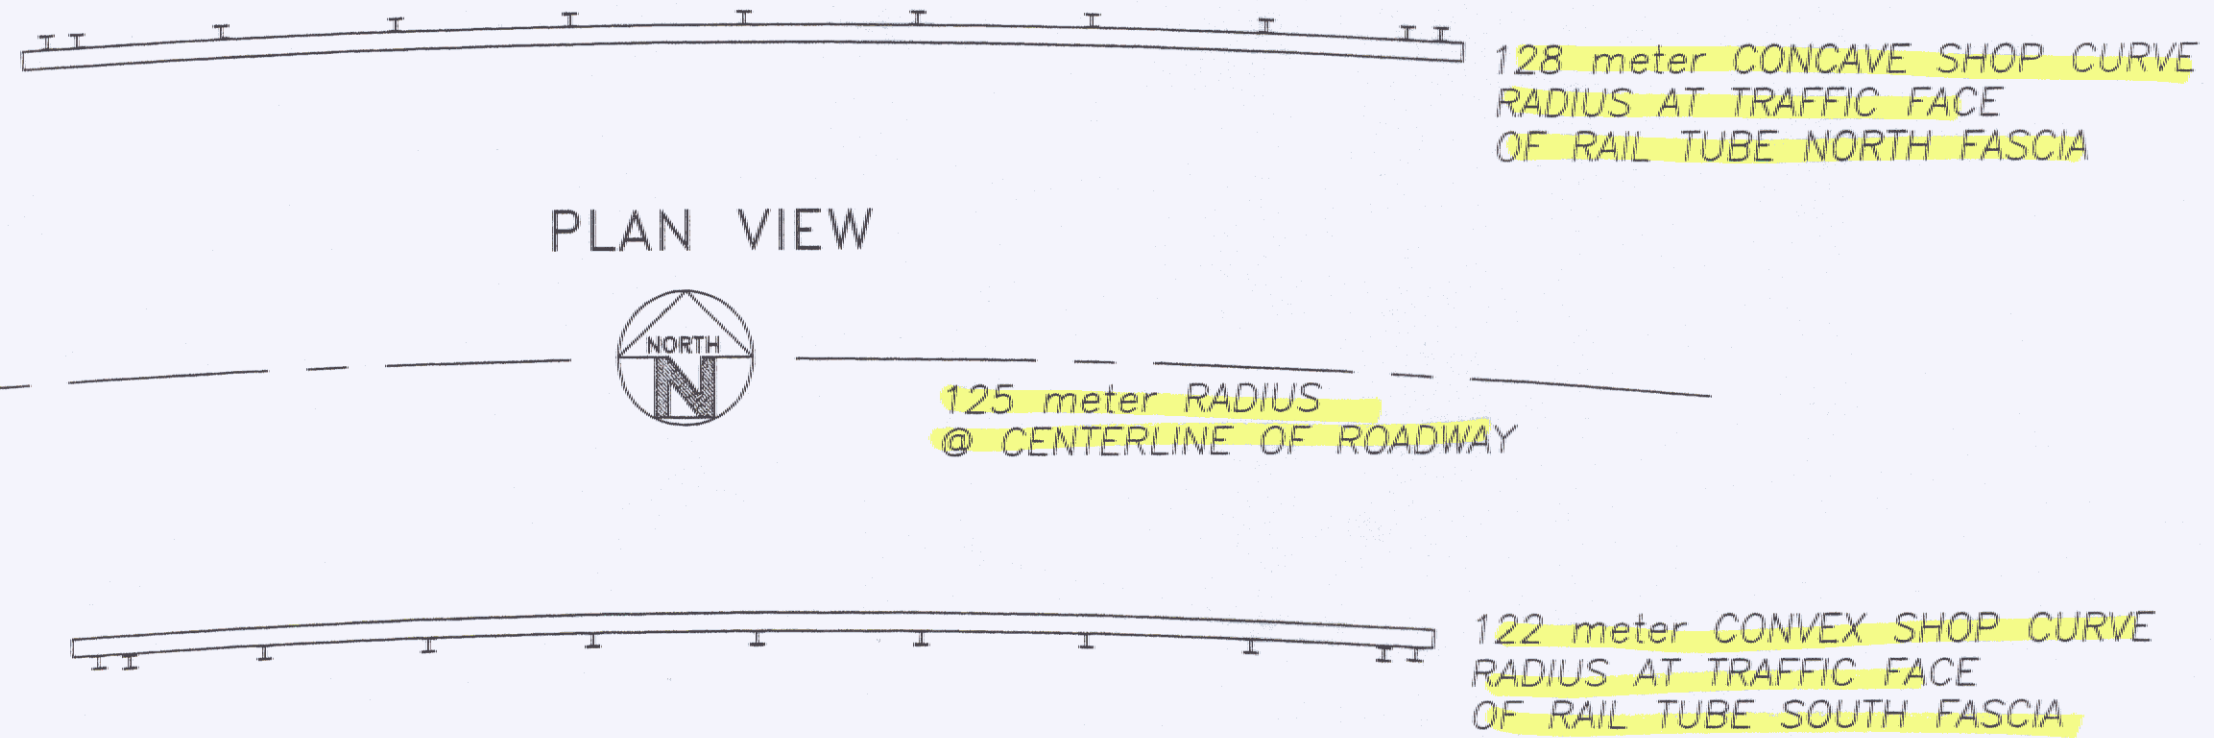

NOTE: ALL LINEAR DIMENSIONS ARE MEASURED ALONG FASCIA


PORTIONS OF HDSB & STEEL TUBE BLOCKOUTS REMOVED FROM THIS VIEW FOR CLARITY.

ALL DIMENSION SHOWN ARE IN (mm) MILLIMETERS UNLESS OTHERWISE NOTED.

SHOP CURVE RADIUS DIMENSIONS HAVE BEEN ROUNDED TO NEAREST METER TO REFLECT MANUFACTURING TOLERANCES

REVISIONS		
No.	Remarks	Date
0	Initial submittal	

RECEIVED  
 OK'D BY LS OK'D BY ELK  
 AUG 05 2008  
 RESUBMIT APPROVED As Noted  
 BY CPW DATE 8/12/08

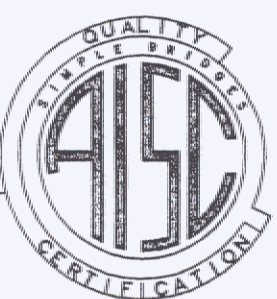

**HIGHWAY SAFETY CORP.**  
 GLASTONBURY, CT

ITEM 525.44 SB-R790M  
 BRIDGE RAILING, GALVANIZED HDSB/  
 FASCIA MOUNTED/STEEL TUBING  
 TOWN OF BURKE, VT  
 PROJECT No. BRZ 1447 (15)

GENERAL CONTRACTOR  
 SUB CONTRACTOR F. R. LAFAYETTE

DRAWN p. radice  
 CHECKED  
 DATE 7/24/08  
 SCALE NONE  
 HSC REFERENCE NO. 1661  
 SIZE D REVISION 0  
 SHEET NO. 2 of 3