


TOWN HIGHWAY \* 19  
(MURPHY ROAD)

**NOTES**  
1. ELEVATION OF BOTTOMS OF ABUTMENTS ARE UNKNOWN.

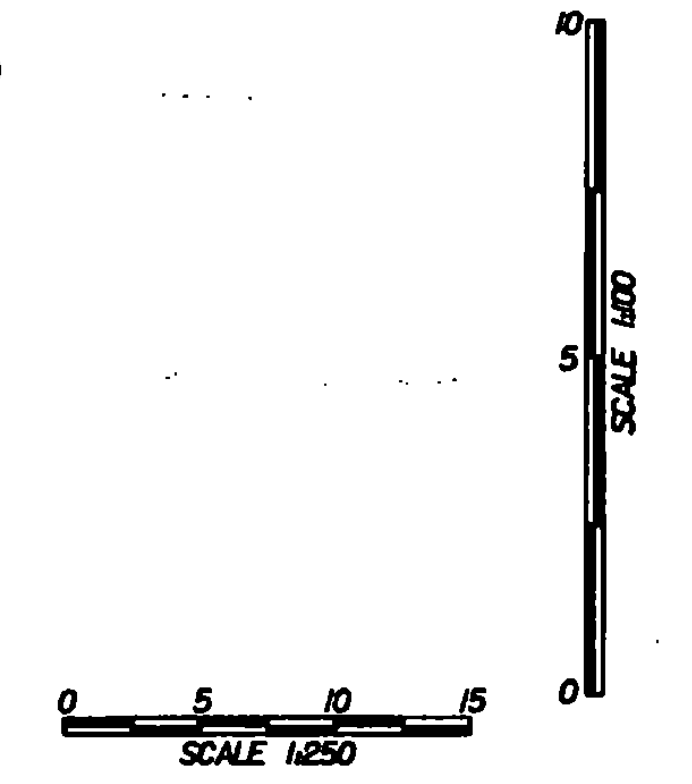

**DATUM**  
VERTICAL \_\_\_\_\_  
HORIZONTAL \_\_\_\_\_

<b>STATE OF VERMONT AGENCY OF TRANSPORTATION</b>			
Town Of	BENNINGTON	Bridge No.	31
Highway No.	T.H. #19 (MURPHY ROAD)	Loc. Sta.	
		Surv. Sta.	
<b>PAPER MILL COVERED BRIDGE REHABILITATION</b>			
<b>PROFILE</b>			
Designed By	J. VASKOVIC	Drawn By	C. MABY
Checked By	J. VASKOVIC	Bridge Design Supervisor	P. MALACHOWSKI
	Date 5/99	Date	5/99
PROJECT	BENNINGTON	PROJECT NO.	BHZ 144(118)
I.C.C. Info.	m\1994880\144bdr.dgn		
Bridge Sheet No.	Sheet 6 of 22		