


STA I+086.107  
 BEGIN PROJECT BHZ 1441 (18)  
 BEGIN BRIDGE

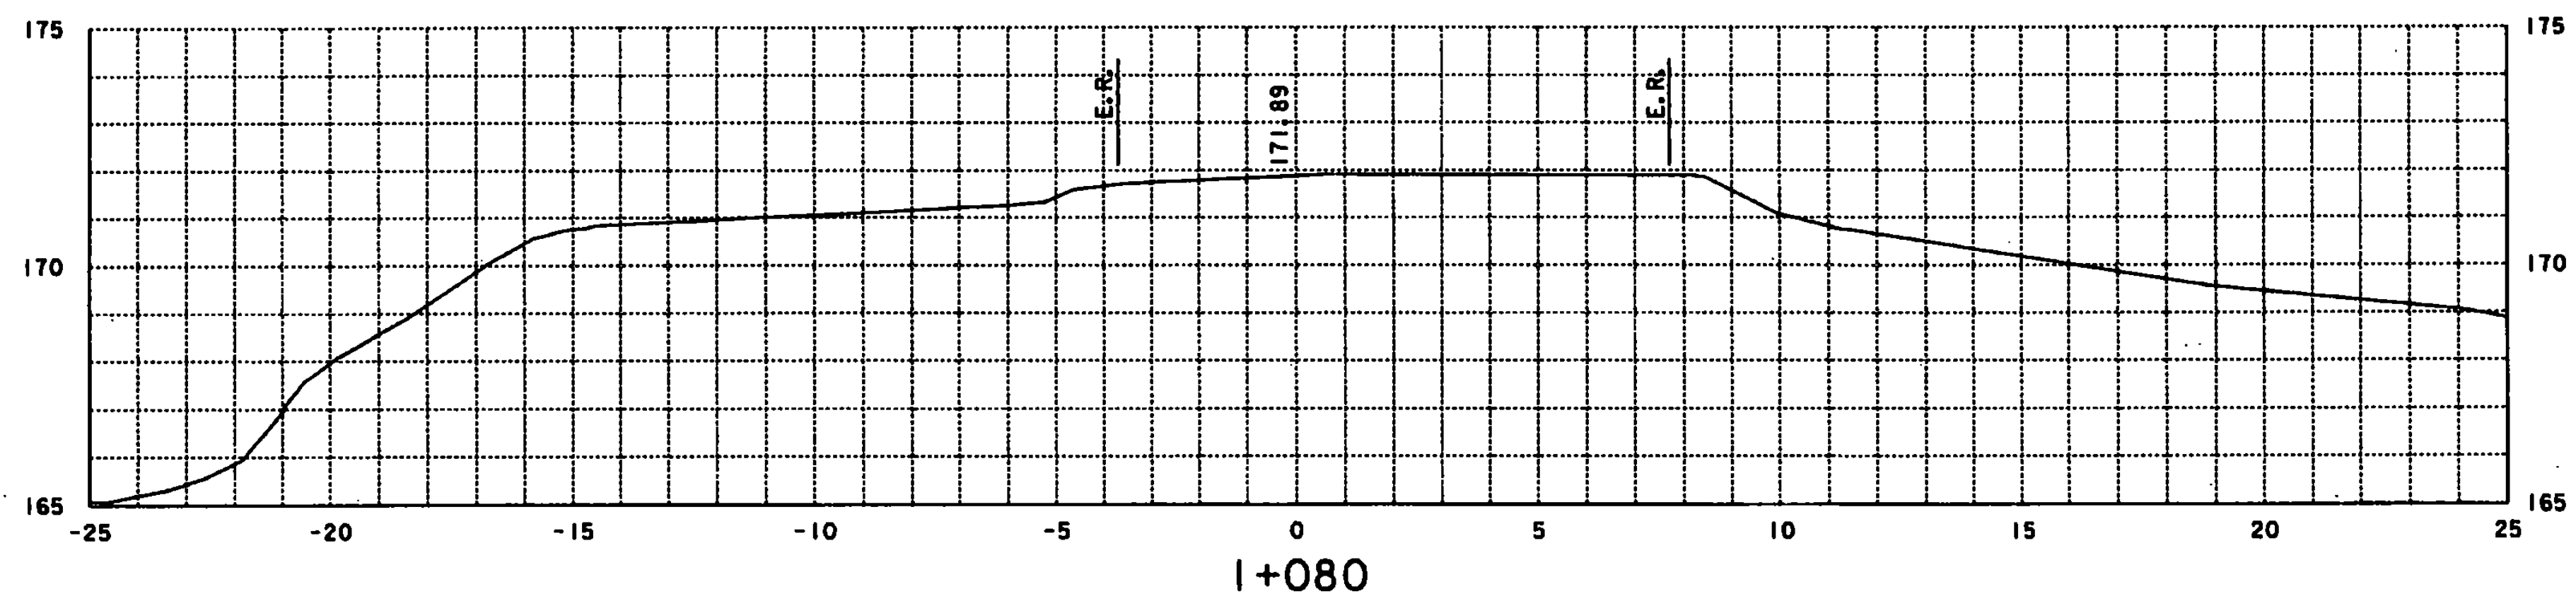

SCALE 1" = 1m

FROM STA. I+080 TO STA. I+100 T.J.L. '99  
 PROJECT NAME: BENNINGTON  
 PROJECT NO. BHZ 1441(18)  
 PLOTTED BY: JAV 8/27/96 CHECKED BY:  
 SHEET 17 OF 22 SHEETS

en:\p\2000\1441\18.dgn