


SEE SHEET 2 FOR INDEX OF SHEETS
AND LIST OF STANDARDS

RECORD PLANS	
CONTRACTOR	FW WHITCOMB CONSTRUCTION CORP., WALPOLE, NH
RESIDENT ENGINEER	DAN BREER
CONSTRUCTION BEGAN	JUNE 9, 2008
CONSTRUCTION COMPLETE	AUGUST 20, 2009
RECORD PLANS BY	DAN BREER & NICK GARABICK
I HEREBY CERTIFY THAT ALL THE CONSTRUCTION REQUIRED BY THIS SET OF DRAWINGS HAS BEEN ACCOMPLISHED AS INDICATED HEREIN	
BY	<i>[Signature]</i> RESIDENT ENGINEER
DATE	4/6/10
NOTE: Any further information concerning final quantities, amounts or other details relative to this project may be found at Central Files in the electronic archive.	

STATE OF VERMONT
AGENCY OF TRANSPORTATION




PROPOSED IMPROVEMENT
BRIDGE PROJECT
TOWN OF POWNAL COUNTY OF BENNINGTON
ROUTE NO : TH 24, CL3 (LOCAL) BRIDGE NO : 41

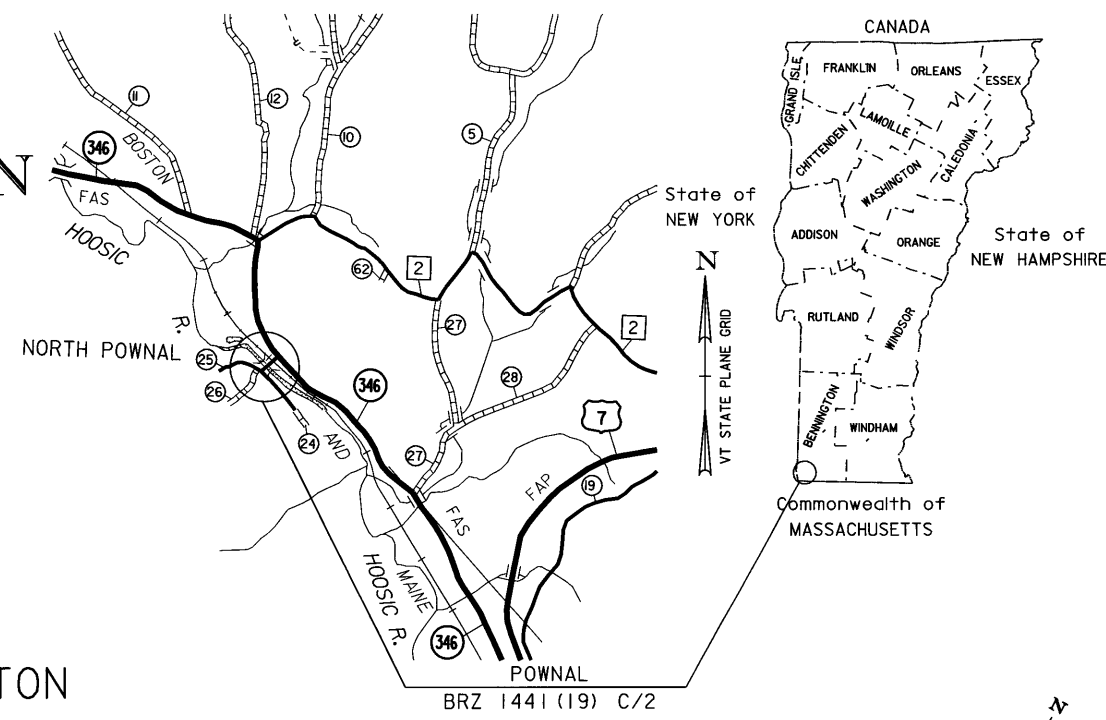

PROJECT LOCATION : BEGINNING AT A POINT ON TH 24 APPROXIMATELY 627 FEET SOUTHWEST OF ITS INTERSECTION WITH VT 346 AND PROCEEDING 0.120 MILES ALONG TH 24 TOWARD THE INTERSECTION OF TH 24 AND VT 346.

PROJECT DESCRIPTION : THE PROJECT SHALL CONSIST OF CONSTRUCTION OF A NEW SUPERSTRUCTURE AND REHABILITATION OF THE SUBSTRUCTURE ALONG WITH RELATED ROADWAY APPROACH, CHANNEL WORK AND REMOVAL OF THE EXISTING TEMPORARY BRIDGE

LENGTH OF STRUCTURE : 234.25 FEET.
LENGTH OF ROADWAY : 392.75 FEET.
LENGTH OF PROJECT : 627.00 FEET.

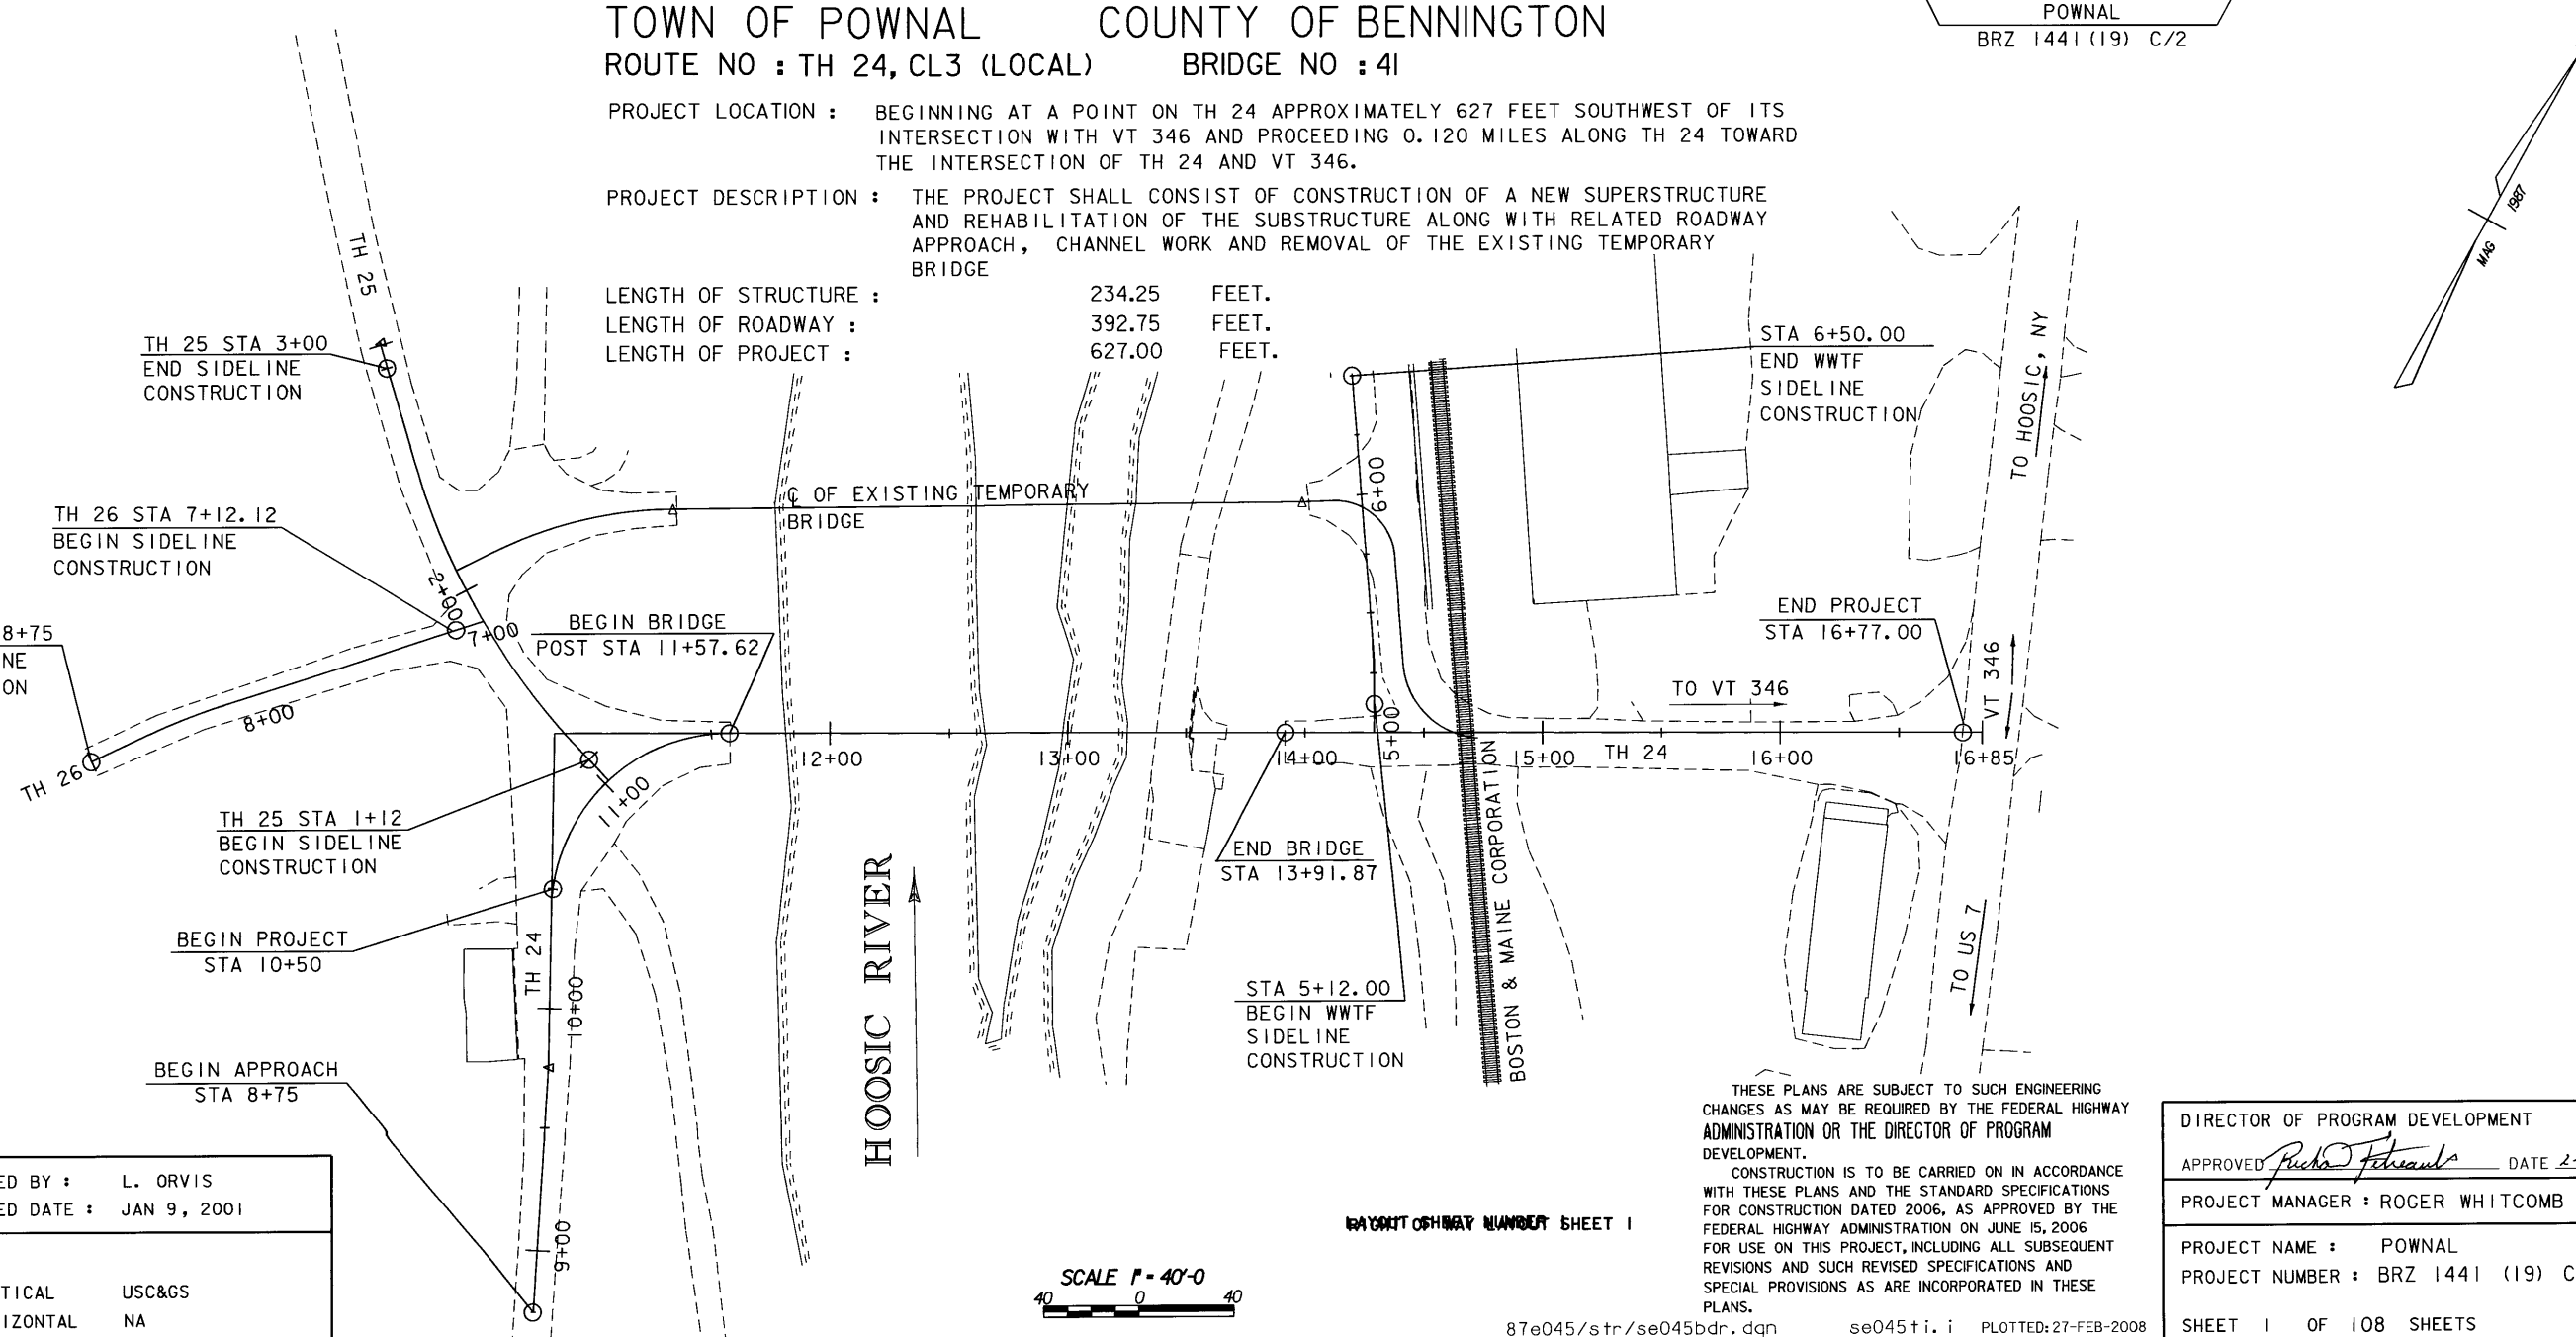

CONVENTIONAL SYMBOLS	
COUNTY LINE	— — — — —
TOWN LINE	— — — — —
LIMITS OF ACCESS	— — — — —
POINT OF ACCESS	X
FENCE LINE	— — — — —
STONE WALL	— — — — —
TRAVELLED WAY	— — — — —
ROAD RAIL	— — — — —
RAILROAD	— — — — —
SURVEY LINE	— — — — —
CLVERT	— — — — —
POWER POLE	⊕
TELEPHONE POLE	⊕
TREES	— — — — —
CONTROL OF ACCESS	— — — — —
PROPERTY LINE	— — — — —
BLK.W. TAKING LINE	— — — — —
SLOPE RIGHTS	— — — — —
TOP OF CUT	— — — — —
TOE OF SLOPE	— — — — —

SURVEYED BY : L. ORVIS
SURVEYED DATE : JAN 9, 2001
DATUM : VERTICAL USCGS
HORIZONTAL : NA

SCALE 1" = 40'-0"

THESE PLANS ARE SUBJECT TO SUCH ENGINEERING CHANGES AS MAY BE REQUIRED BY THE FEDERAL HIGHWAY ADMINISTRATION OR THE DIRECTOR OF PROGRAM DEVELOPMENT.
CONSTRUCTION IS TO BE CARRIED ON IN ACCORDANCE WITH THESE PLANS AND THE STANDARD SPECIFICATIONS FOR CONSTRUCTION DATED 2006, AS APPROVED BY THE FEDERAL HIGHWAY ADMINISTRATION ON JUNE 16, 2008 FOR USE ON THIS PROJECT, INCLUDING ALL SUBSEQUENT REVISIONS AND SUCH REVISED SPECIFICATIONS AND SPECIAL PROVISIONS AS ARE INCORPORATED IN THESE PLANS.

DIRECTOR OF PROGRAM DEVELOPMENT
APPROVED: *[Signature]* DATE: 1-27-08
PROJECT MANAGER : ROGER WHITCOMB
PROJECT NAME : POWNAL
PROJECT NUMBER : BRZ 1441 (19) C/2
SHEET 1 OF 108 SHEETS