


CONSTRUCT DRIVE
W/ PAVED APRONS
STA 15+78.00 RT
STA 16+76, 37' LT - 79' LT

CHANGE ELEVATION OF SEWER MANHOLE
STA 16+73 LT

NOTE: FOR SIGNS AND PAVEMENT MARKINGS, SEE SHEETS 19 - 22.

SHEET NAME: LAYOUT SHEET NUMBER 2	
PROJECT NAME: POWNAL	HIGHWAY NO.: TH 24
PROJECT NUMBER: BRZ 144(19) C/2	BRIDGE NO.: 41
	OVER: HOOSIC RIVER
FILE NAME: 87e045/str/se045bdr.dgn	PLOT DATE: 10-MAR-2008
PROJECT MANAGER: R. WHITCOMB	DRAWN BY: CARLSON/MAGNAN
DESIGNED BY: C. CARLSON	IPARM NAME: se045la2.i
	SHEET 14 OF 108

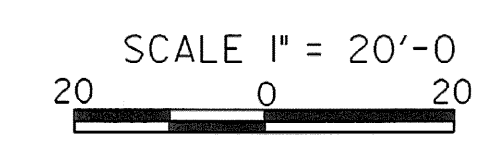

T SHEET NUMBER 1