


GRADES SHOWN TO THE NEAREST TENTH ARE EXISTING GROUND ALONG THE MAINLINE. GRADES SHOWN TO THE NEAREST HUNDREDTH ARE FINISH GRADE ALONG THE MAINLINE.

MAINLINE PROFILE Δ 5

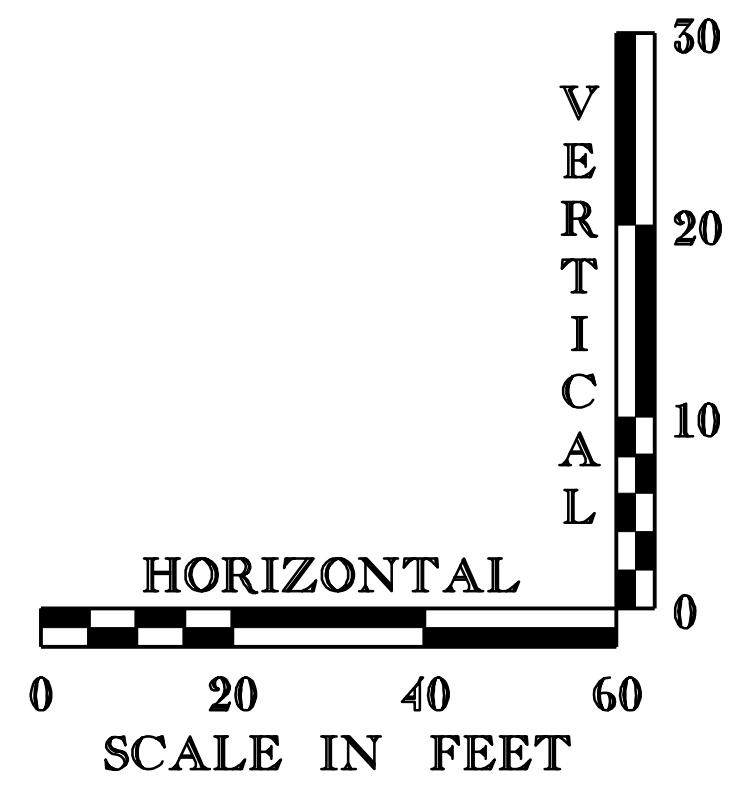

REV.	BY	DATE	DESCRIPTION
Δ 5	LBB	10/08/08	REVISED TH 24 PROFILE

SHEET NAME: MAINLINE PROFILE	
PROJECT NAME: POWNAL	HIGHWAY NO.: TH 24
PROJECT NUMBER: BRZ 1441(19) C/2	BRIDGE NO.: 41
	OVER: HOOSIC RIVER
FILE NAME: 87e045/str/se045xs3.dgn	PLOT DATE: 23-AUG-2010
PROJECT MANAGER: R. WHITCOMB	DRAWN BY: J.GILMORE
DESIGNED BY: C. CARLSON	IPARM NAME: se045pr1.l
	SHEET 15 OF 108