


PLAN

SCALE 1" = 10'-0"

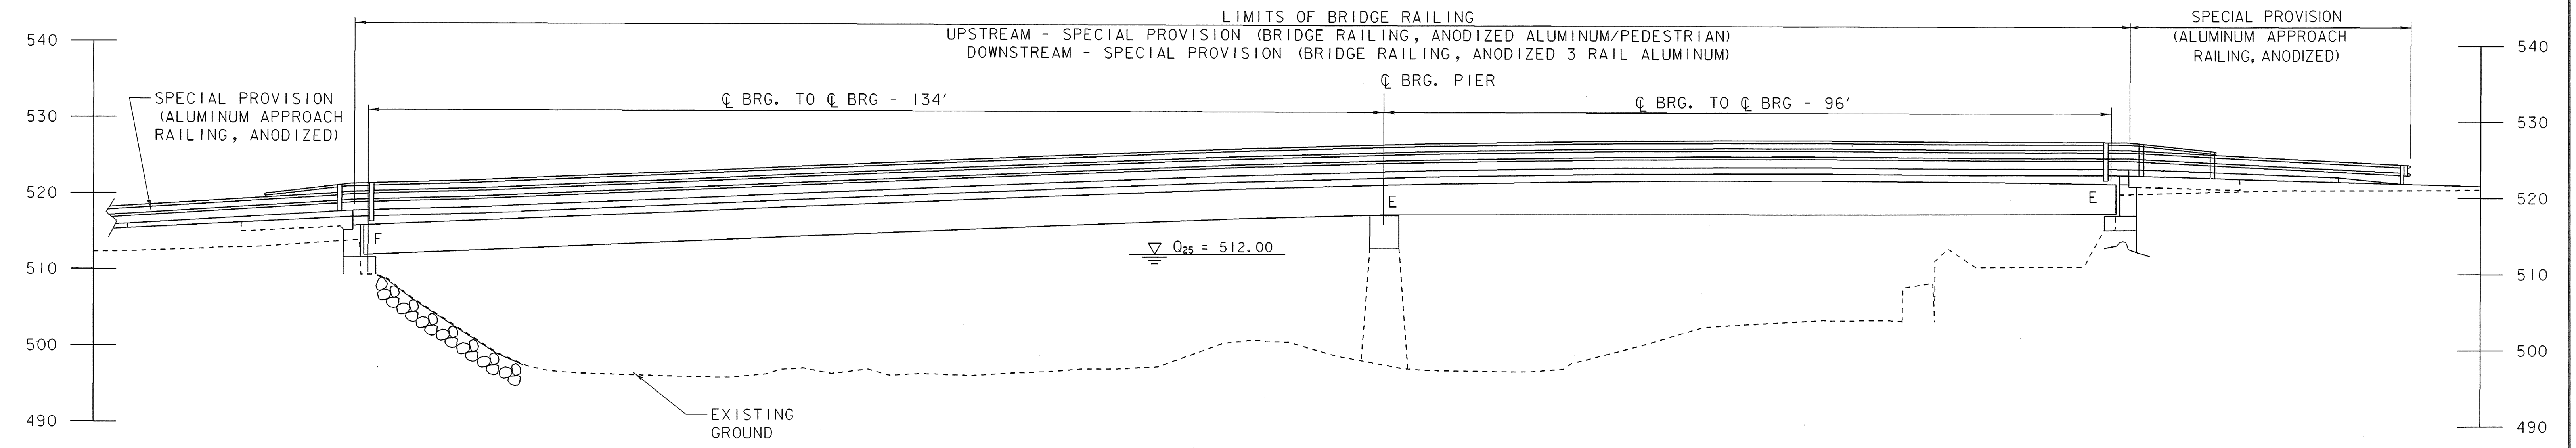

ELEVATION

SCALE 1" = 10'-0"

SHEET NAME: PLAN AND ELEVATION SHEET	
PROJECT NAME: POWNAL	HIGHWAY NO.: TH 24
PROJECT NUMBER: BRZ 144(19) C/2	BRIDGE NO.: 41
	OVER: HOOSIC RIVER
FILE NAME: 87e045/str/se045pe.dgn	PLOT DATE: 08-FEB-2008
PROJECT MANAGER: R. WHITCOMB	DRAWN BY: S.MAGNAN
DESIGNED BY: C. CARLSON	IPARM NAME: se045pe.i
	SHEET 26 OF 108