





PLAN VIEW  
TOP & BOTTOM  
(TYP)

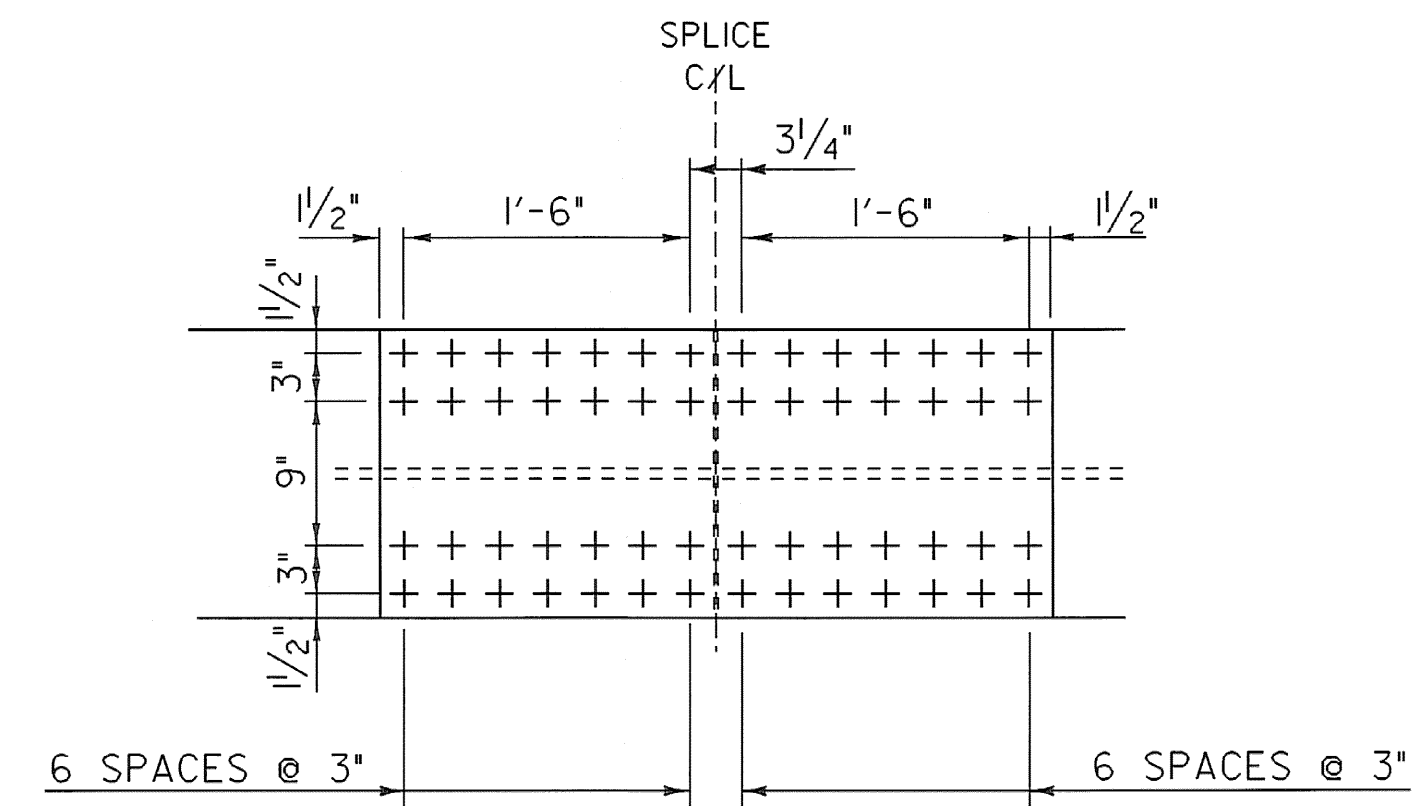


PLAN VIEW  
TOP & BOTTOM  
(TYP)

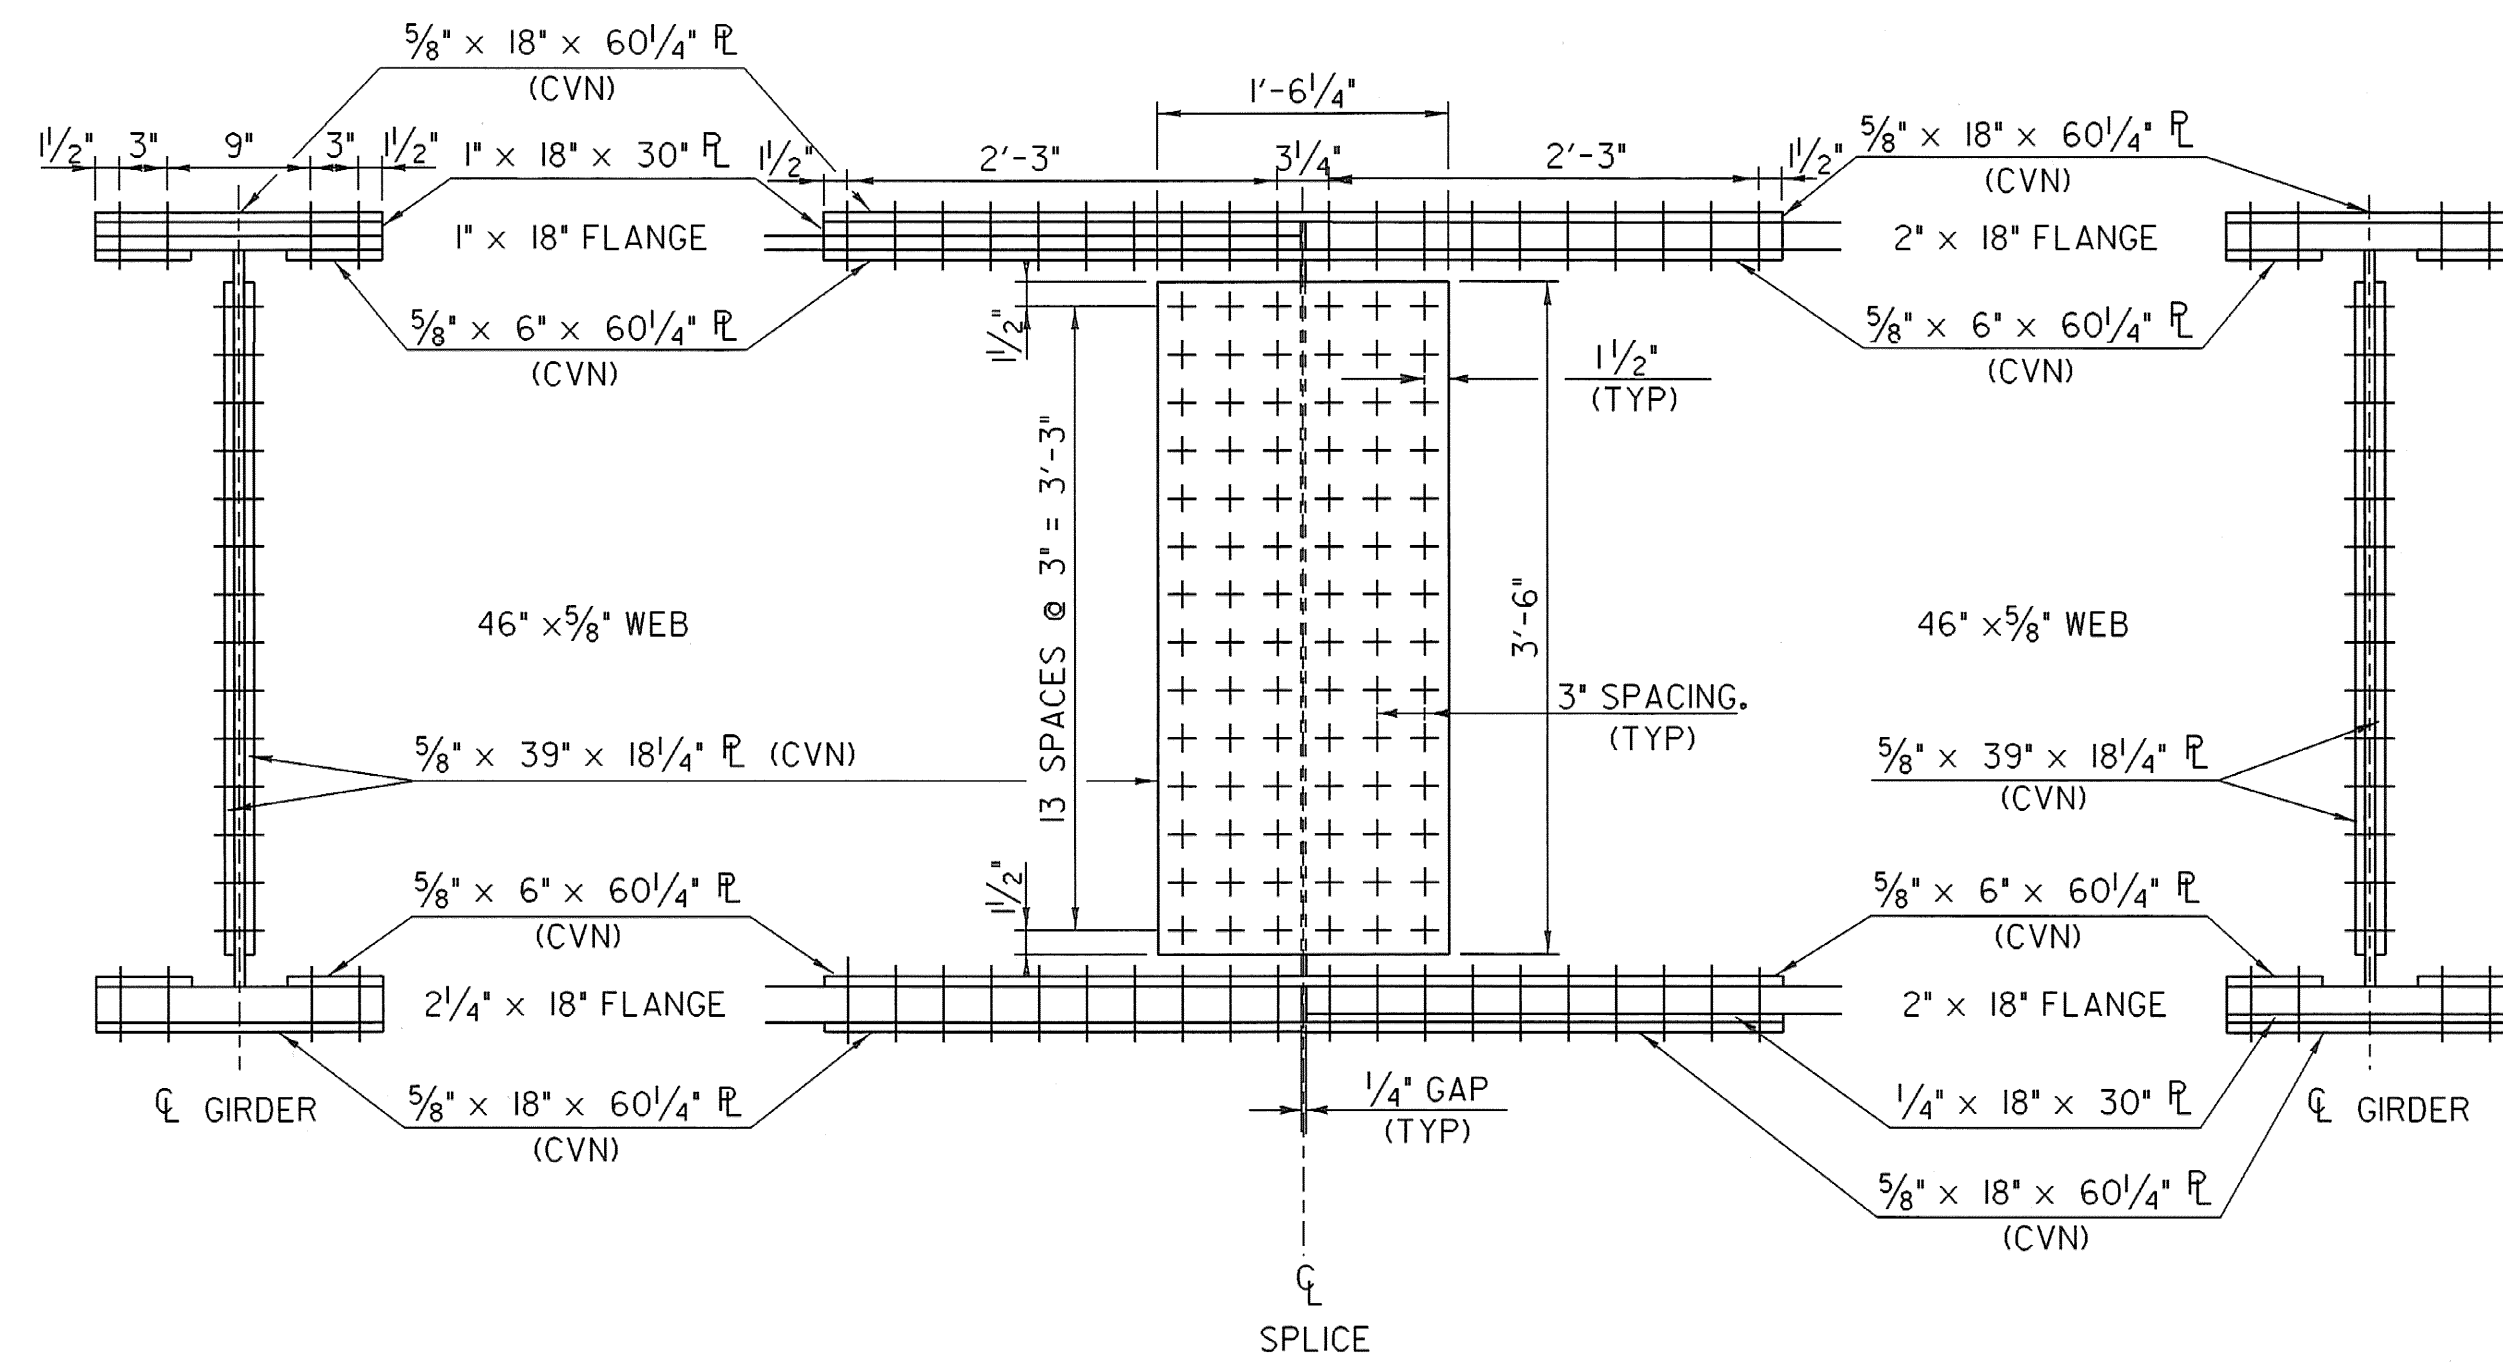

SPLICE DETAIL SPAN #1

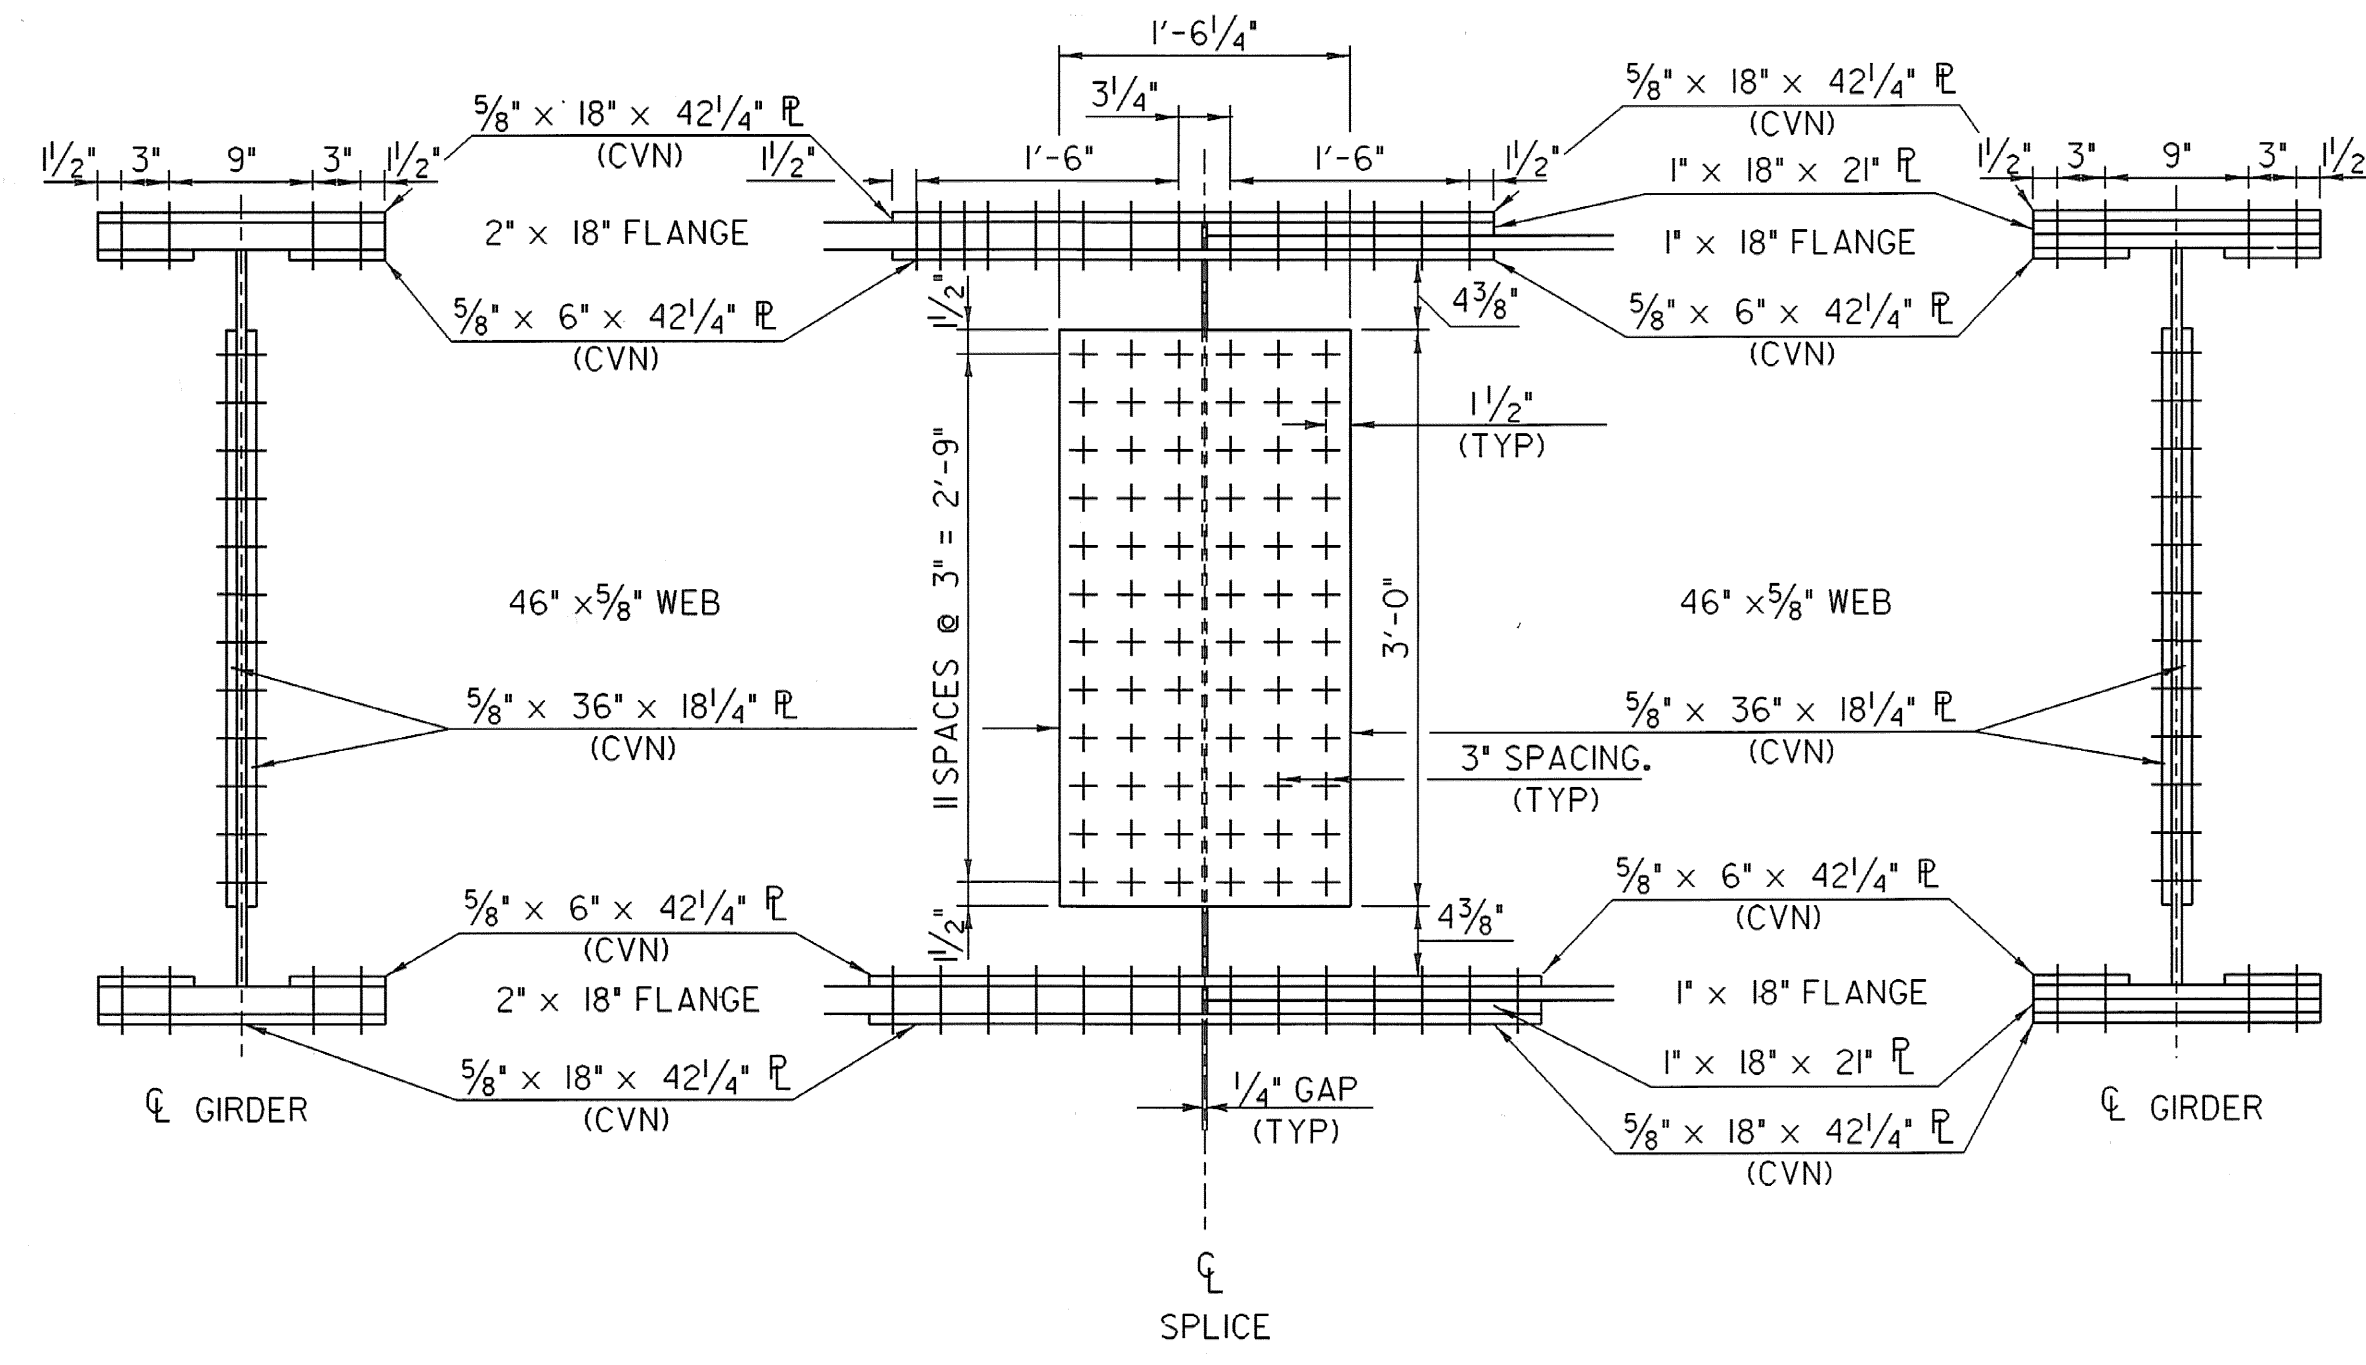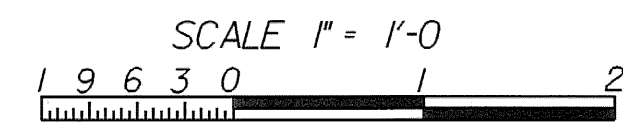

SPLICE DETAIL SPAN #2

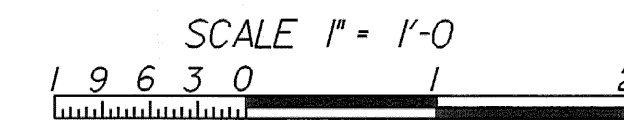

SHEET NAME: SUPERSTRUCTURE DETAILS SHEET 2	
PROJECT NAME: POWNAL	HIGHWAY NO.: TH 24
PROJECT NUMBER: BRZ 144(I9) C/2	BRIDGE NO.: 41
	OVER: HOOSIC RIVER
FILE NAME: /87e045/str/se045sup.dgn	PLOT DATE: 08-FEB-2008
PROJECT MANAGER: R. WHITCOMB	DRAWN BY: T. FILLBACH
DESIGNED BY: T. FILLBACH/C. CARLSON	IPARM NAME: se045sup4.i
	SHEET 41 OF 108