



STA 14+01.22 LT.
END STRUCTURE EXCAVATION AND
GRANULAR BACKFILL FOR STRUCTURES

14+00

STA 13+99.57 RT.
END STRUCTURE EXCAVATION AND
GRANULAR BACKFILL FOR STRUCTURES

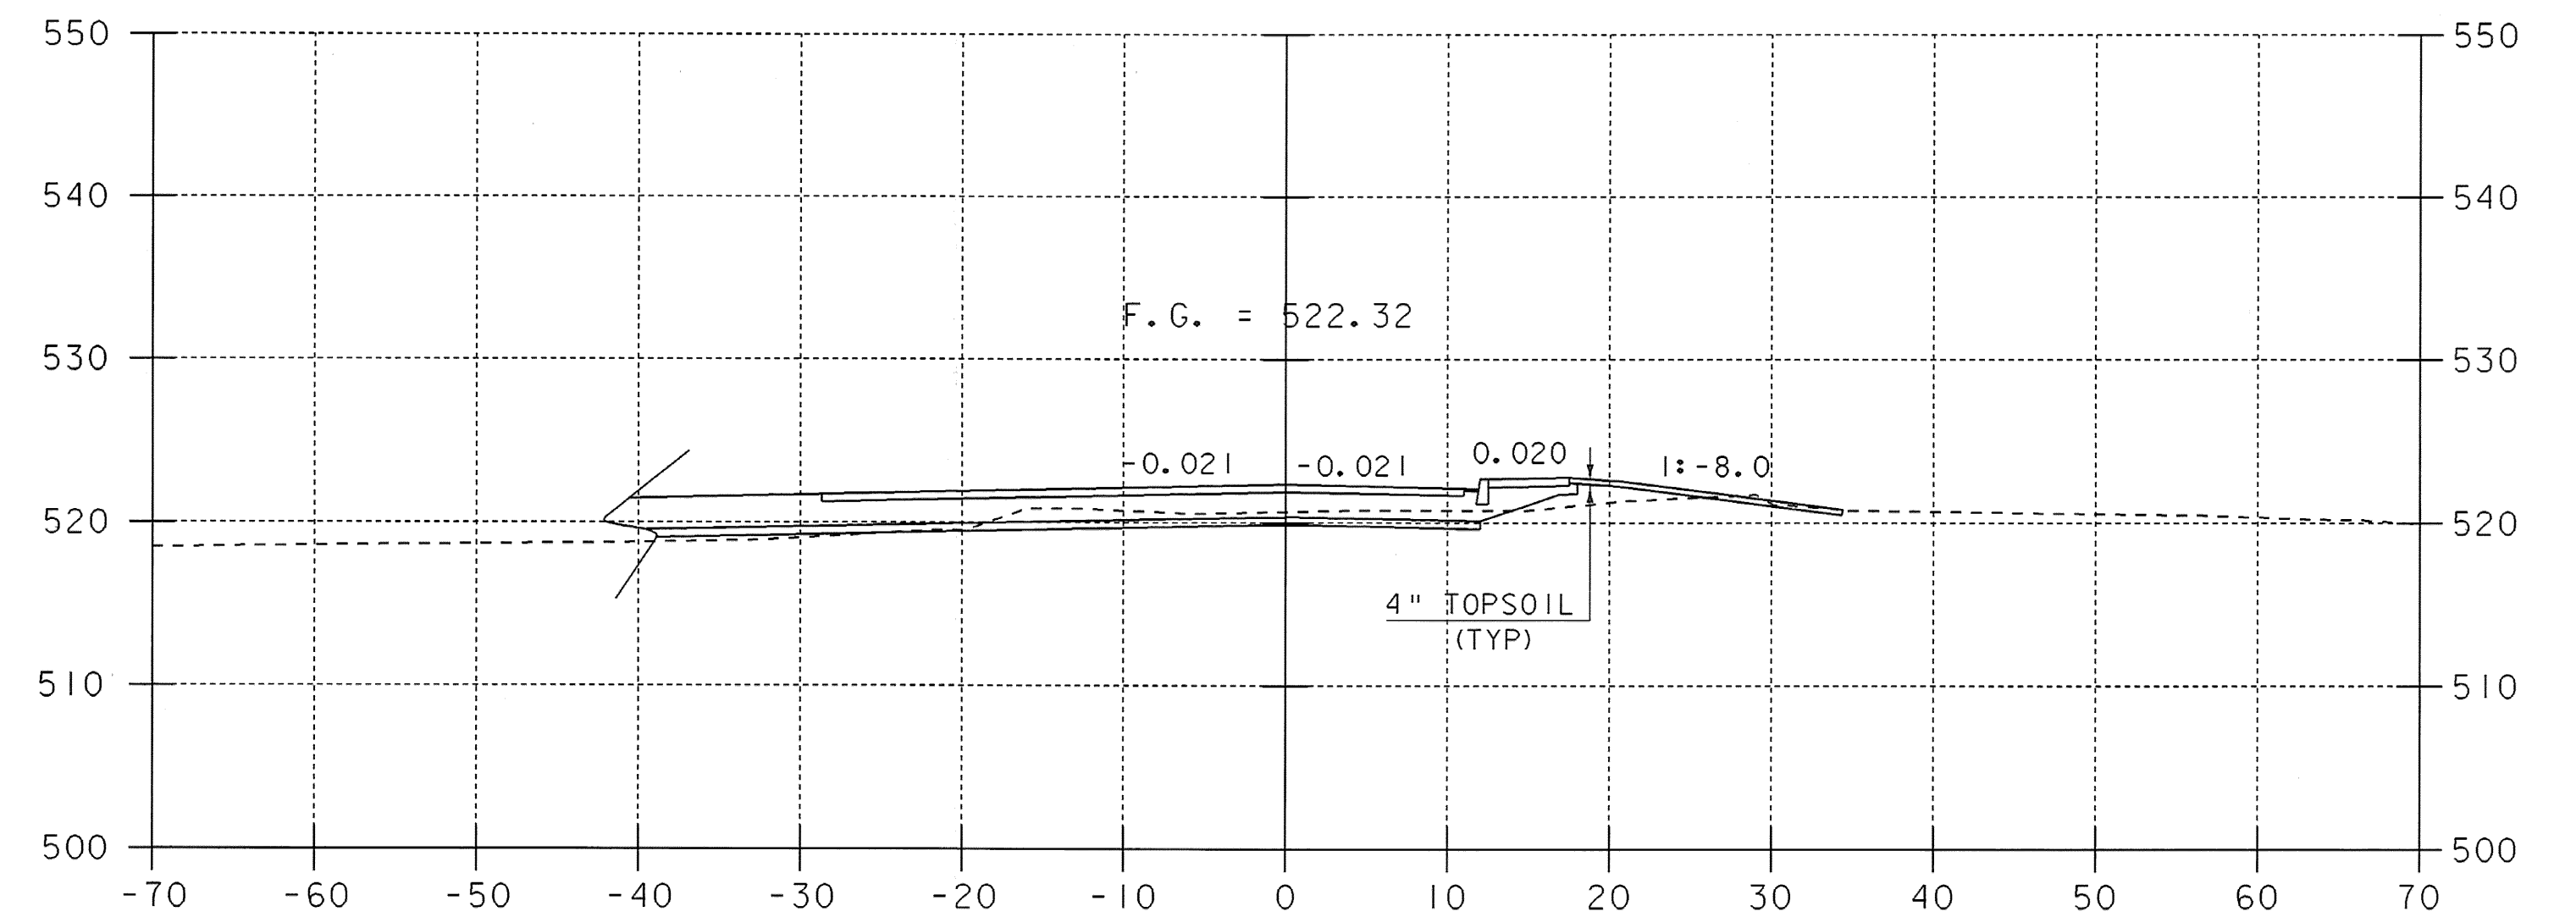

14+15

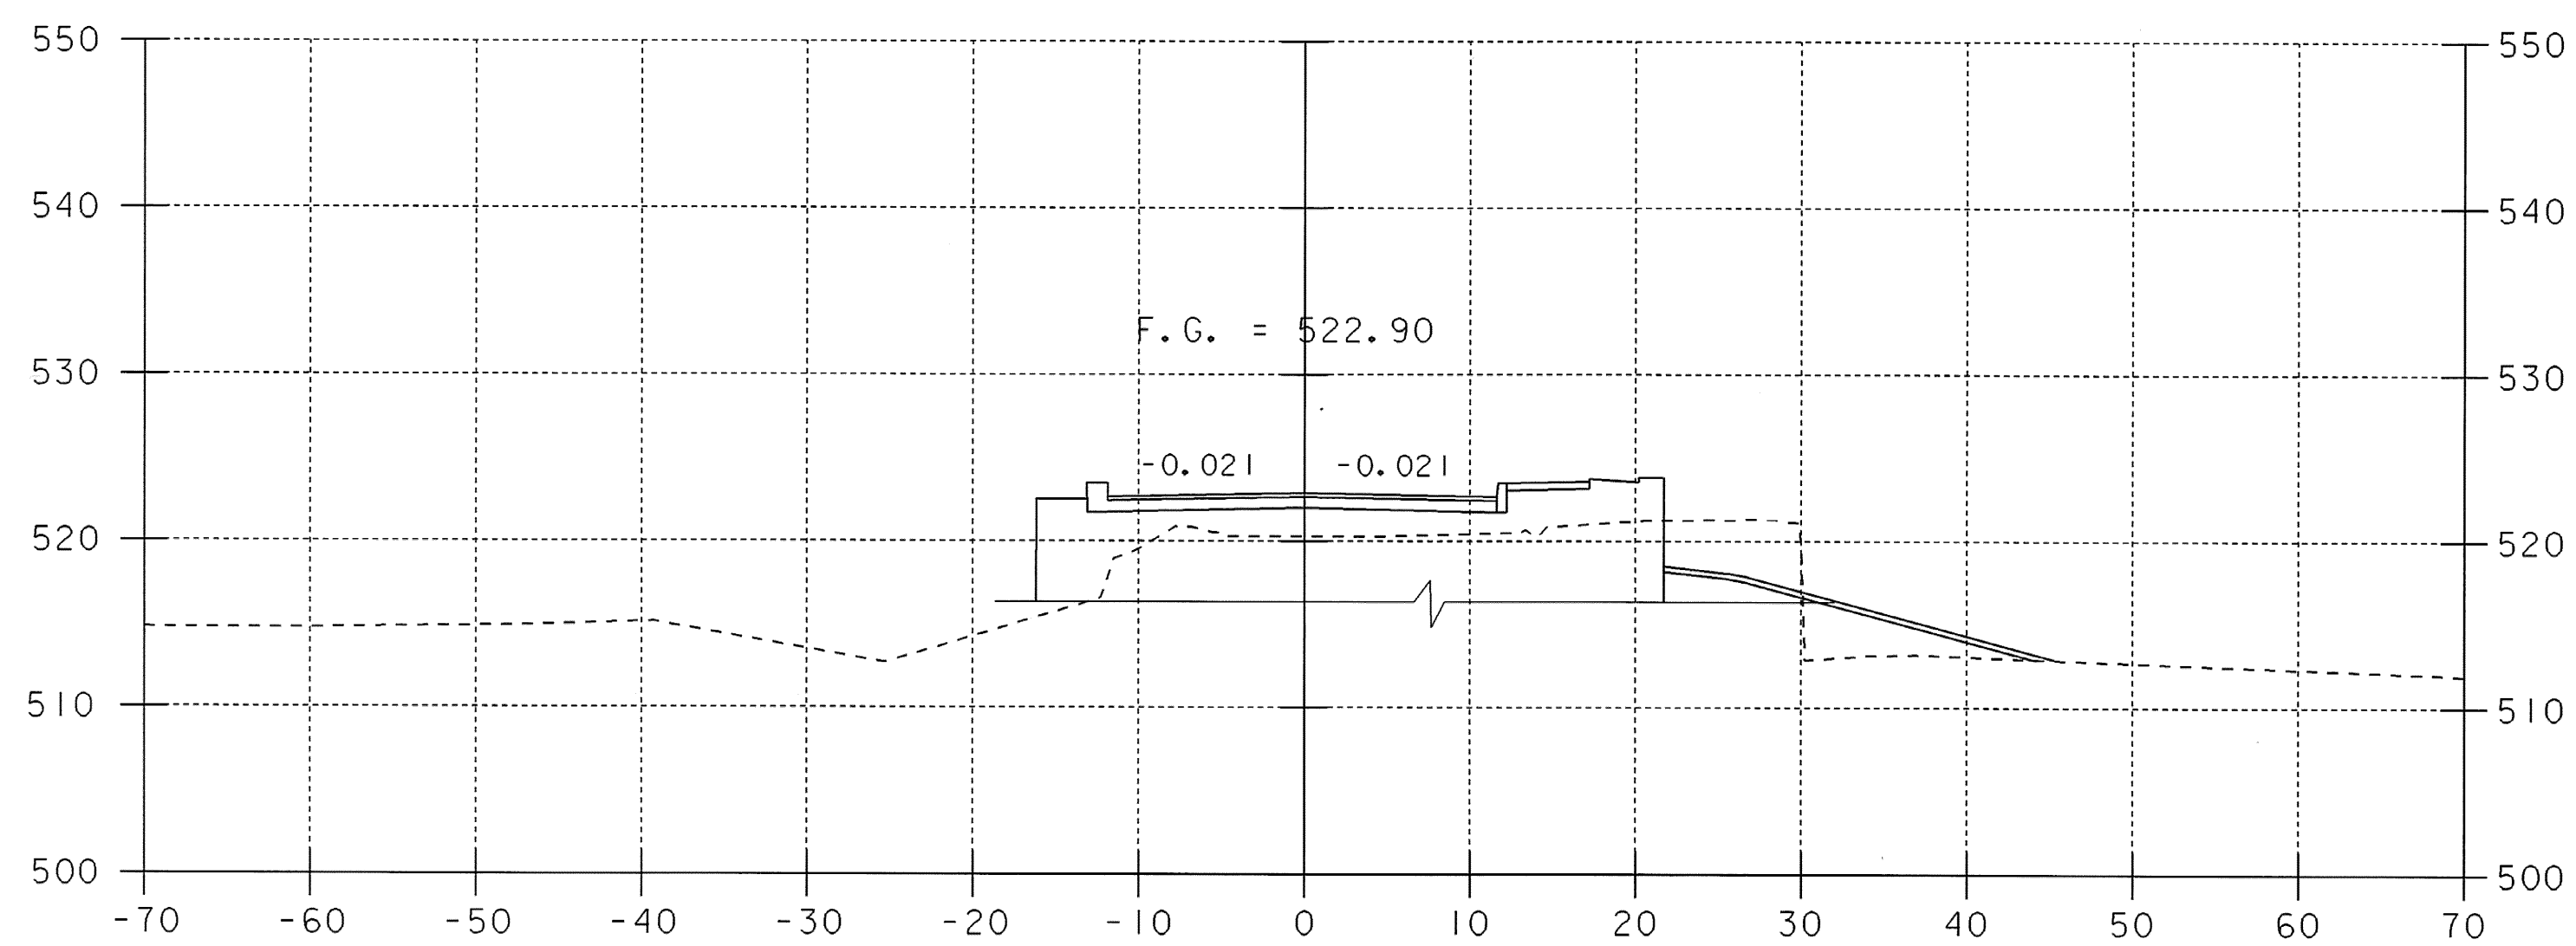


STA 13+87.34 LT.
BEGIN STRUCTURE EXCAVATION AND
GRANULAR BACKFILL FOR STRUCTURES

13+91.87
END BRIDGE

STA. 13+91.87 RT.
BEGIN CAST-IN-PLACE CONCRETE CURB, TYPE B
BEGIN PORTLAND CEMENT CONCRETE SIDEWALK, 5 INCH

STA 13+87.40 RT.
BEGIN STRUCTURE EXCAVATION AND
GRANULAR BACKFILL FOR STRUCTURES

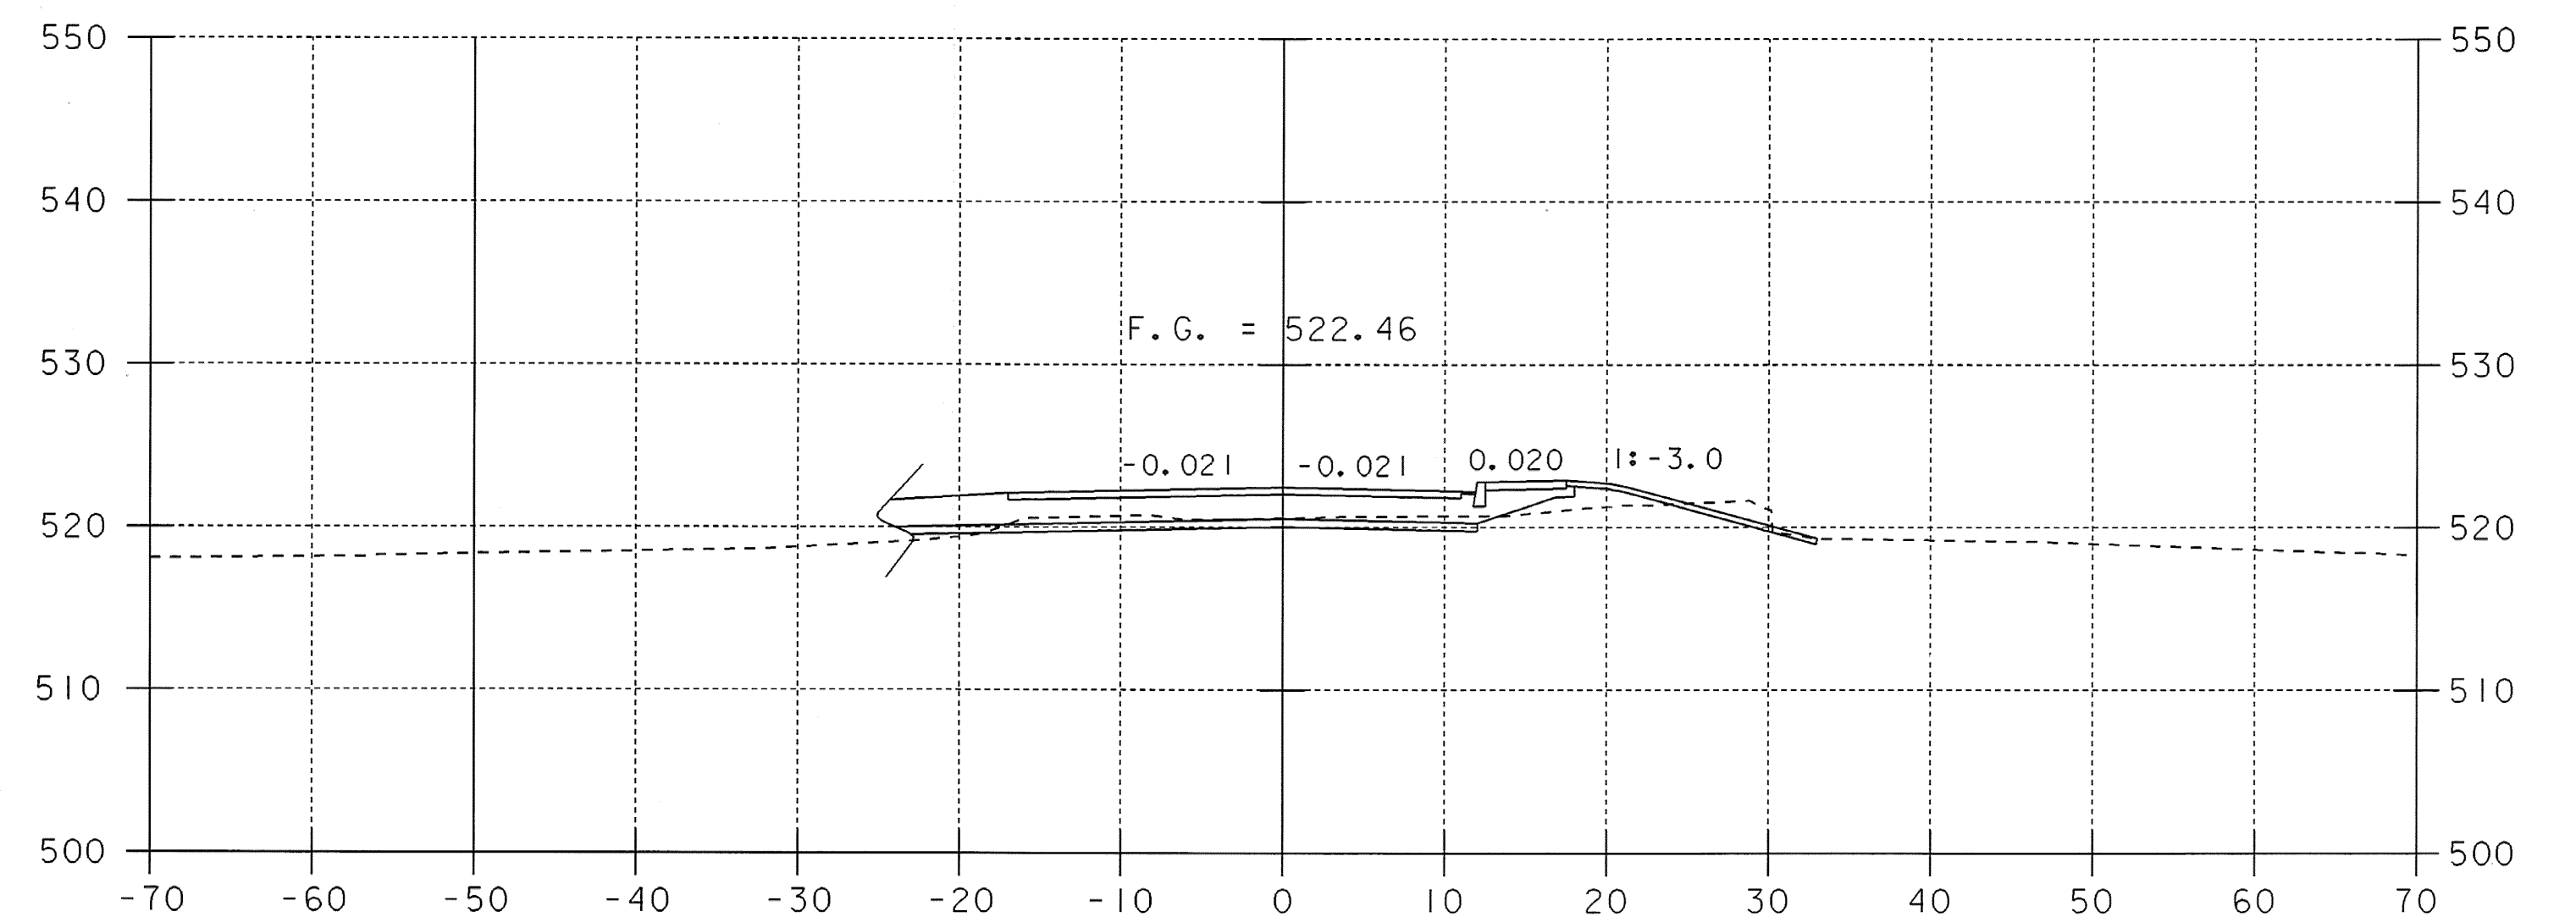

14+10

SCALE 1" = 10'-0"

SHEET NAME: MAINLINE CROSS SECTIONS	
PROJECT NAME: POWNAL	HIGHWAY NO.: TH 24
PROJECT NUMBER: BRZ 1441(19) C/2	BRIDGE NO.: 41
	OVER: HOOSIC RIVER
FILE NAME: 87e045/str/se045xs2.dgn	PLOT DATE: 08-FEB-2008
PROJECT MANAGER: R. WHITCOMB	DRAWN BY: J.GILMORE
DESIGNED BY: C. CARLSON	IPARM NAME: se045mx5.1
	SHEET 71 OF 108