
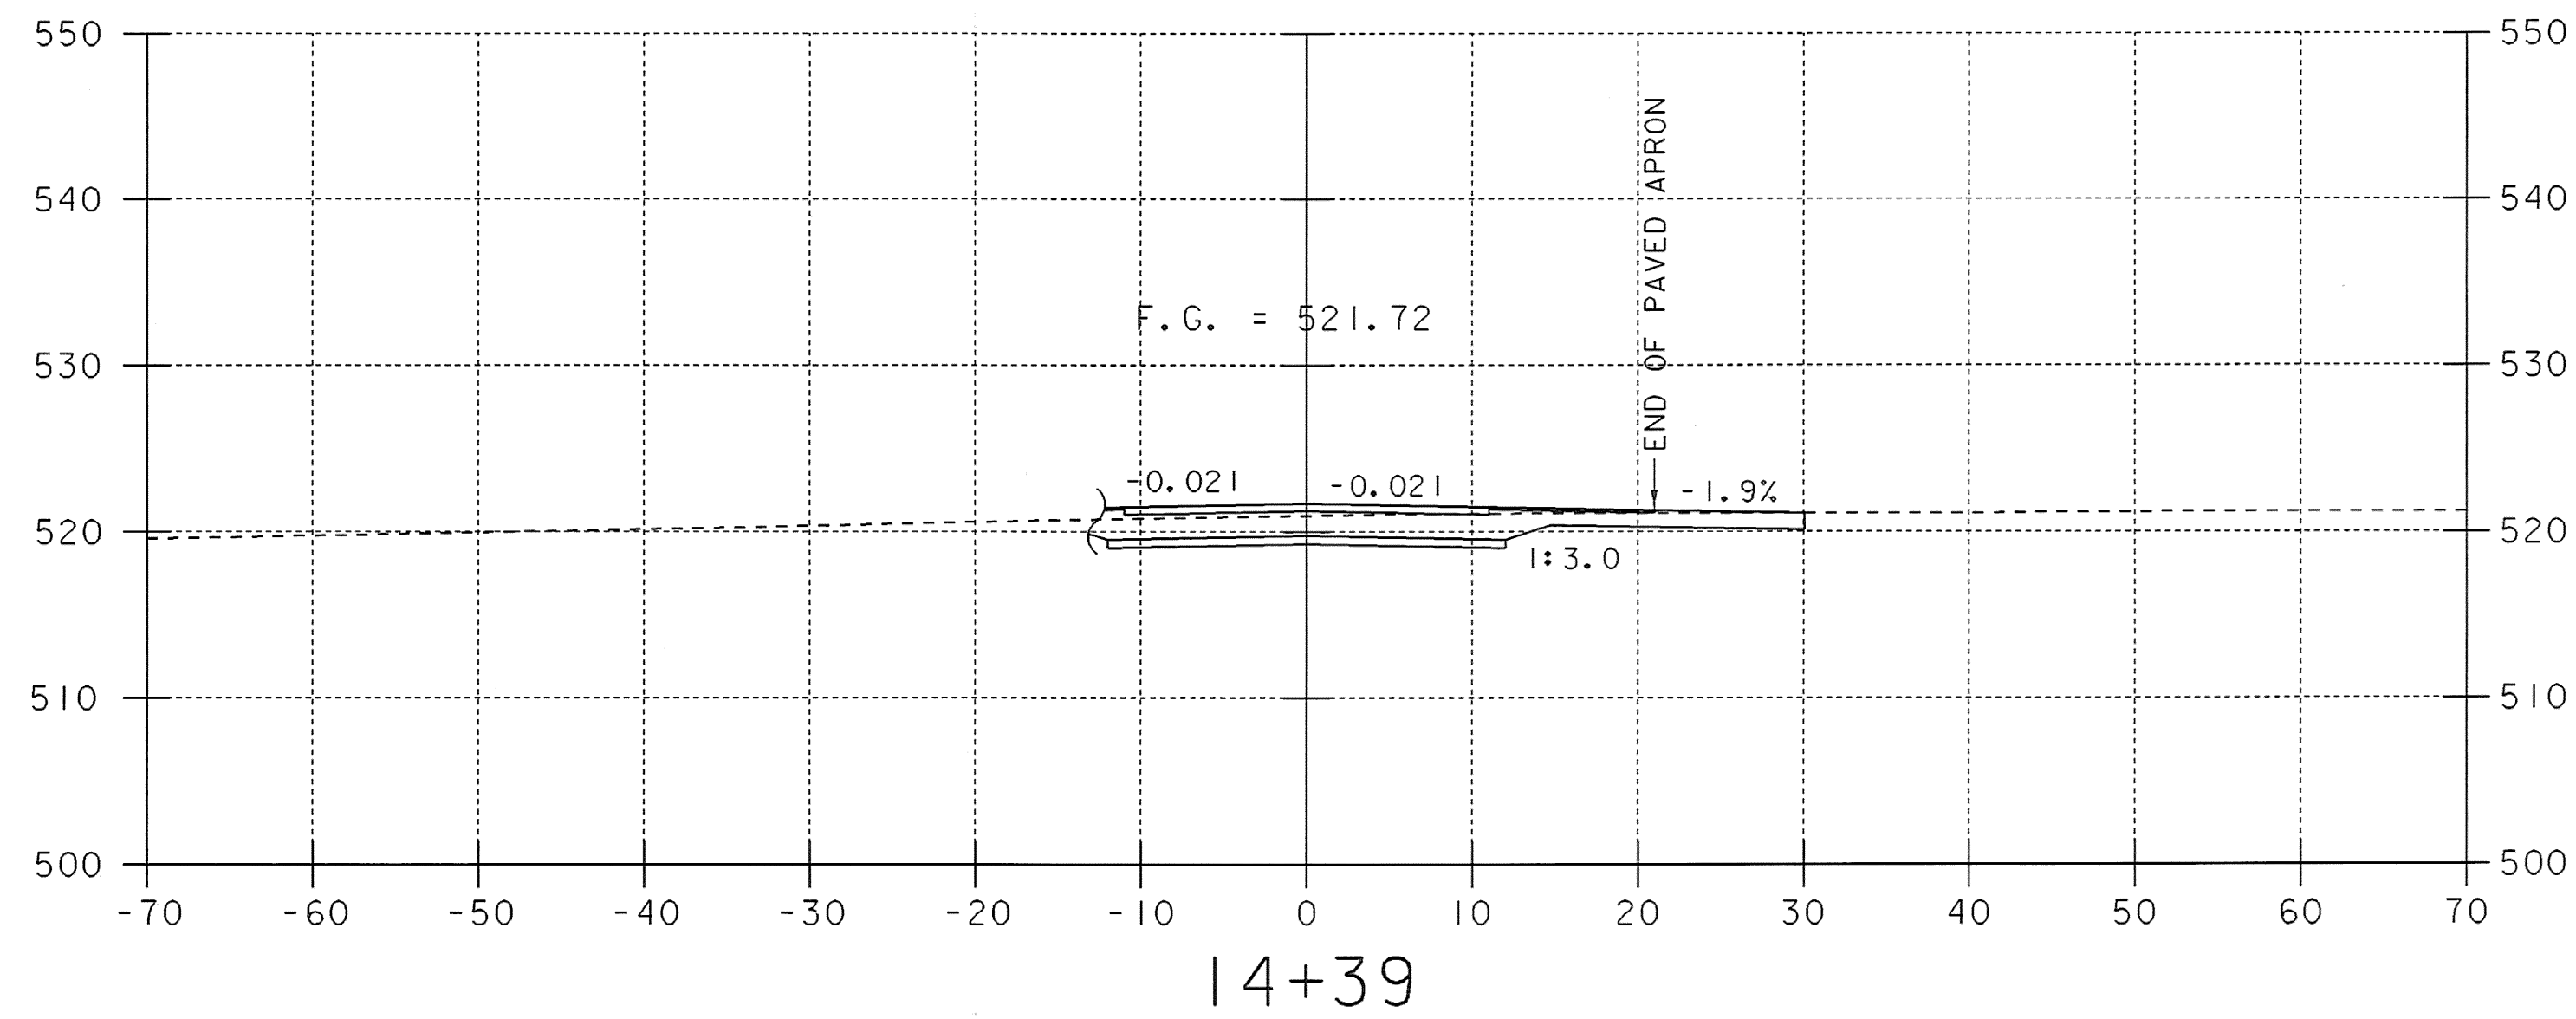
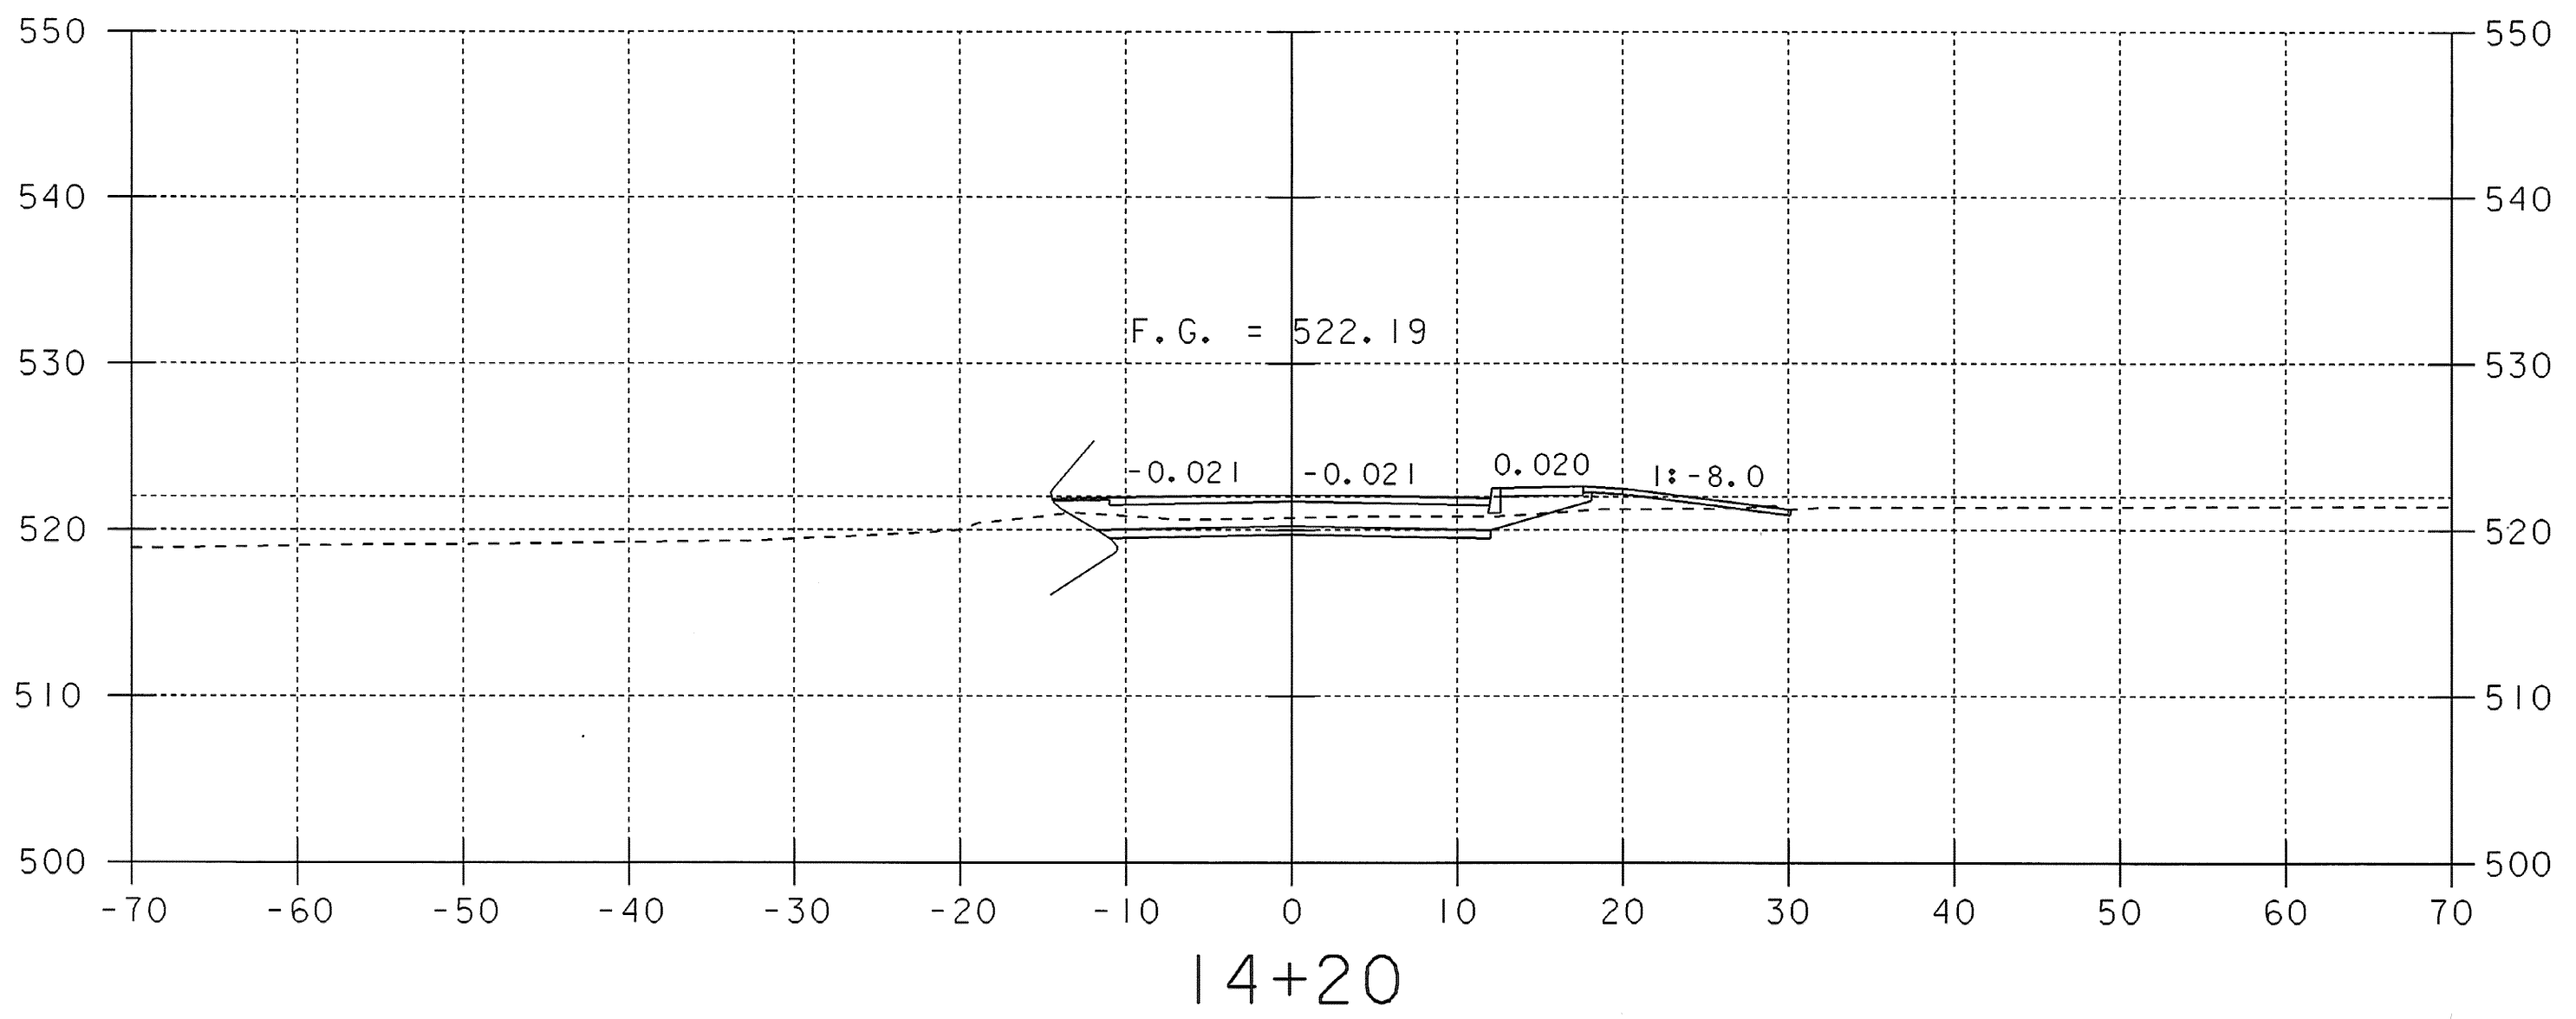
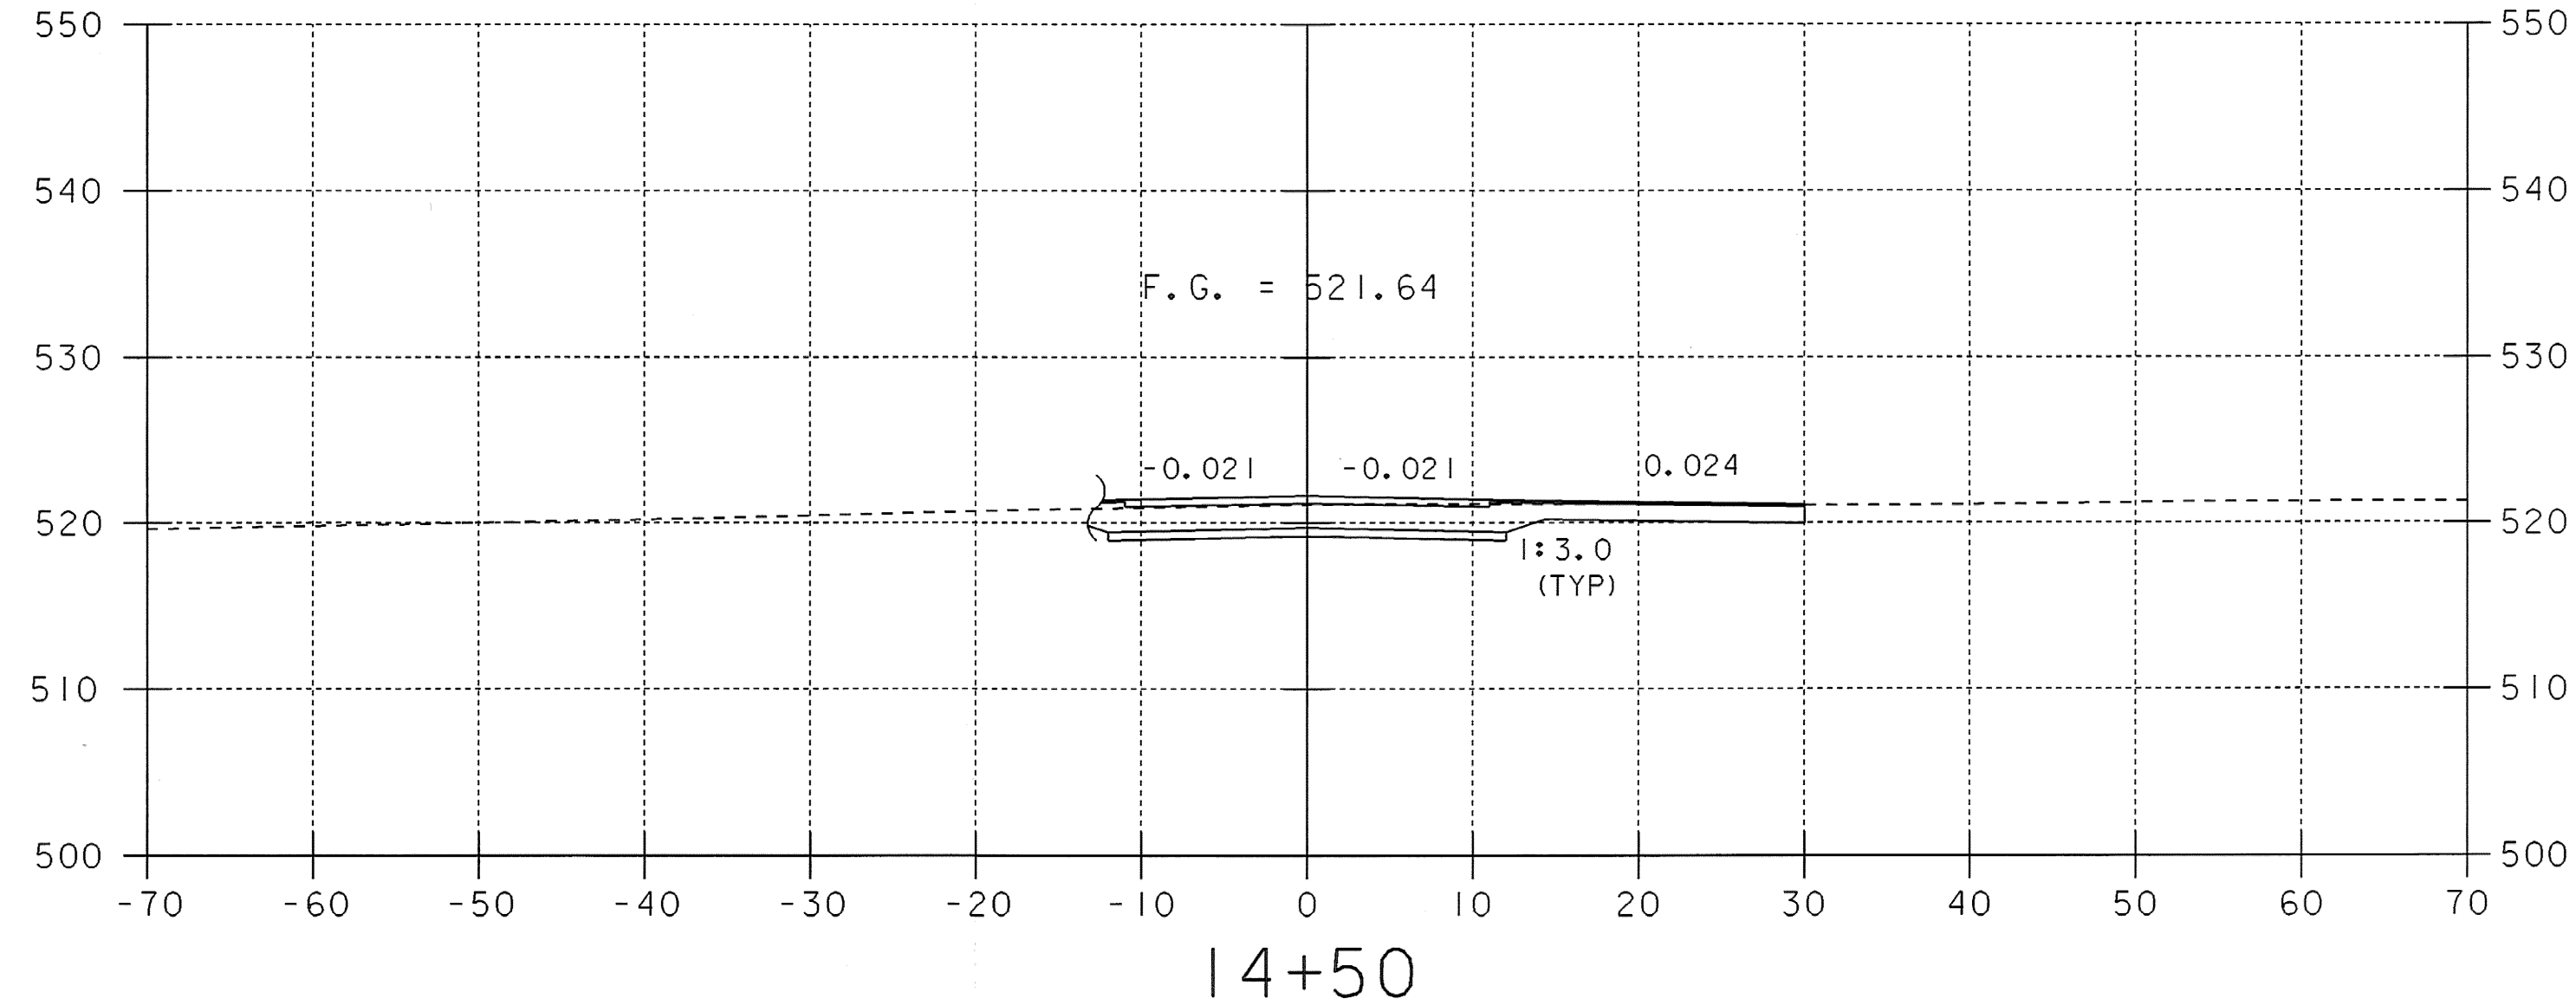



SEE SHEET 83 FOR  
 WWTF SIDELINE APPROACH NEAR  
 RR TRACKS

STA. 14+28.00 RT.  
 END PORTLAND CEMENT CONCRETE SIDEWALK, 5 INCH

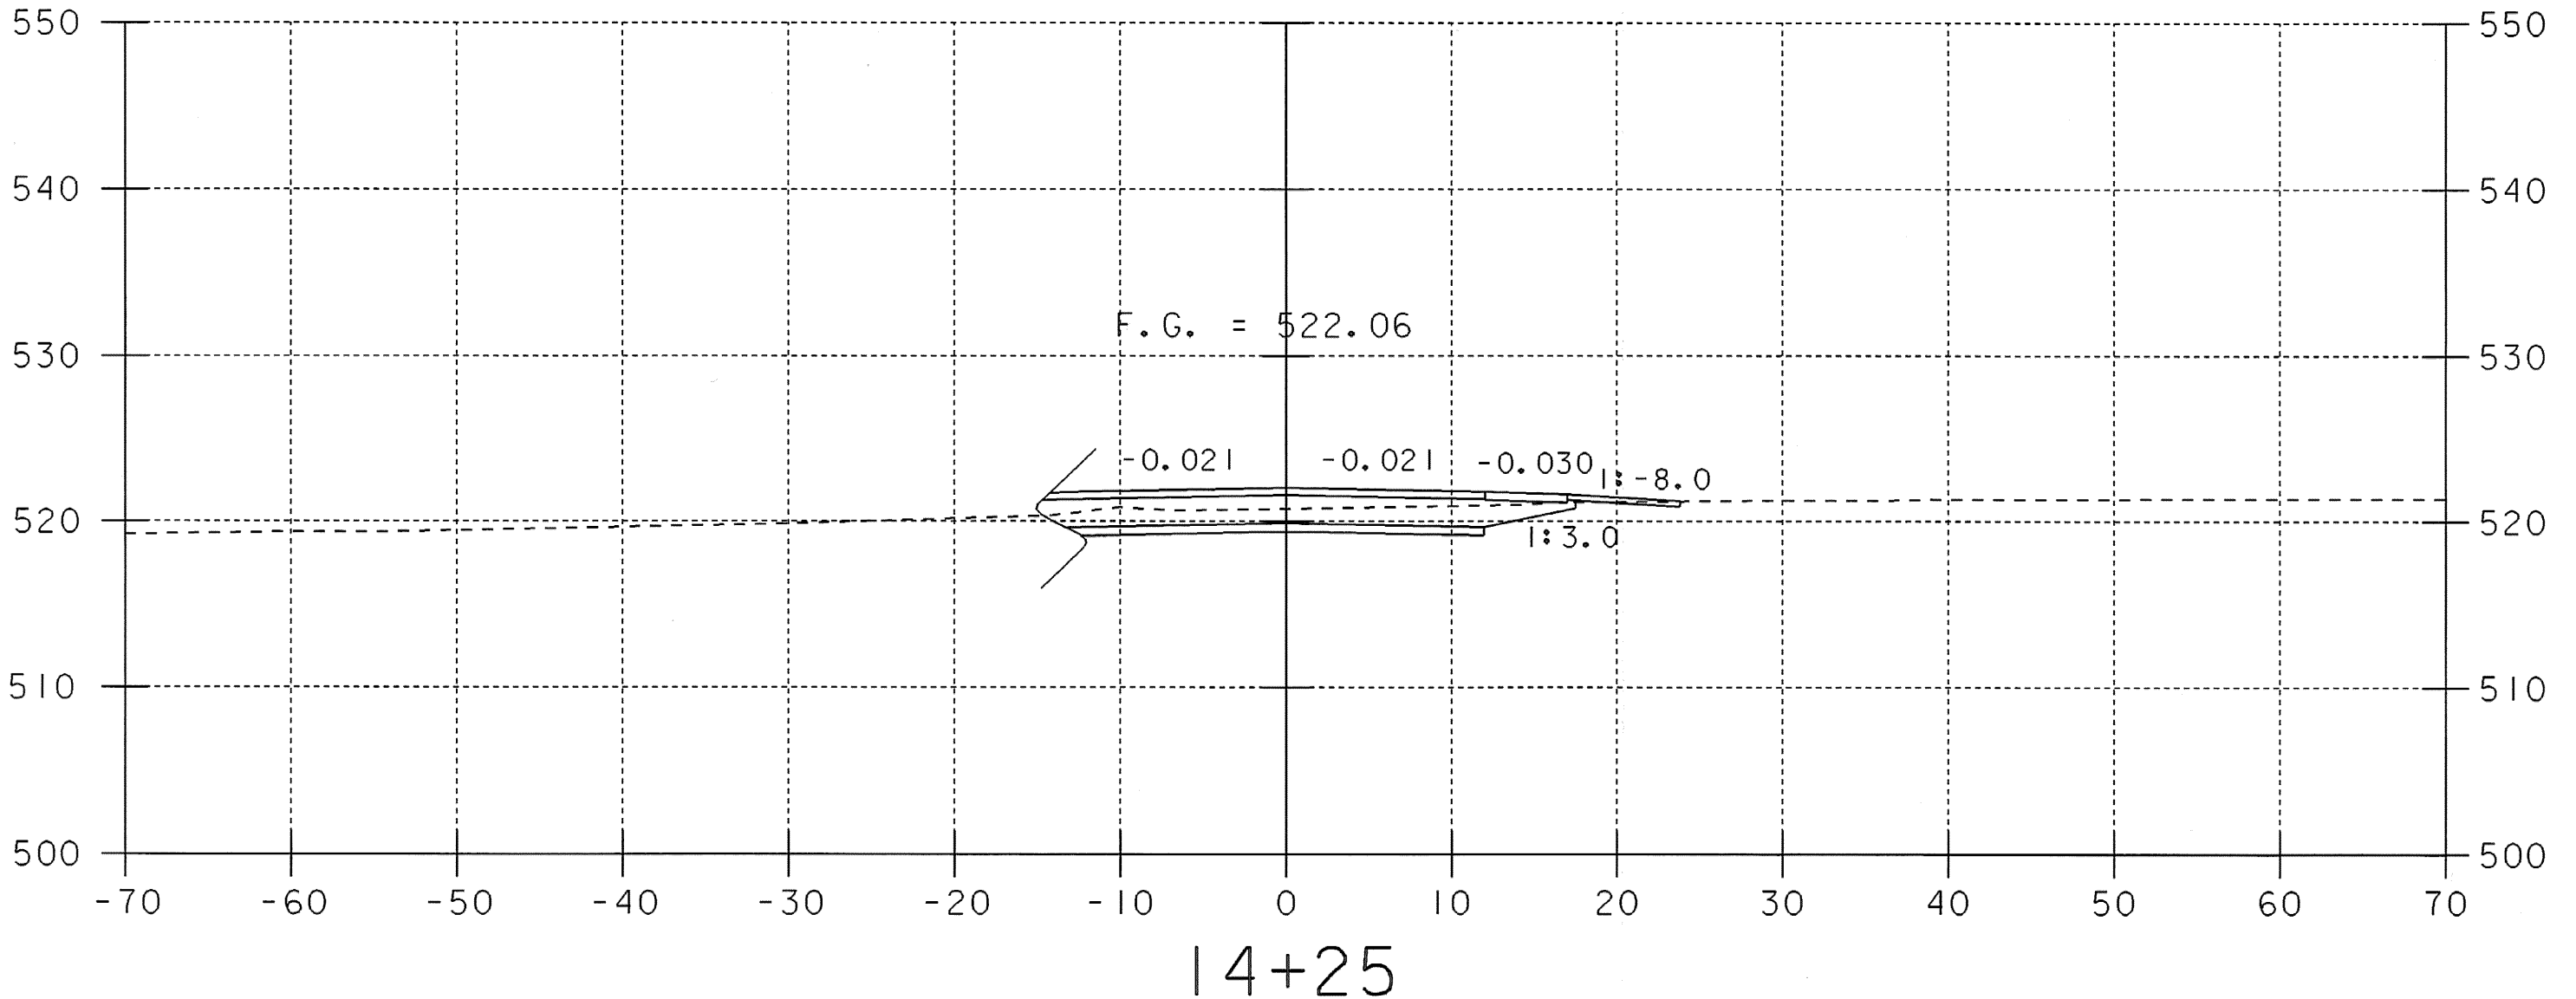

STA. 14+20.00 RT.  
 END CAST-IN-PLACE CONCRETE CURB, TYPE B

14+39  
 DRIVE RIGHT

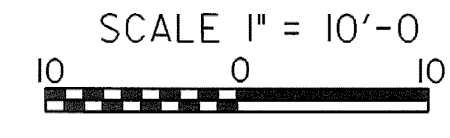

SHEET NAME: MAINLINE CROSS SECTIONS	
PROJECT NAME: POWNAL	HIGHWAY NO.: TH 24
PROJECT NUMBER: BRZ 144(19) C/2	BRIDGE NO.: 41
	OVER: HOOSIC RIVER
FILE NAME: 87e045/str/se045xs2.dgn	PLOT DATE: 08-FEB-2008
PROJECT MANAGER: R. WHITCOMB	DRAWN BY: J.GILMORE
DESIGNED BY: C. CARLSON	IPARM NAME: se045mx6.i
	SHEET 72 OF 108