


2+00
PROFILE ALONG DRIVE #1 RIGHT

2+25
PROFILE ALONG DRIVE #2 RIGHT

TH 25 STA 1+85.14 =
TH 26 7+00.00
SEE SHEETS 79-82

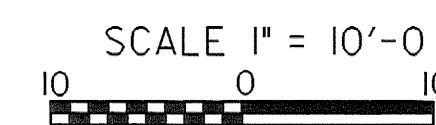

SNAKE HILL ROAD

SHEET NAME: TOWN HIGHWAY 25 CROSS SECTIONS	
PROJECT NAME: POWNAL	HIGHWAY NO.: TH 24
PROJECT NUMBER: BRZ 144(19) C/2	BRIDGE NO.: 41
	OVER: HOOSIC RIVER
FILE NAME: 87e045/str/se045xs2.dgn	PLOT DATE: 08-FEB-2008
PROJECT MANAGER: R. WHITCOMB	DRAWN BY: J.GILMORE
DESIGNED BY: C. CARLSON	IPARM NAME: se045sx2.1
	SHEET 77 OF 108