


STA. 4+55.00
 BEGIN UNCLASSIFIED CHANNEL EXCAVATION,
 GRUBBING MATERIAL, GEOTEXTILE UNDER STONE FILL
 AND STONE FILL, TYPE II

4+60

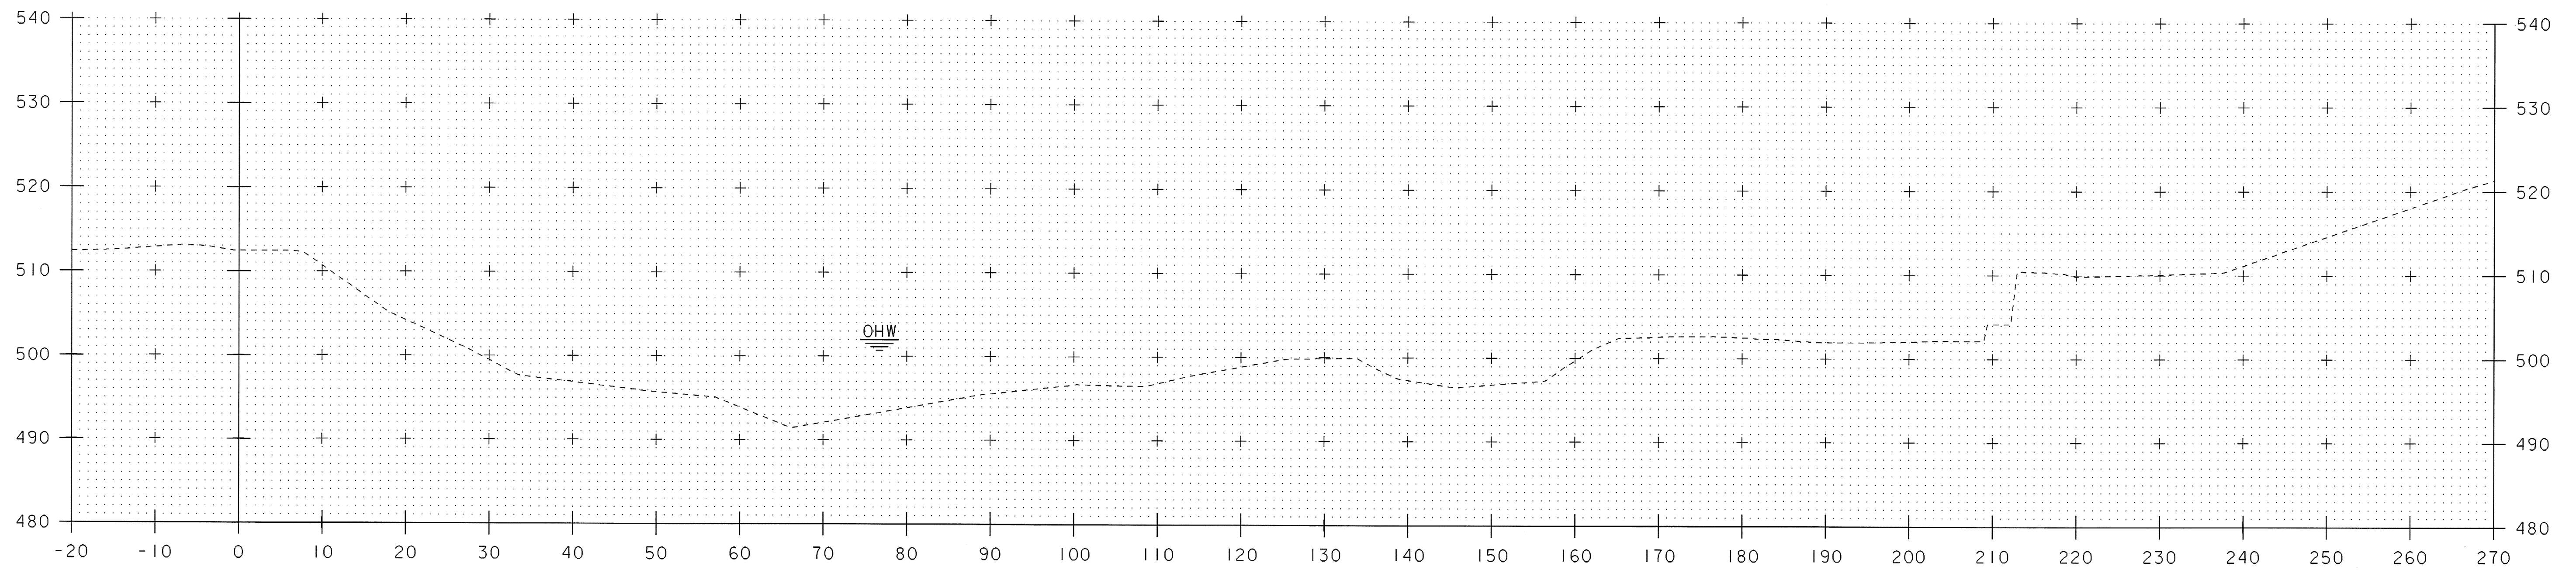

4+50

CHANNEL CROSS SECTIONS

PROJECT NAME:	POWNAI	PLOT DATE:	08-FEB-2008
PROJECT NUMBER:	BRZ 144(I9) C/2	DRAWN BY:	STR3
FILE NAME:	/87e045/str/se045xs2.dgn	CHECKED BY:	C. CARLSON
PROJECT LEADER:	R. WHITCOMB	SHEET	84 OF 108
DESIGNED BY:	C. CARLSON		
se045cx1.1			