


STA. 4+86.00  
END GRUBBING MATERIAL

4+90

STA. 4+80.9 RT.  
BEGIN STRUCTURE EXCAVATION AND GRANULAR BACKFILL FOR STRUCTURES

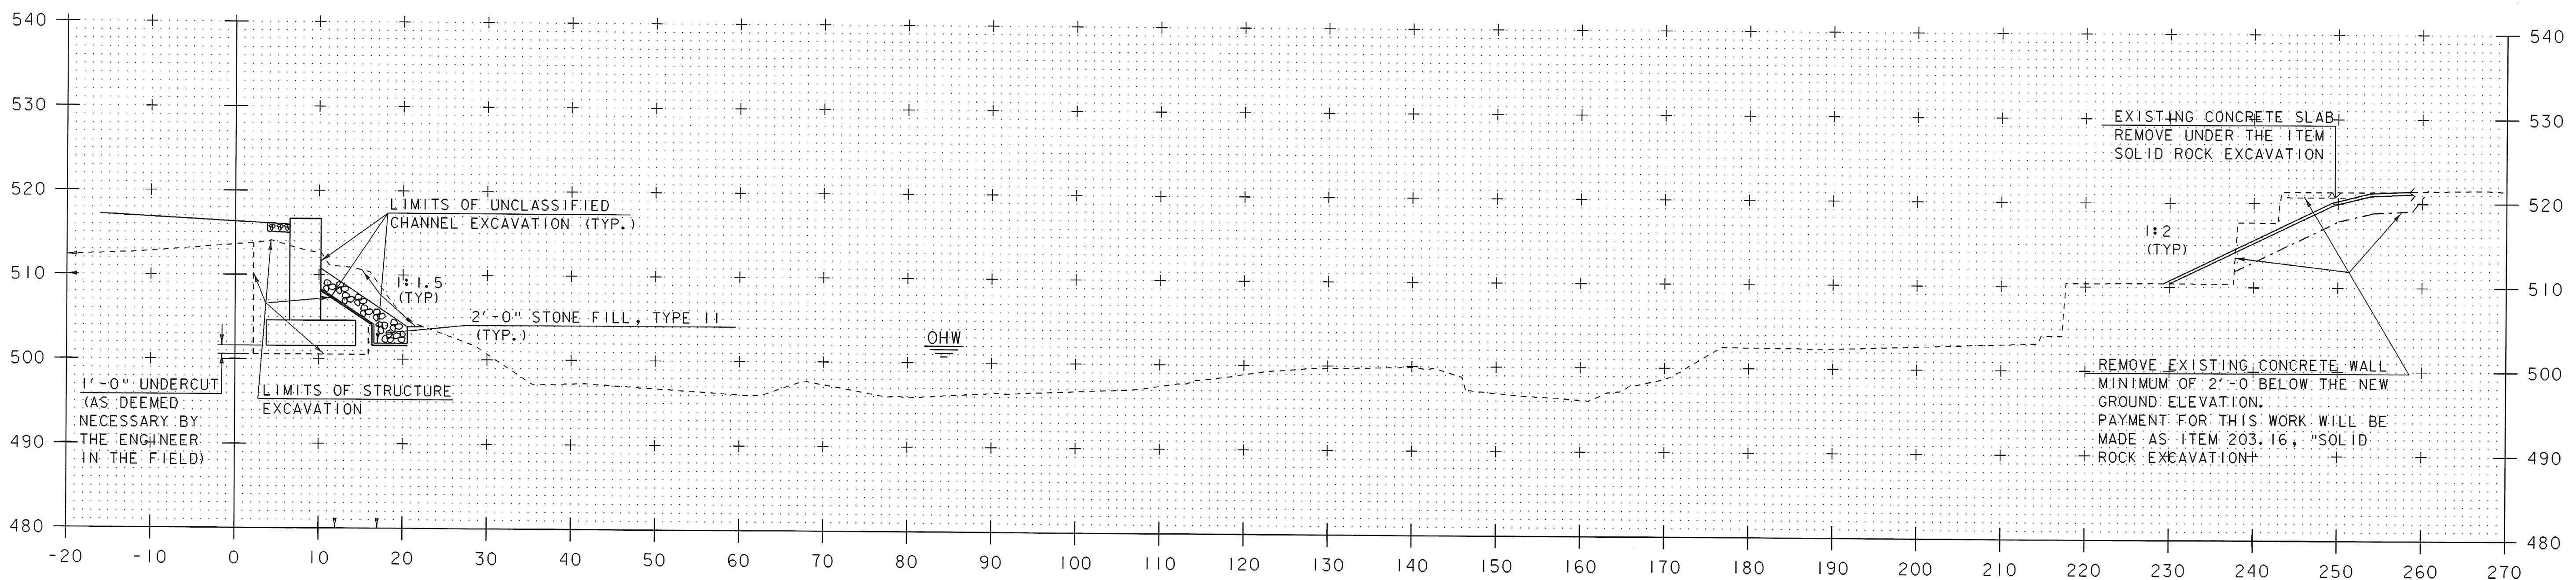

4+80

CHANNEL SECTIONS

PROJECT NAME:	POWNAI	PLOT DATE:	08-FEB-2008
PROJECT NUMBER:	BRZ 1441(19) C/2	DRAWN BY:	STR3
FILE NAME:	/87e045/str/se045xs2.dgn	CHECKED BY:	C. CARLSON
PROJECT LEADER:	R. WHITCOMB	SHEET	86 OF 108
DESIGNED BY:	C. CARLSON		
se045cx3.i			