


5+10

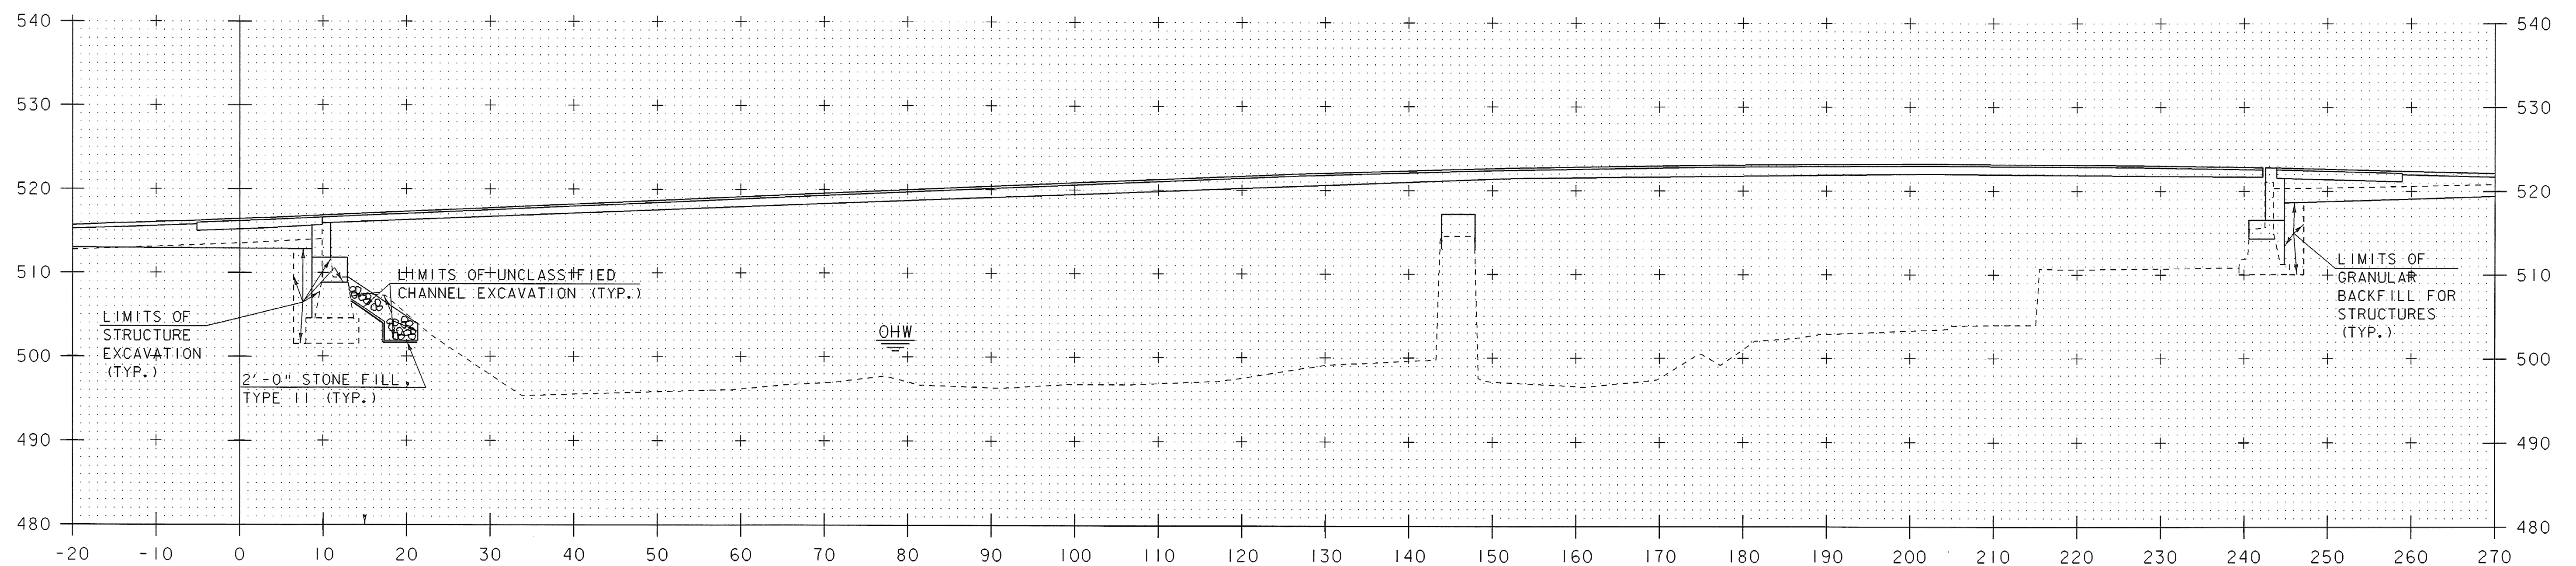

5+00

CHANNEL CROSS SECTIONS

PROJECT NAME:	POWNA	PLOT DATE:	08-FEB-2008
PROJECT NUMBER:	BRZ 1441(19) C/2	DRAWN BY:	STR3
FILE NAME:	/87e045/str/se045xs2.dgn	CHECKED BY:	C. CARLSON
PROJECT LEADER:	R. WHITCOMB	SHEET	87 OF 108
DESIGNED BY:	C. CARLSON		