

drawing 18. a


General Arrangement Showing  
 2 Span Mabe Compact 200  
 (13 : 13 Bays) Top P'n Out  
 EW (13.7') Roadwidth with  
 Epoxy Ant Skid Coated Decks  
 HS-20 Live loading

POWNAL  
 BRZ 144(19) C/2  
 REFERENCE SHEET 12 OF 18  
 SHEET 102 OF 108

client	Patriaca		
dwg. no.	cmh\67\24-01	file	cmh\67\24-01.dwg
drawn by	<i>Q.S.</i>	date	4/25/97
checked by	<i>C. Mabe</i>	date	4/25/97
revision		sheet	1 of 2
		scale	do not scale

Rev.	by	date	details

1:10 PM 4/25/97 14:36:30 1007

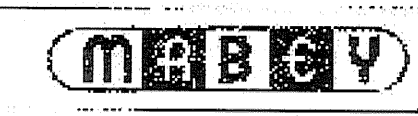

M A B E Y B R I D G E A N D S H O R E I N C

6770 DORSEY RD. BALTIMORE, MD. 21227 TEL : 410 379 2800  
 FAX : 410 379 2801

MABEY BRIDGE & SHORE INC TEL 410-379-2800 FAX 410-379-2801