


PROPOSED IMPROVEMENT BRIDGE PROJECT

PREPARED FOR


PETRICCA CONSTRUCTION CO.

MAY 1997

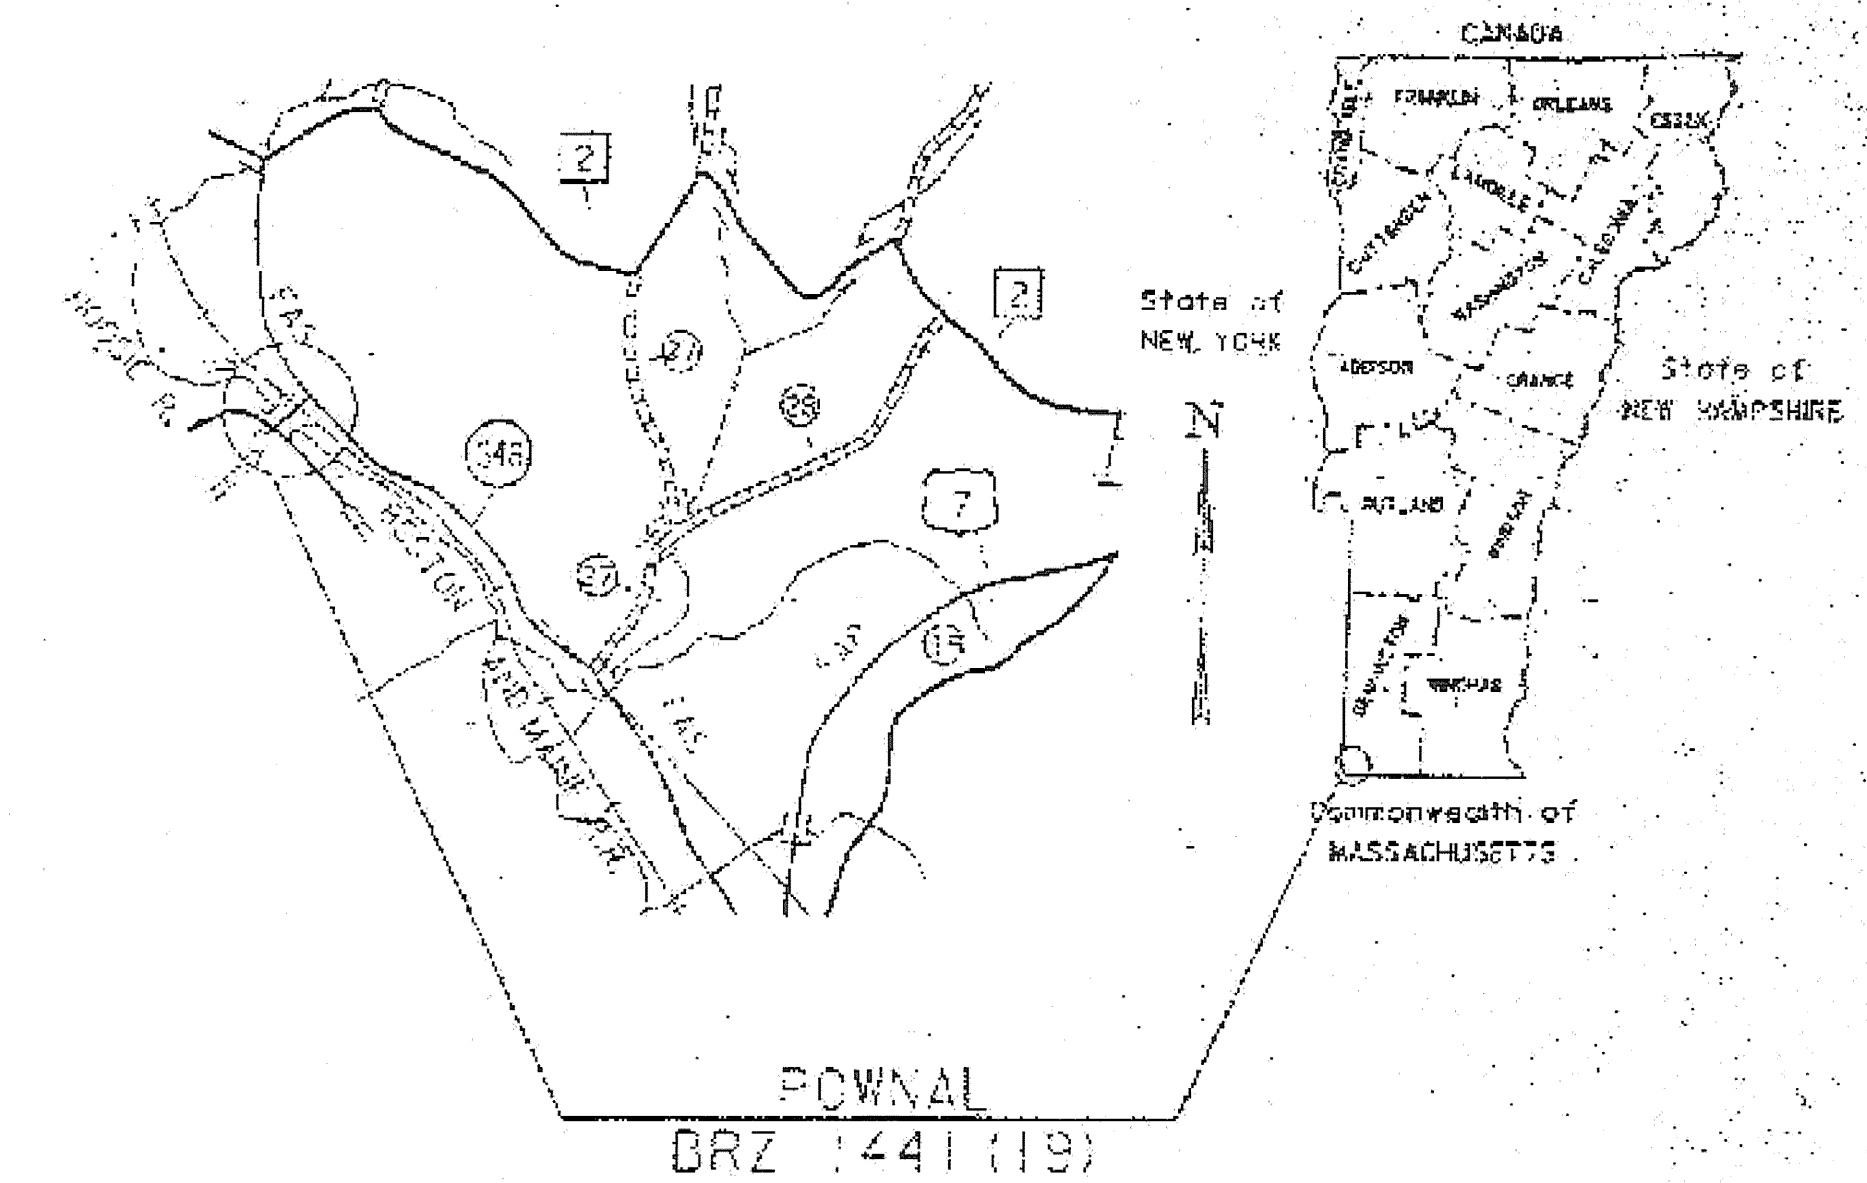

LOCUS PLAN

TOWN OF POWNAL
COUNTY OF BENNINGTON
ROUTE NO: TH 24.CL3
BRIDGE NO. : 41

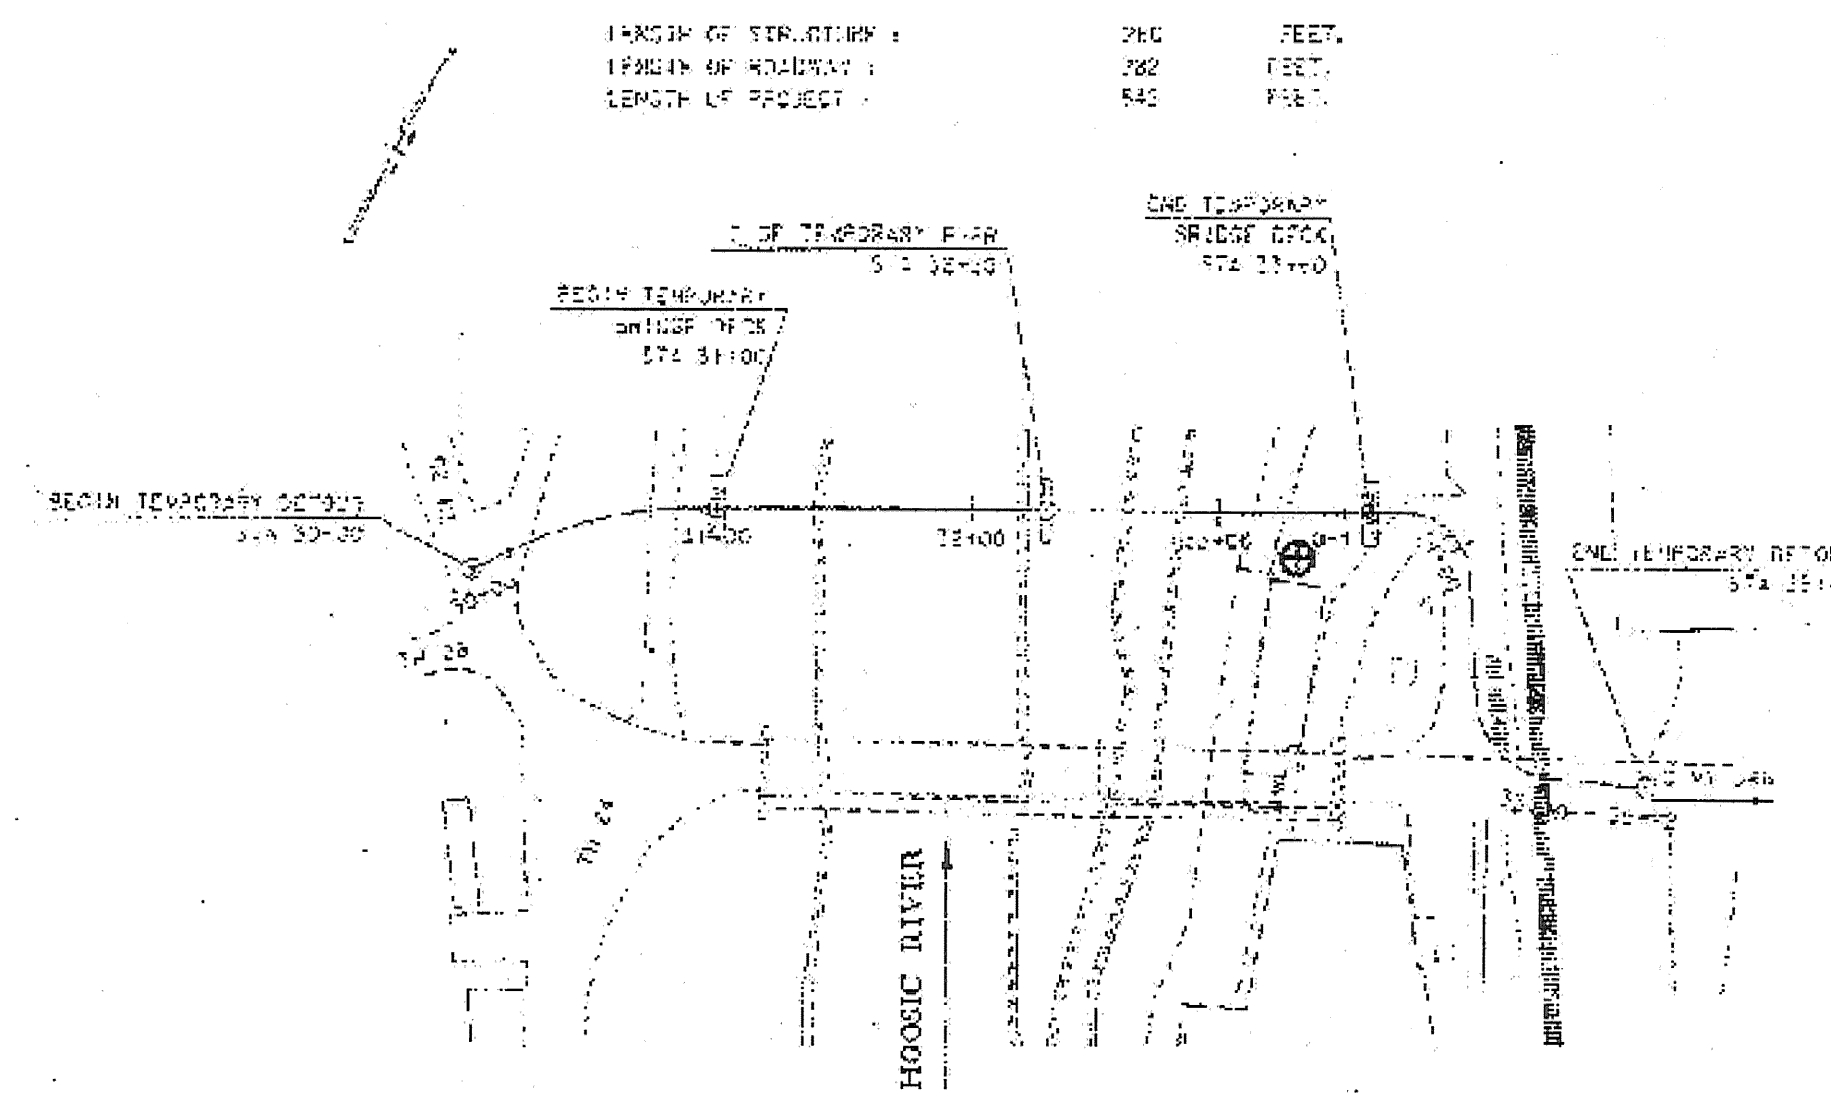

SITE PLAN

RECEIVED
JUN 30 1997

POWNAL
BRZ 144(19) C/2
REFERENCE SHEET 13 OF 18
SHEET 103 OF 108

RECEIVED
JUN 02 1997

DWG NO.	TITLE
1	TITLE SHEET
2	TEMPORARY BRIDGE LAYOUT SHEET
3	SOIL BORINGS & GENERAL NOTES
4	BRIDGE PLAN & PROFILE
5	FOOTING DETAILS
6	STEEL DETAILS
7	GEOMETRIC ALIGNMENT LAYOUT FOR HABER BRIDGE

			POWNAL TEMPORARY BRIDGE OVER HOOSAC RIVER		DWG NO. 1 OF 7
			PREPARED FOR: PETRICCA CONSTRUCTION CORP. POWNAL, VERMONT.		
PROJECT NO. 97024C	DRAWN BY: JMS	DATE: MAY 1997	SCALE: N/A	TITLE SHEET	