



10+46  
CONSTRUCT DRIVE RIGHT

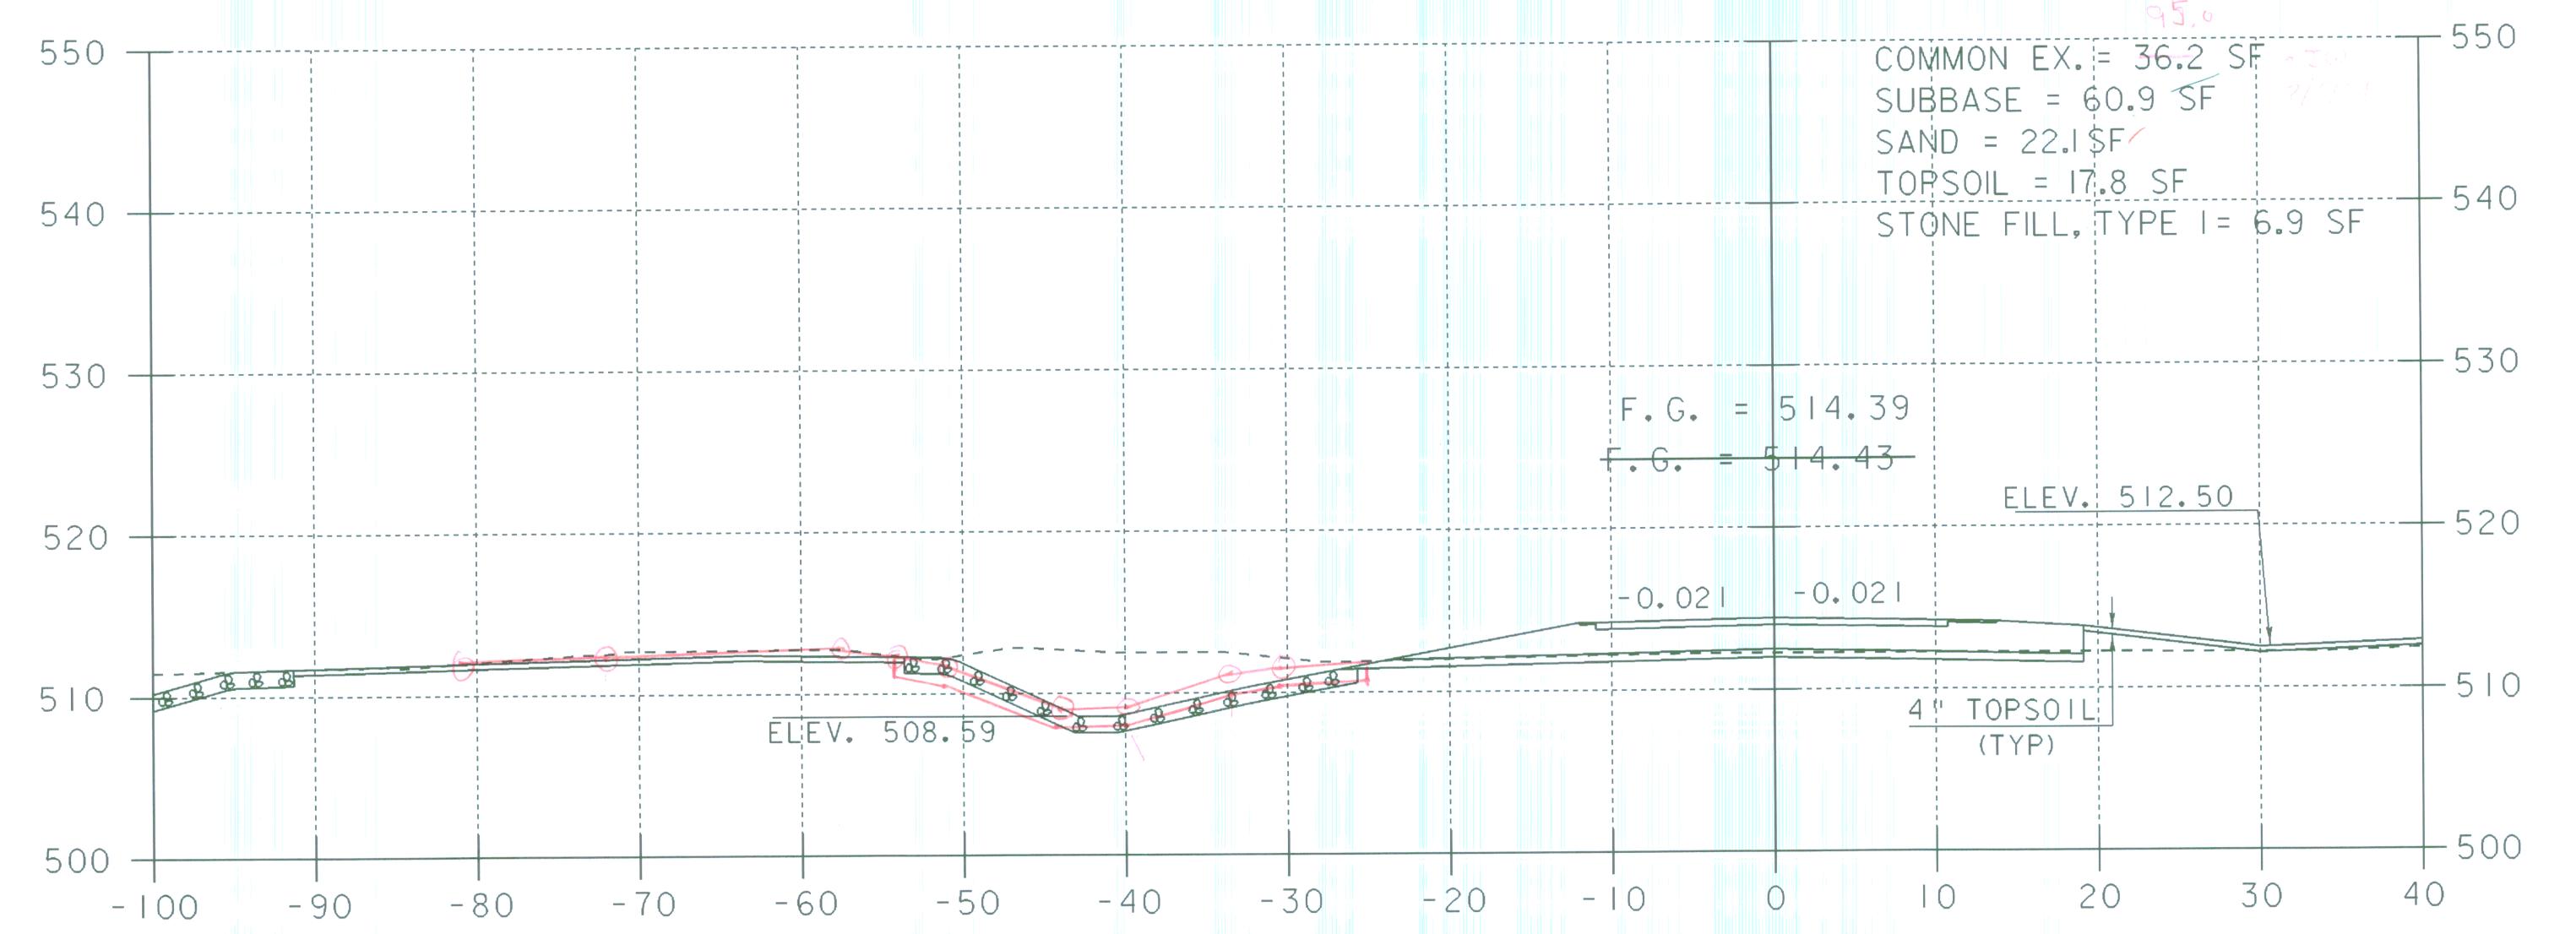


10+75

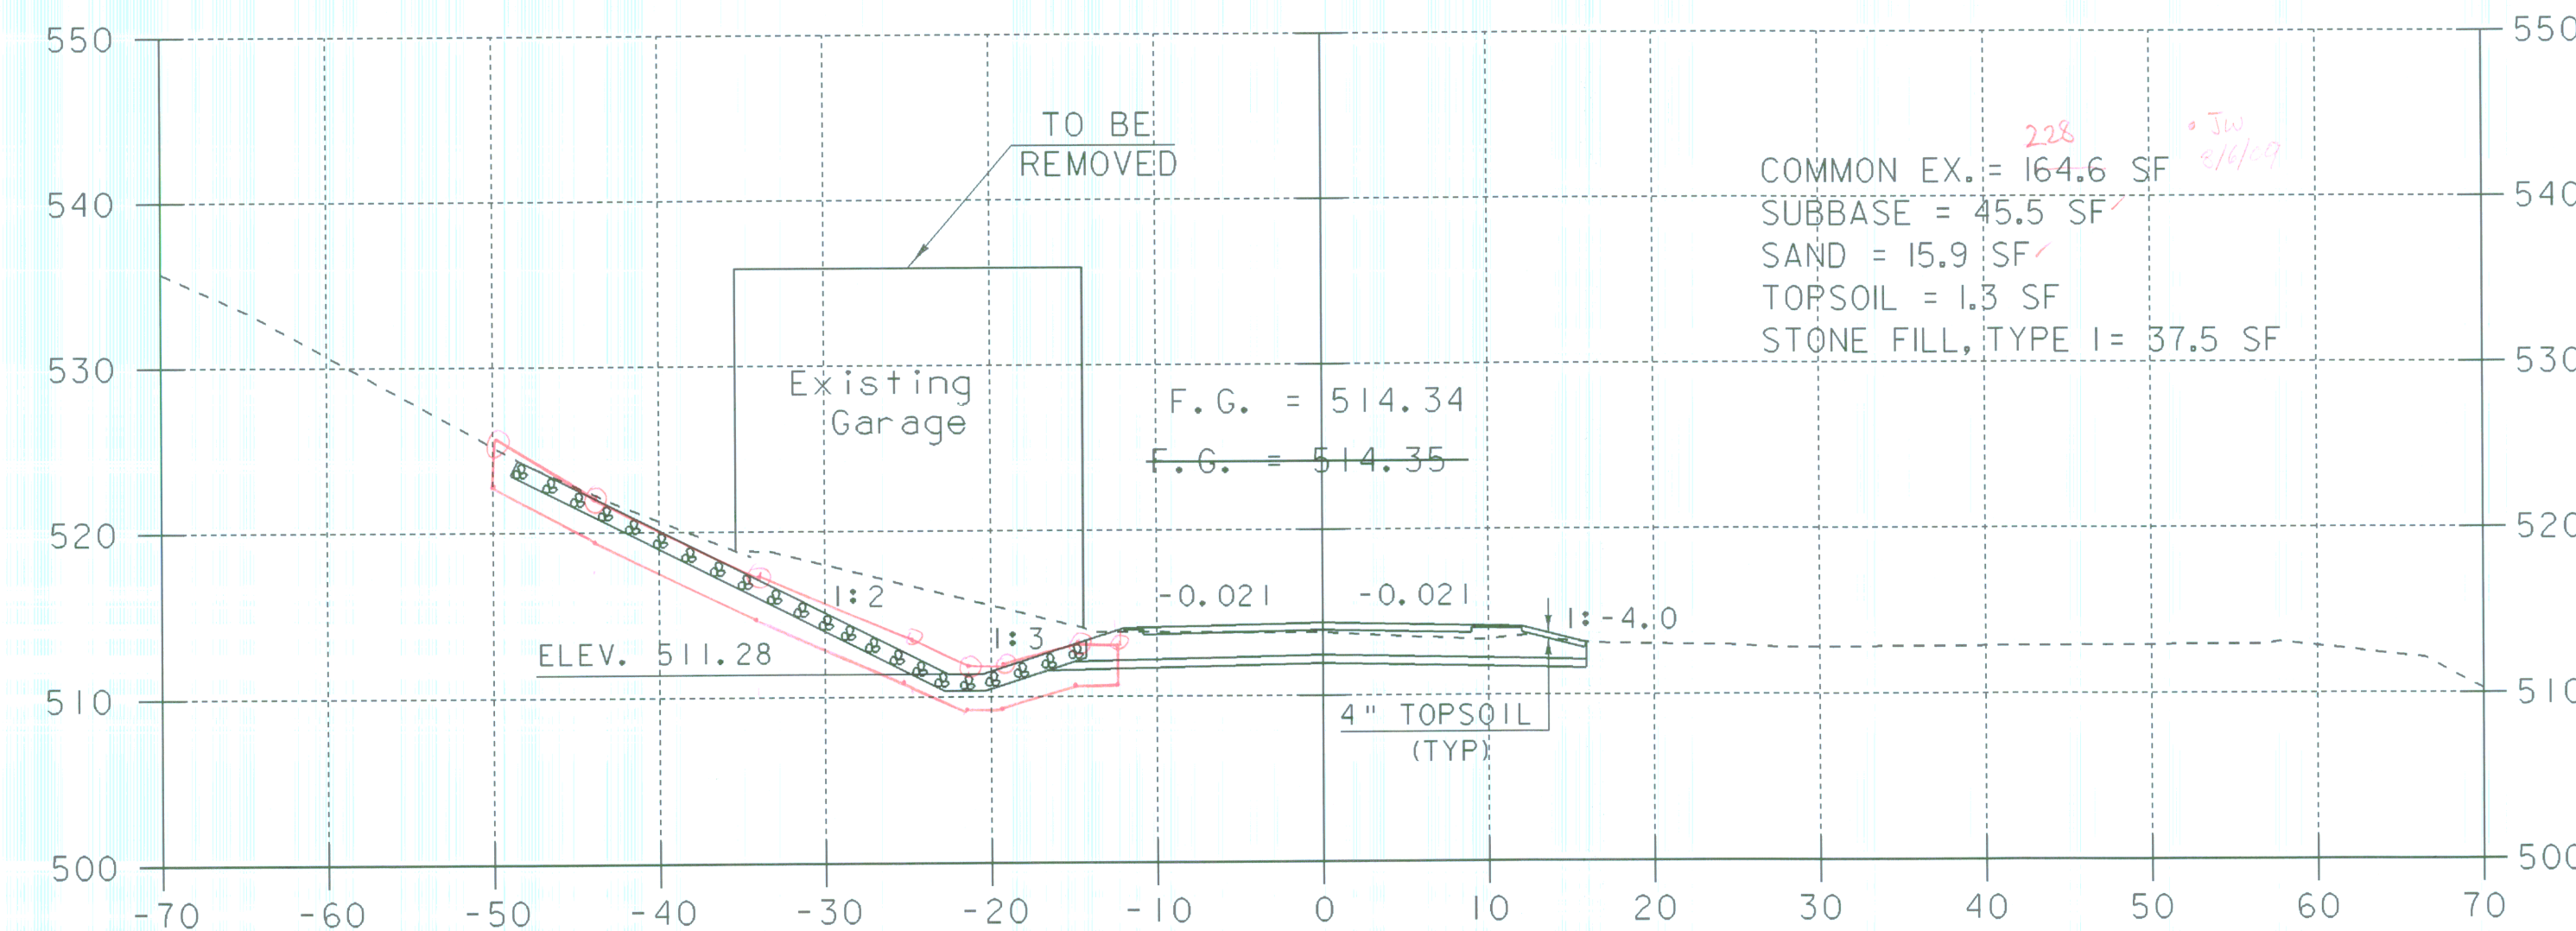

10+00

EXTRA DEPTH STONE

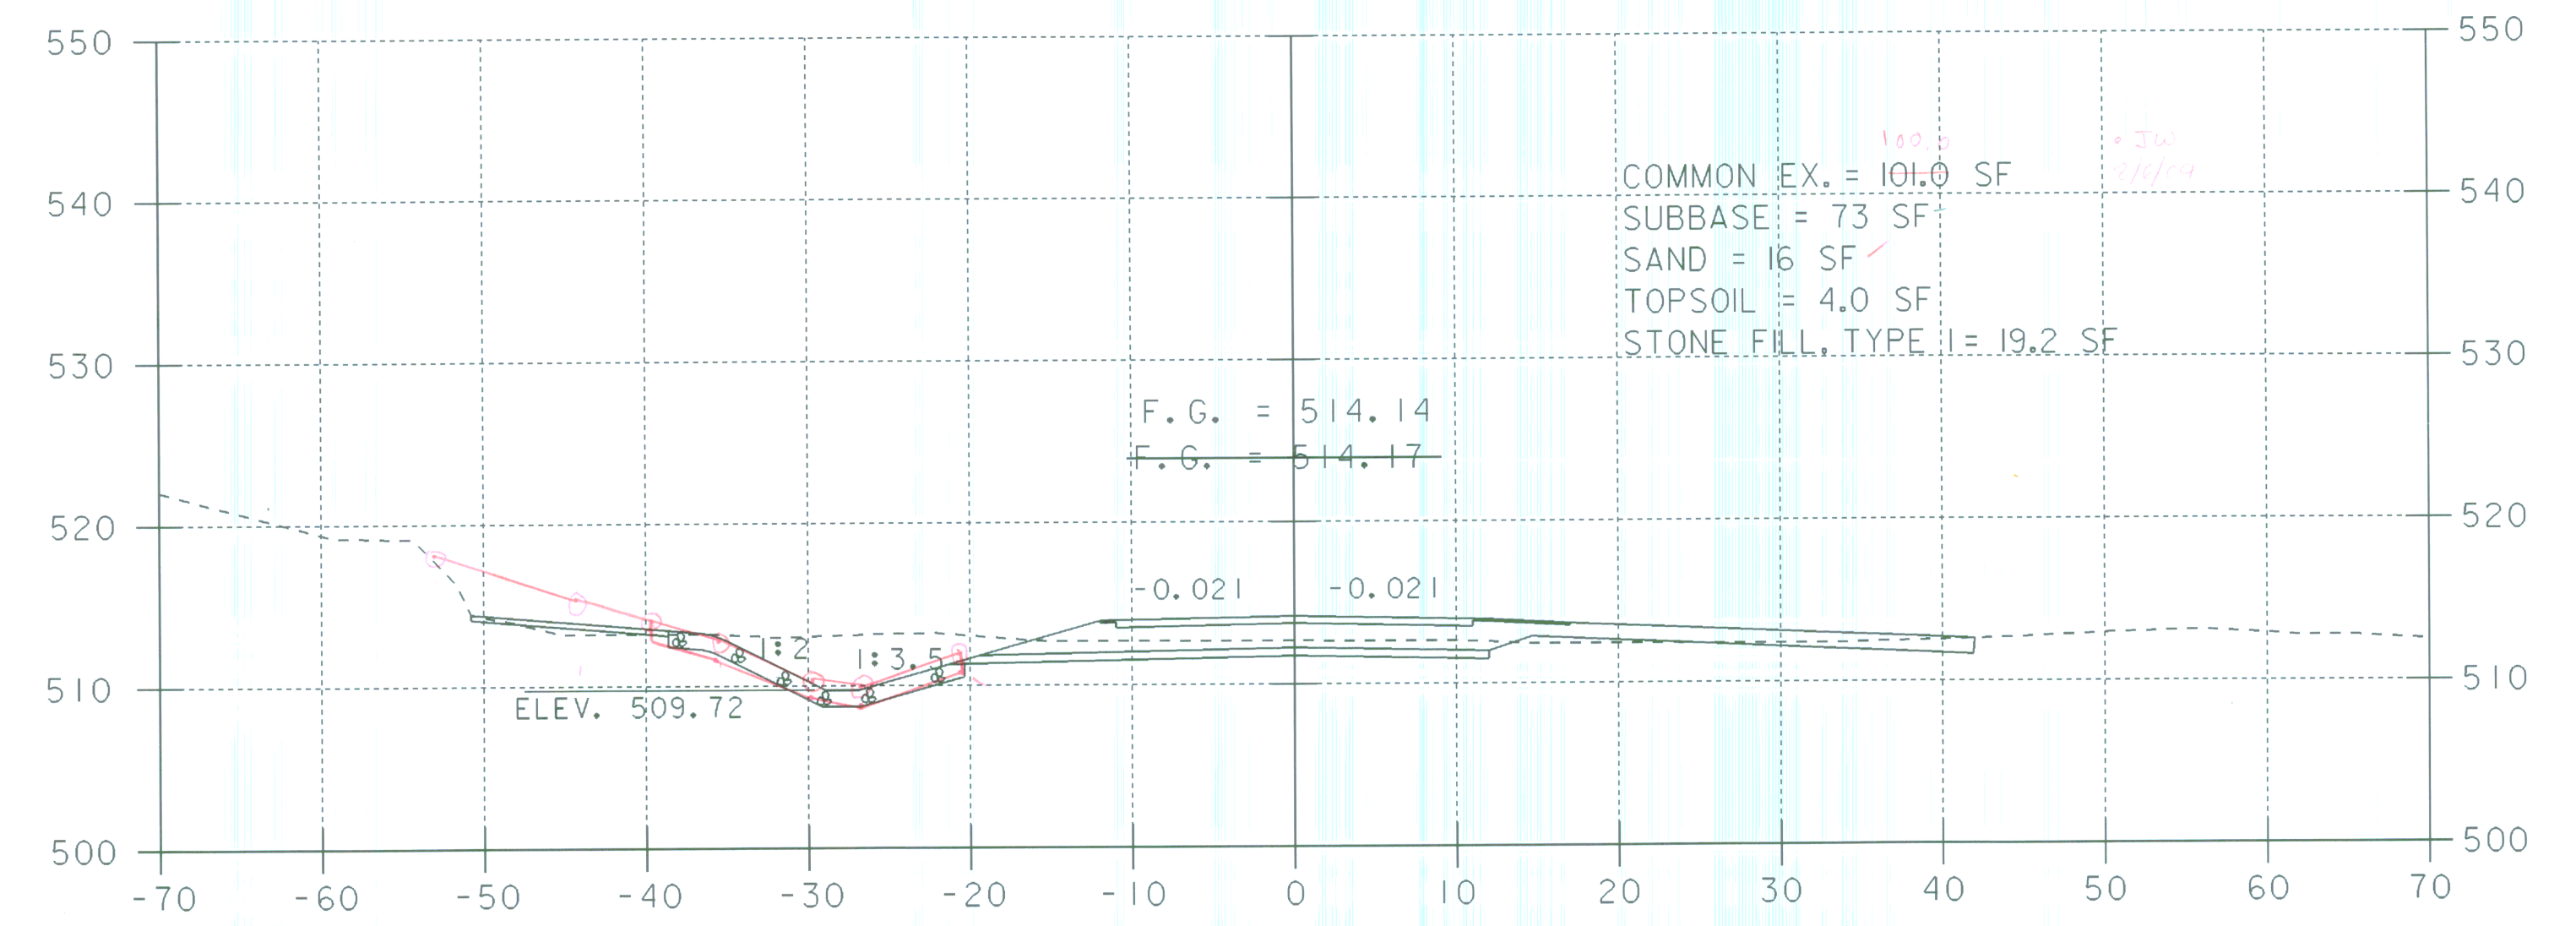

10+50  
END APPROACH  
BEGIN PROJECT

STA 10+50.8 RT  
BEGIN SPECIAL DITCH



SHEET NAME: MAINLINE CROSS SECTIONS	
PROJECT NAME: POWNAL	HIGHWAY NO.: TH 24
PROJECT NUMBER: BRZ 141(19) C/2	BRIDGE NO.: 41
	OVER: HOOSIC RIVER
FILE NAME: 87e045/str/se045xs2.dgn	PLOT DATE: 19-FEB-2009
PROJECT MANAGER: R. WHITCOMB	DRAWN BY: J.GILMORE
DESIGNED BY: C. CARLSON	IPARM NAME: se045mx2.1
	SHEET 68 OF 108