


**MATERIALS TRANSITION**


NTS

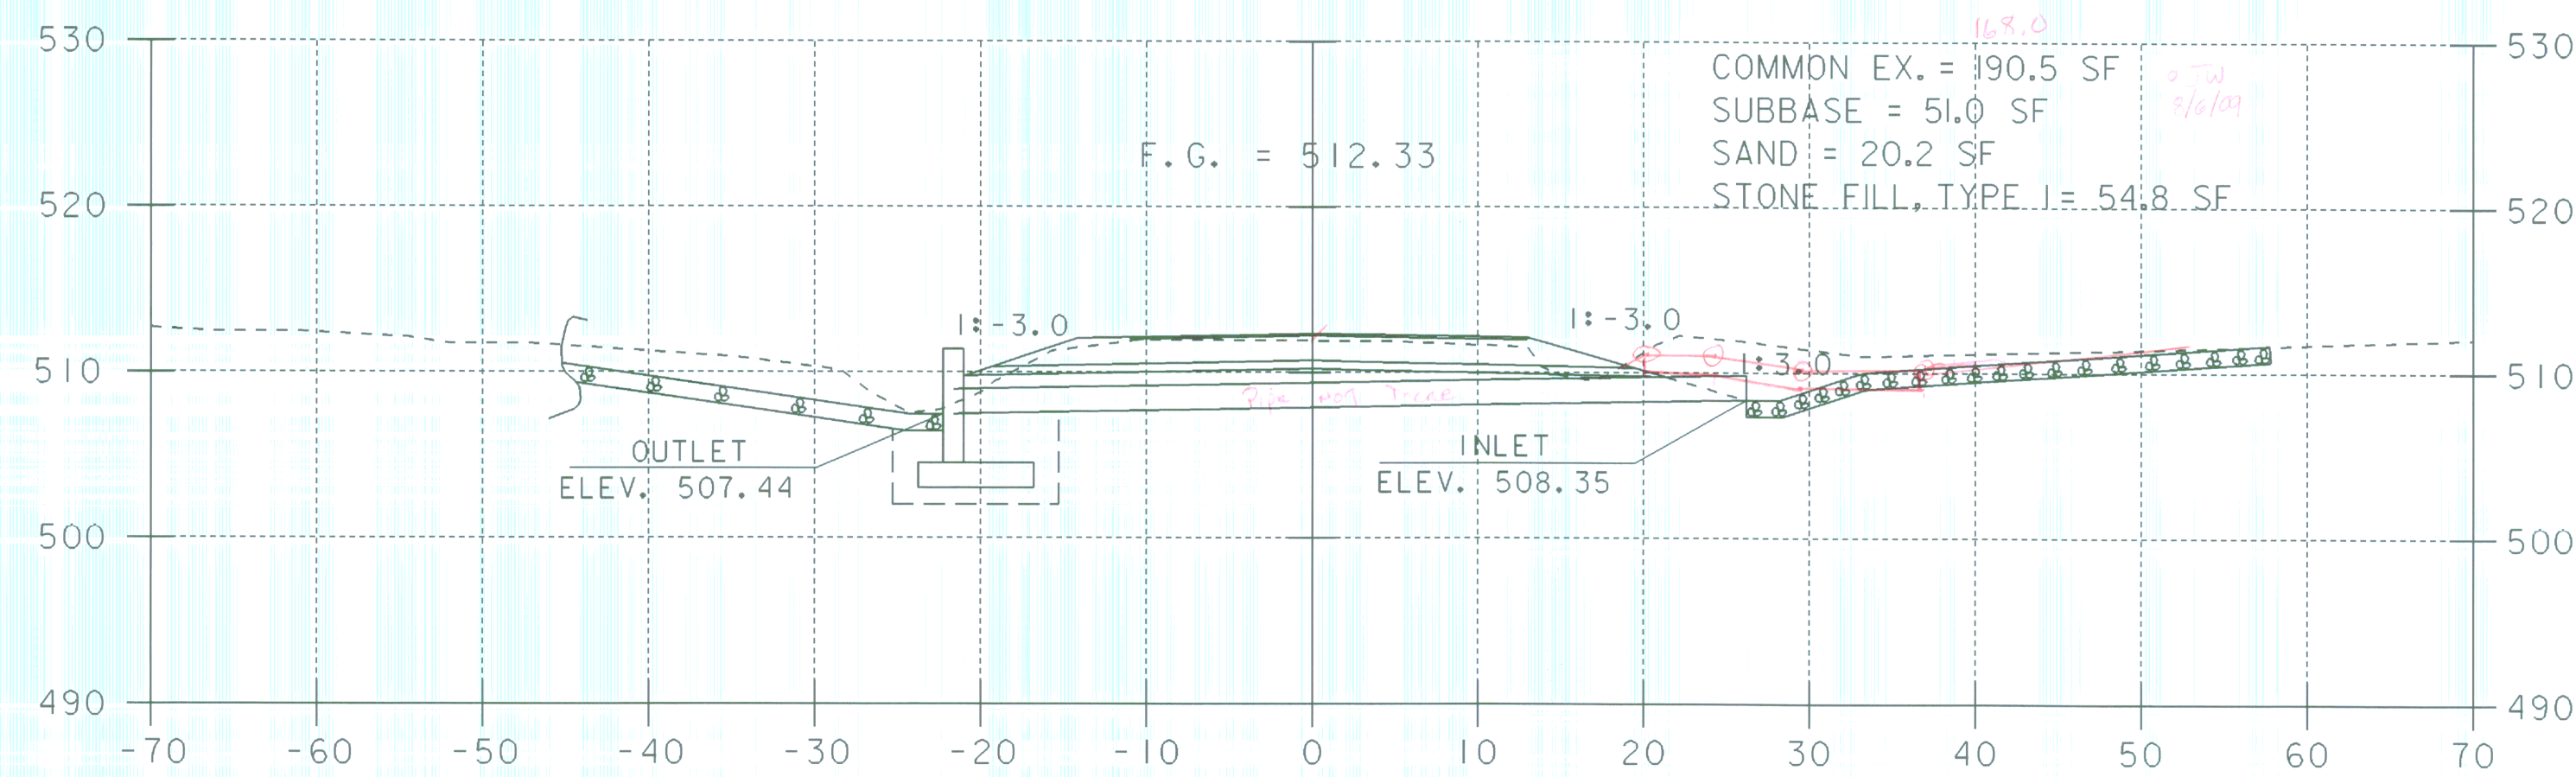


7+26  
 SKewed SECTION OF  
 Q OF 18" PIPE

STA 7+19.0 LT  
 BEGIN STONE LINED DITCH WITH  
 STONE FILL, TYPE I

STA 7+23.2 RT  
 BEGIN STONE LINED DITCH WITH  
 STONE FILL, TYPE I

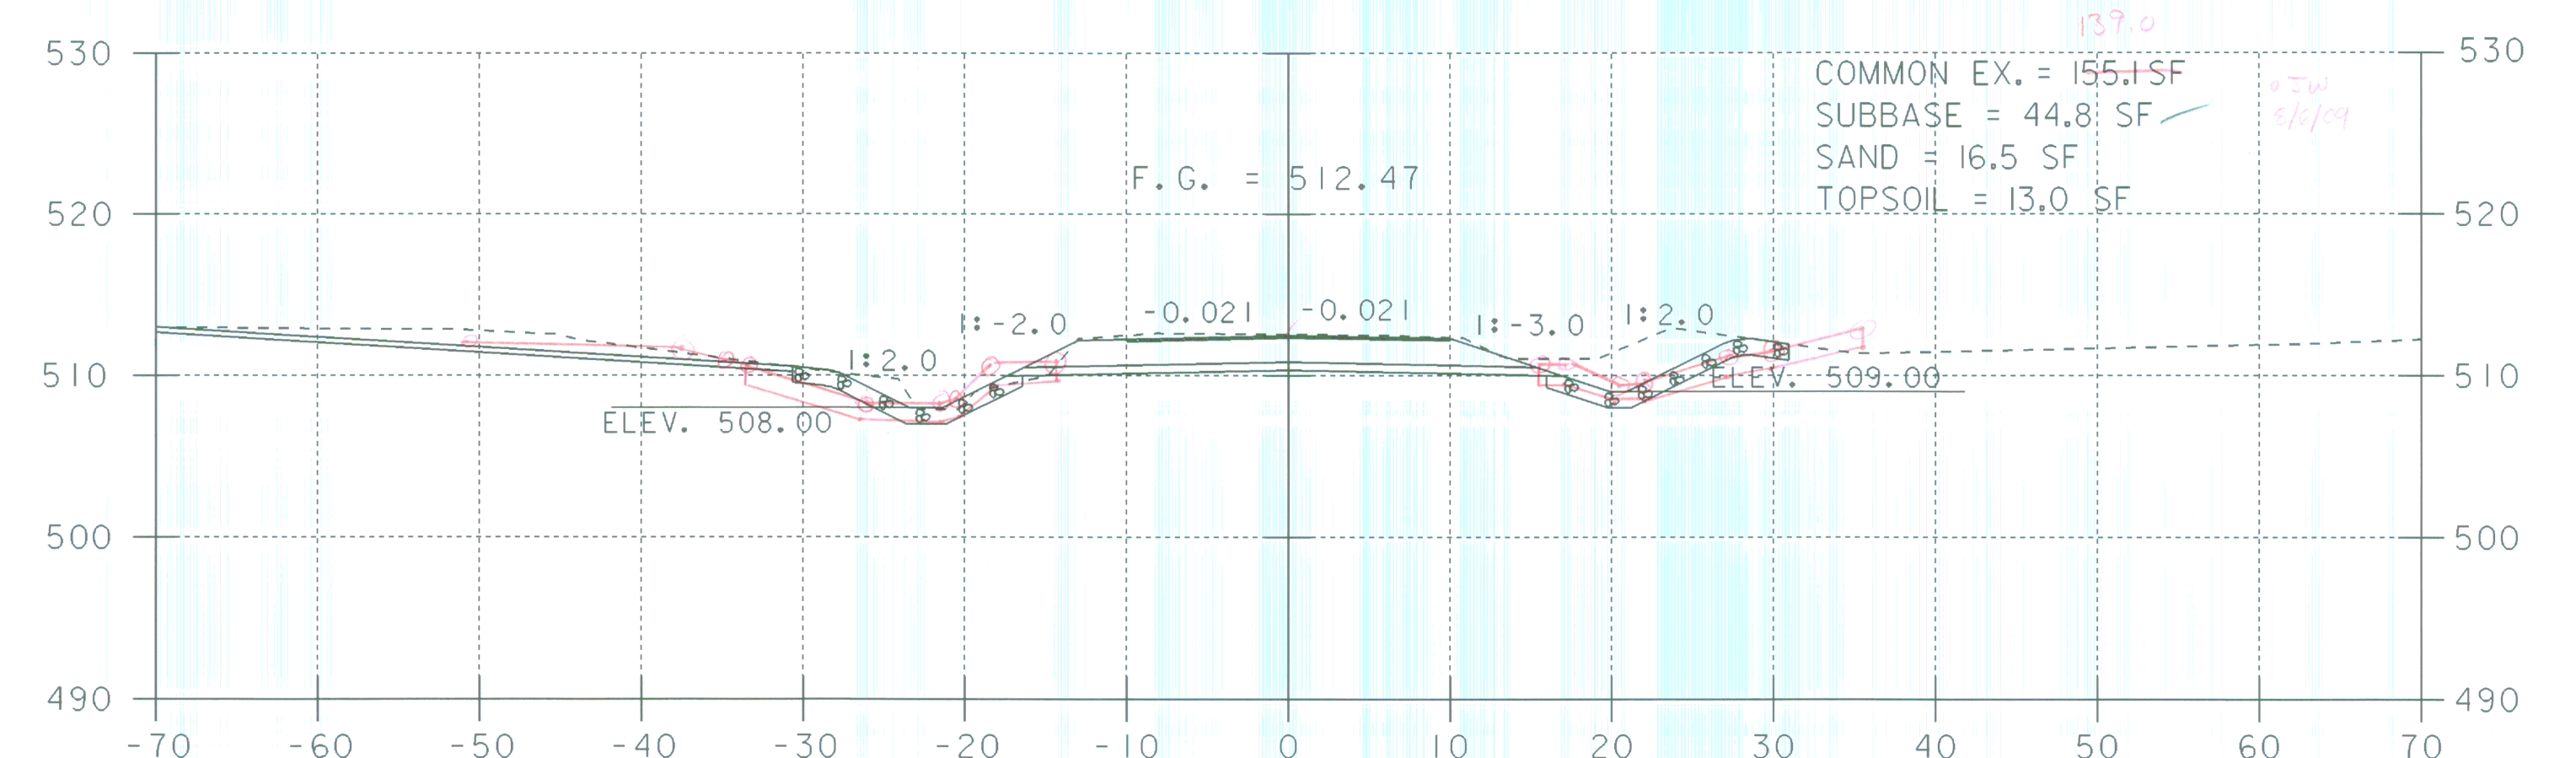


7+40

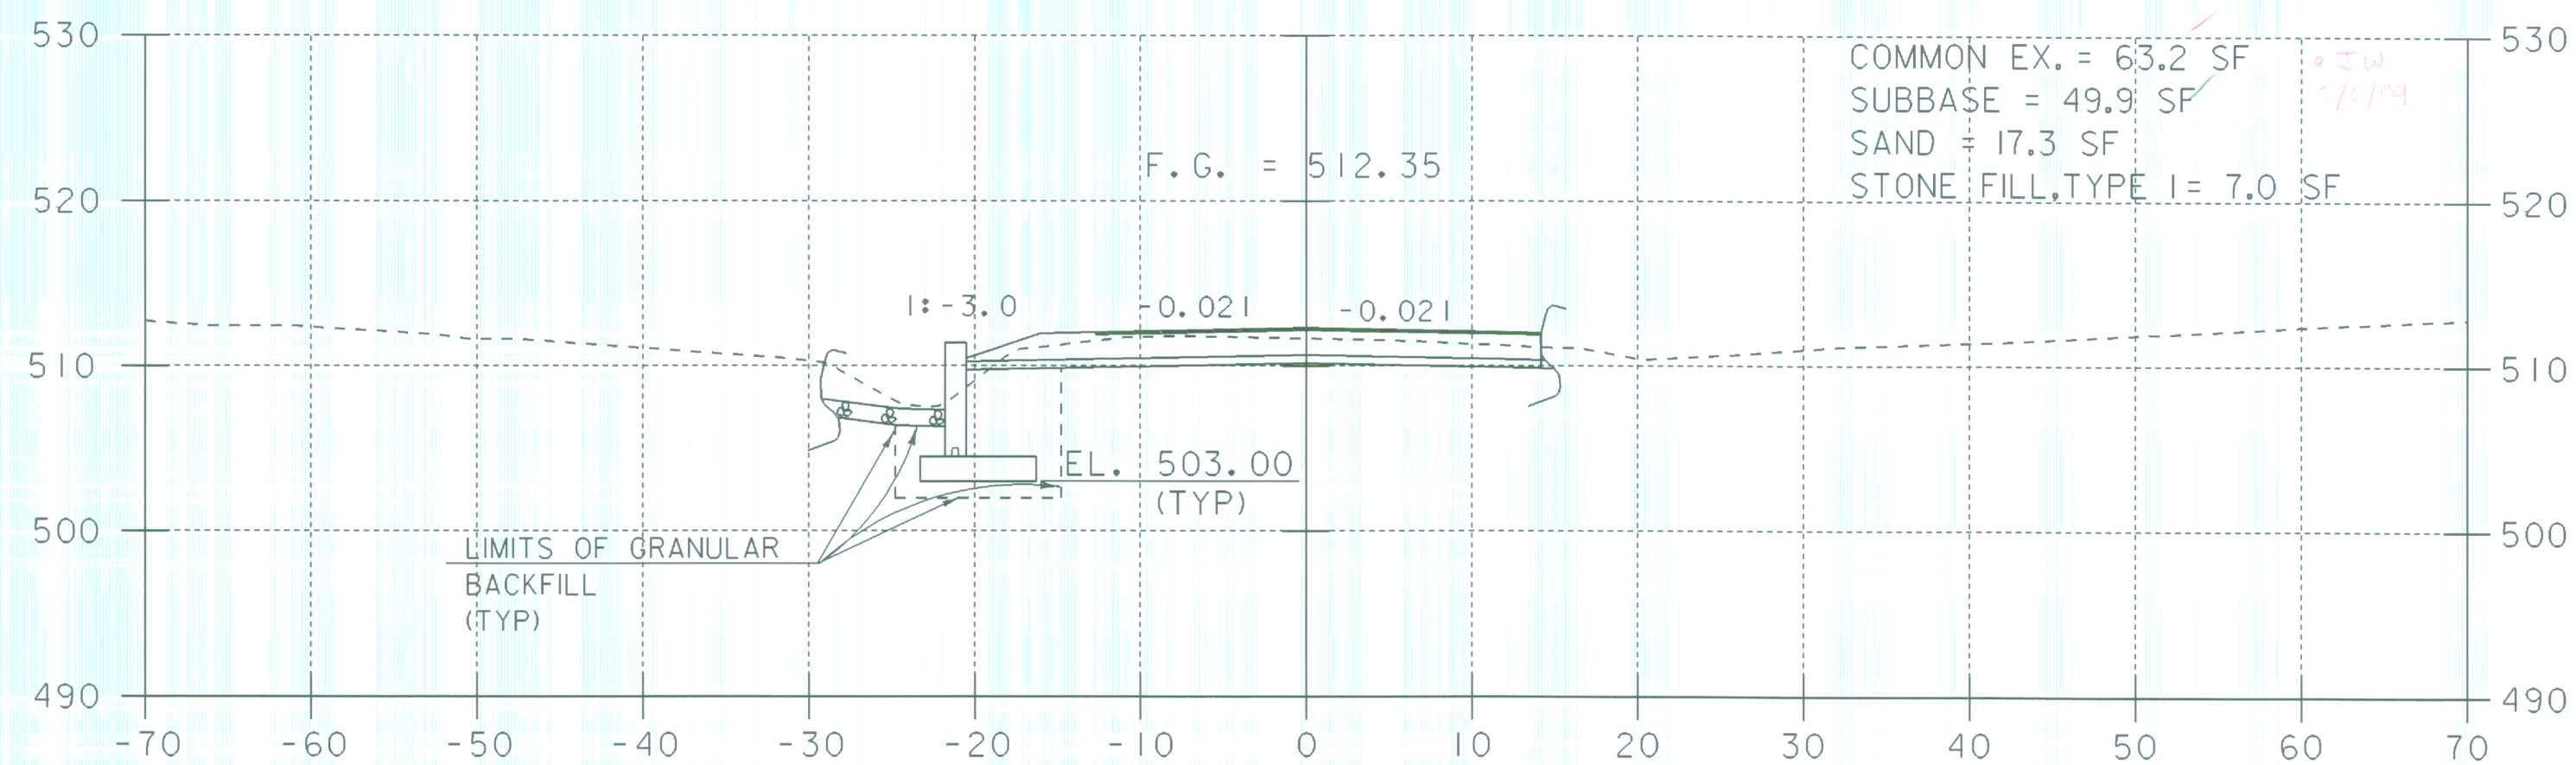

7+20

STA 7+12.12  
 BEGIN TH 26  
 SIDELINE  
 CONSTRUCTION

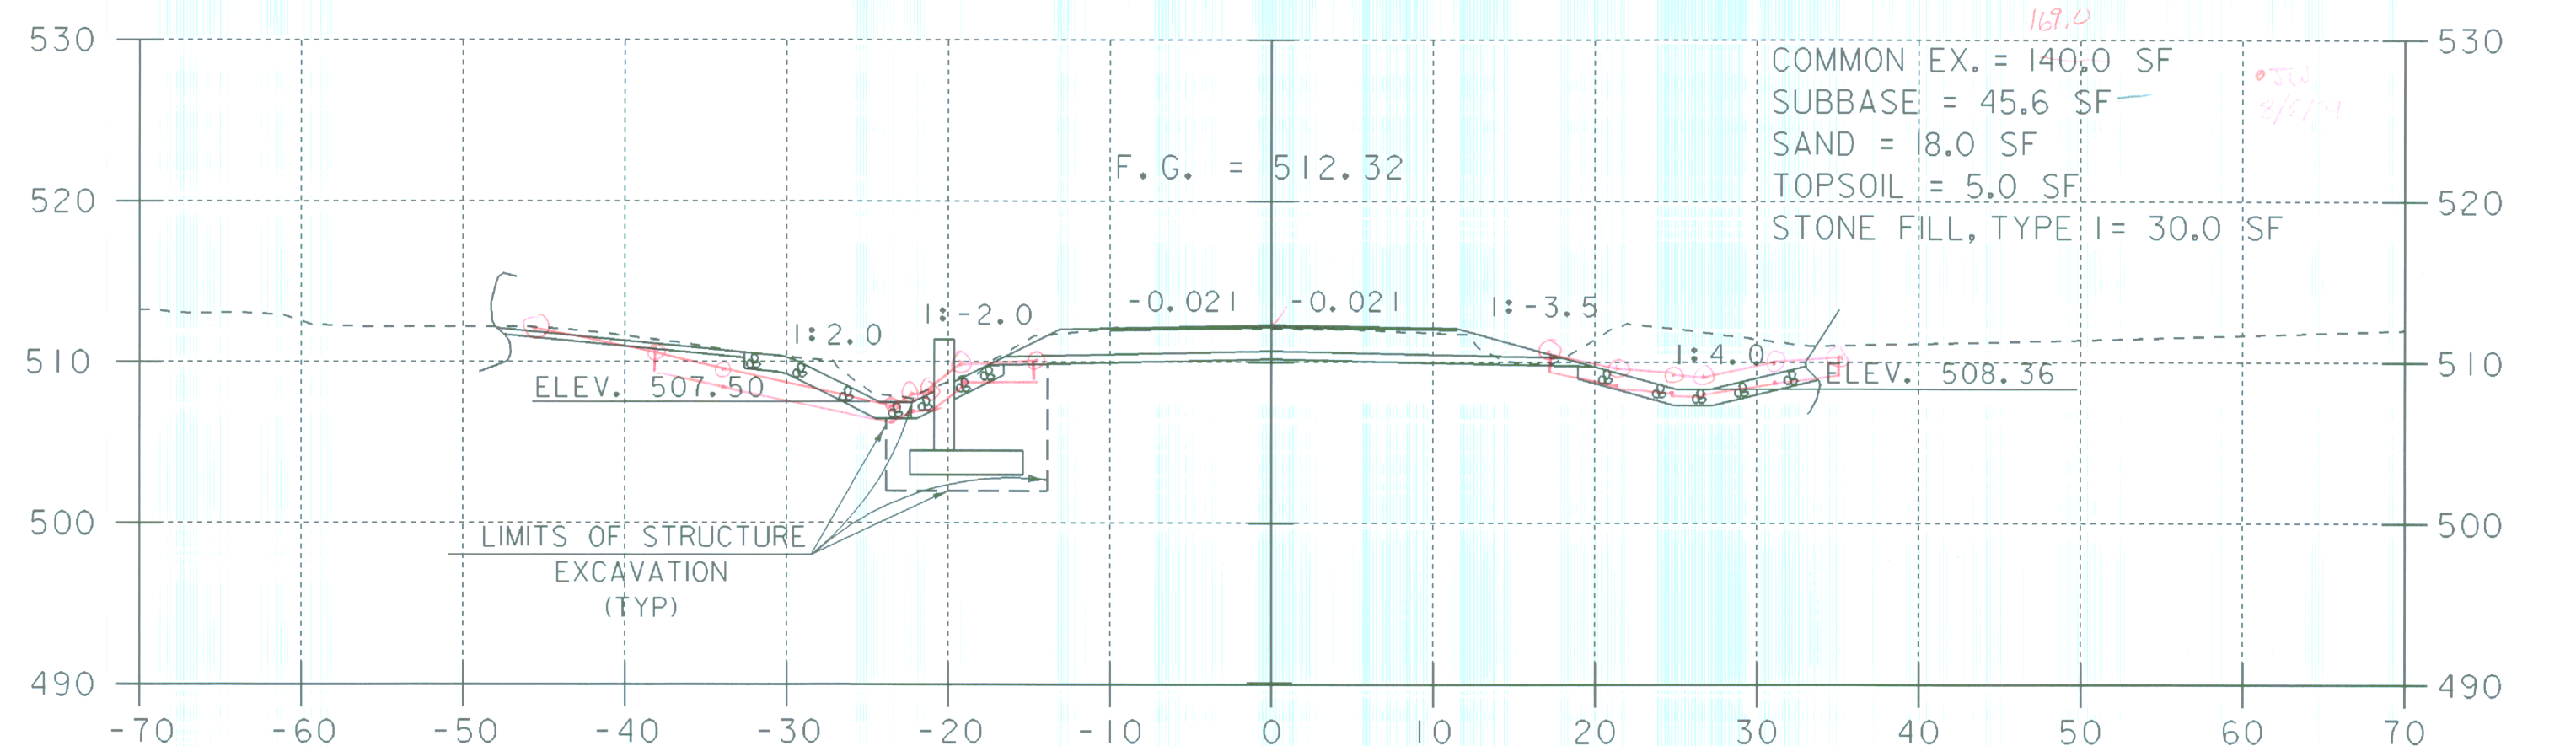

7+30



FURLONG ROAD

SHEET NAME: TOWN HIGHWAY 26 CROSS SECTIONS	
PROJECT NAME: POWNAL	HIGHWAY NO.: TH 24
PROJECT NUMBER: BRZ 144(19) C/2	BRIDGE NO.: 41
	OVER: HOOSIC RIVER
FILE NAME: 87e045/str/se045xs2.dgn	PLOT DATE: 19-FEB-2009
PROJECT MANAGER: R. WHITCOMB	DRAWN BY: J. GILMORE
DESIGNED BY: C. CARLSON	IPARM NAME: se045sx4.1
	SHEET 79 OF 108