



JOB NO.		DRAWING NO.		REV.						
367		8								
PAGE	LINE	MARK	QTY	MARK	MATERIAL	LENGTH		REMARKS	WT	PROCUREMENT NOTES
						FT	INCHES			
		8G3B	1		GIRDER				2482	
1	N		1	ua	PL 5/8x46	70	4 5/16	(A709-50WT2) (H2-3)		
1	E		1	ta	PL 2x18	70	4 5/16	(A709-50WT2) (H2-3)		
1	E		1	ba	PL 2x18	70	3 3/16	(A709-50WT2) (H2-3)		
2	N		1	x2b	PL 7/8x8 1/2	3	10	M1E		
2	N		1	x2d	PL 7/8x8 1/2	3	10	M1E		
2	P		4	x2f	PL 5/8x8	3	10			
2	P		4	x2g	PL 5/8x8	3	10			

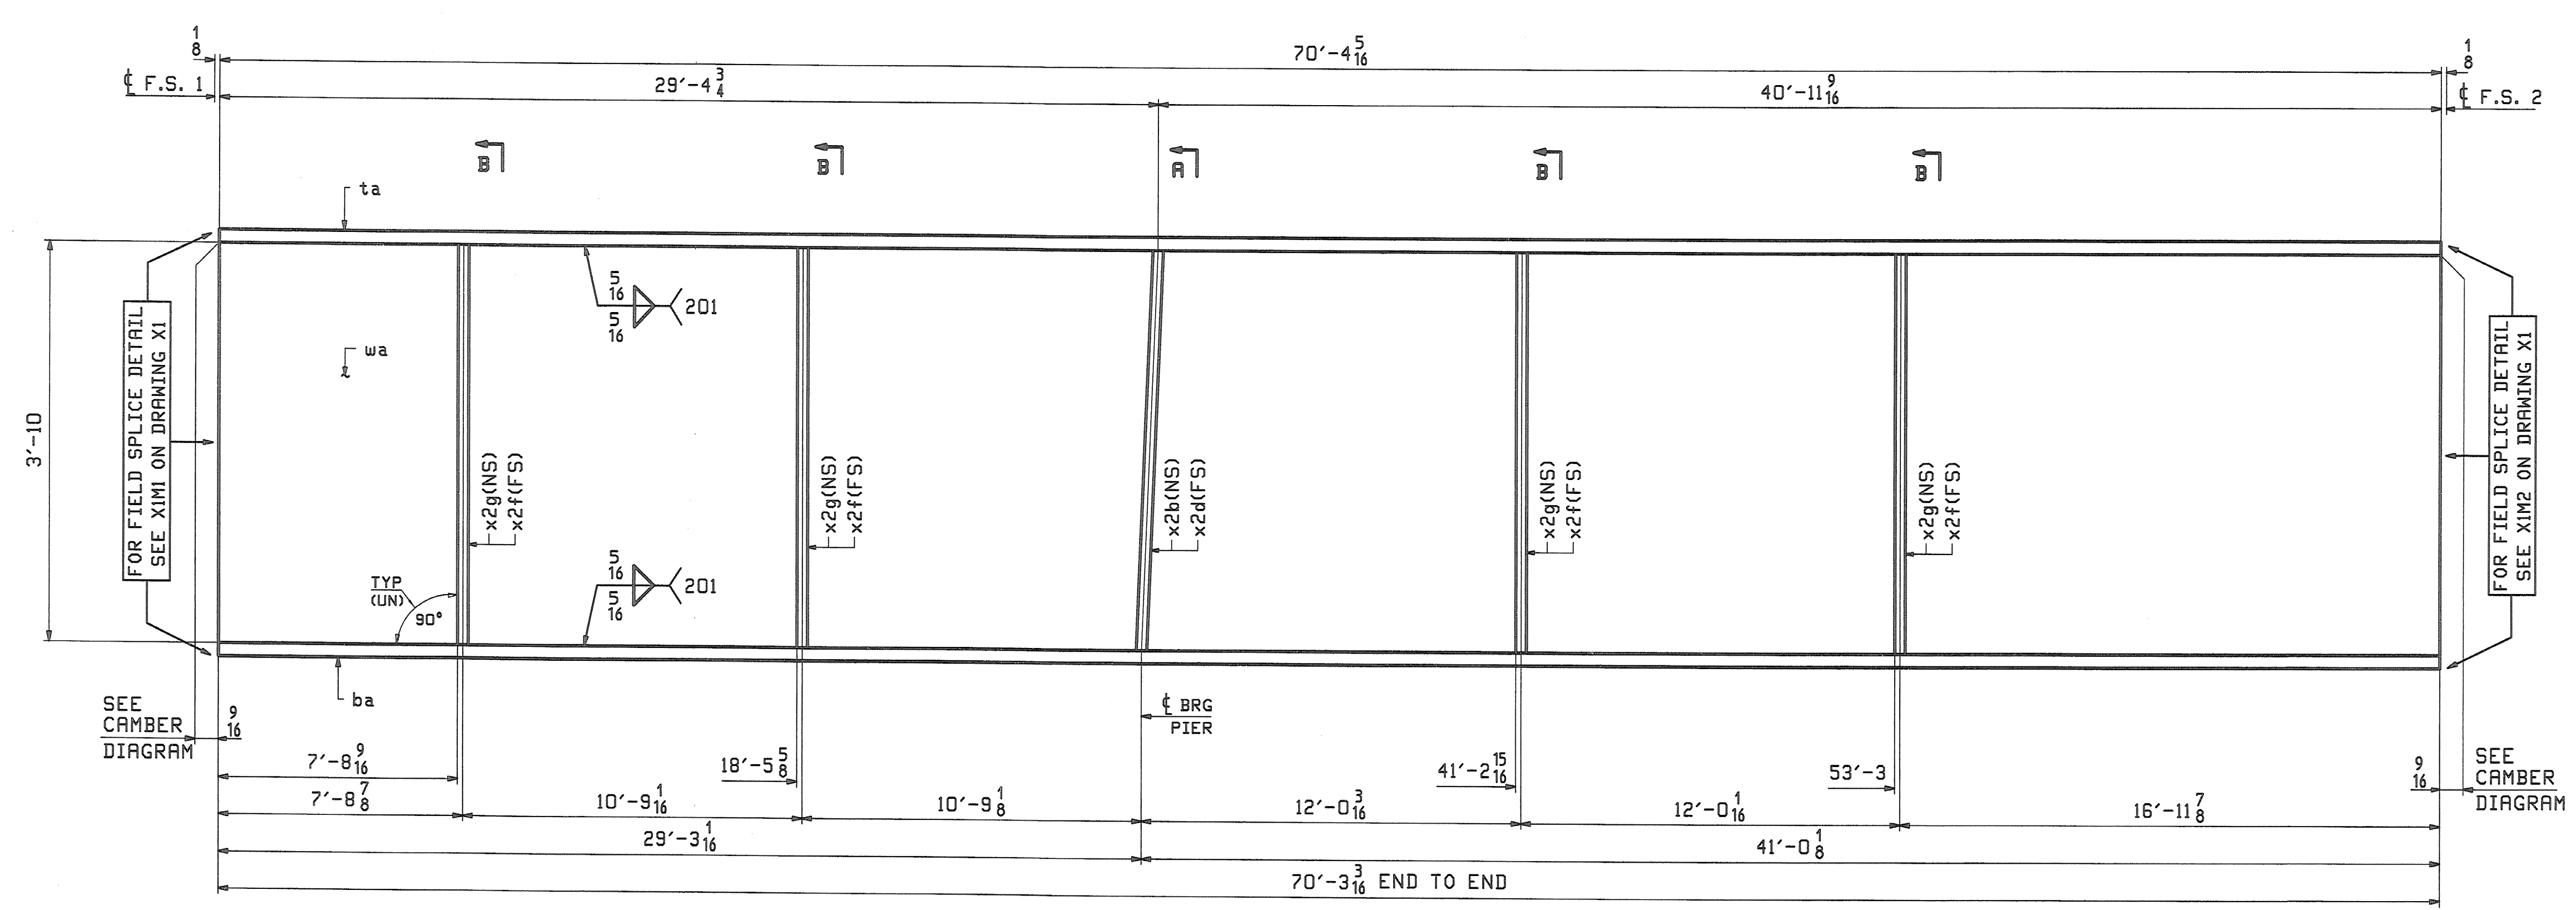


ONE - GIRDER - 8G3B

FOR GIRDER STANDARDS SEE DRAWINGS X1 & X2.
 FOR CAMBER & FLANGE DIAGRAMS SEE DRAWING C2.
 FOR GENERAL NOTES & WELD PROCEDURES SEE DRAWING GNI.
 H2-3 DENOTES MATERIAL SUBJECT TO CHARPY V-NOTCH TESTING.

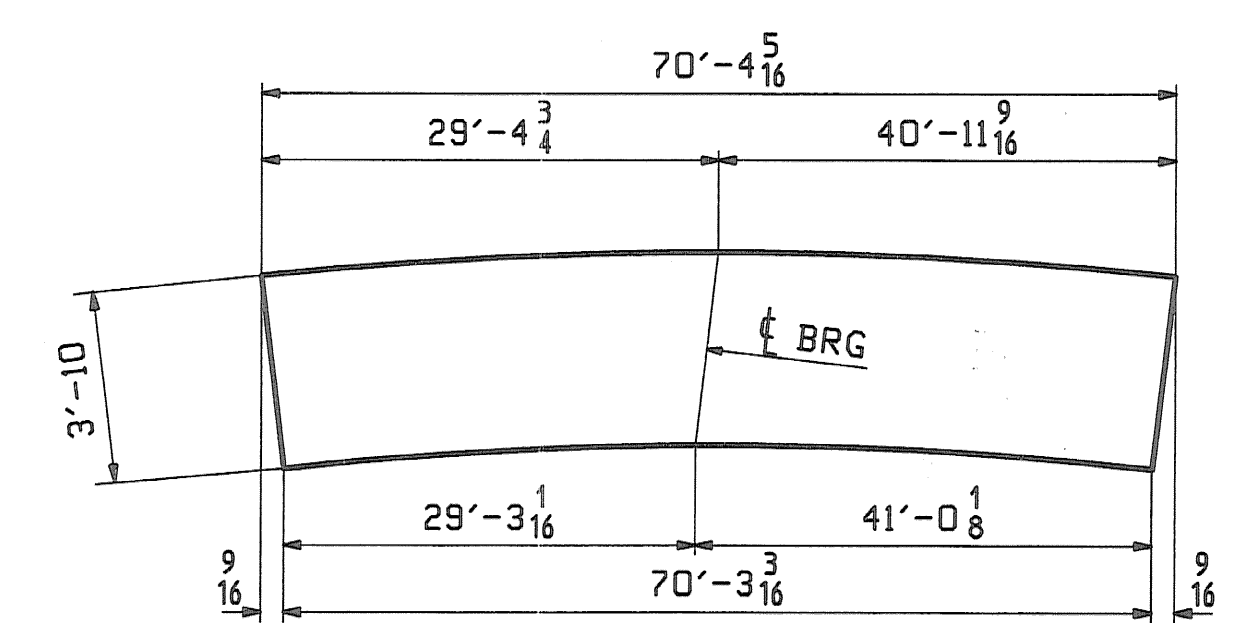

ORIENTATION DIAGRAM FOR CAMBER SEE DWG C2

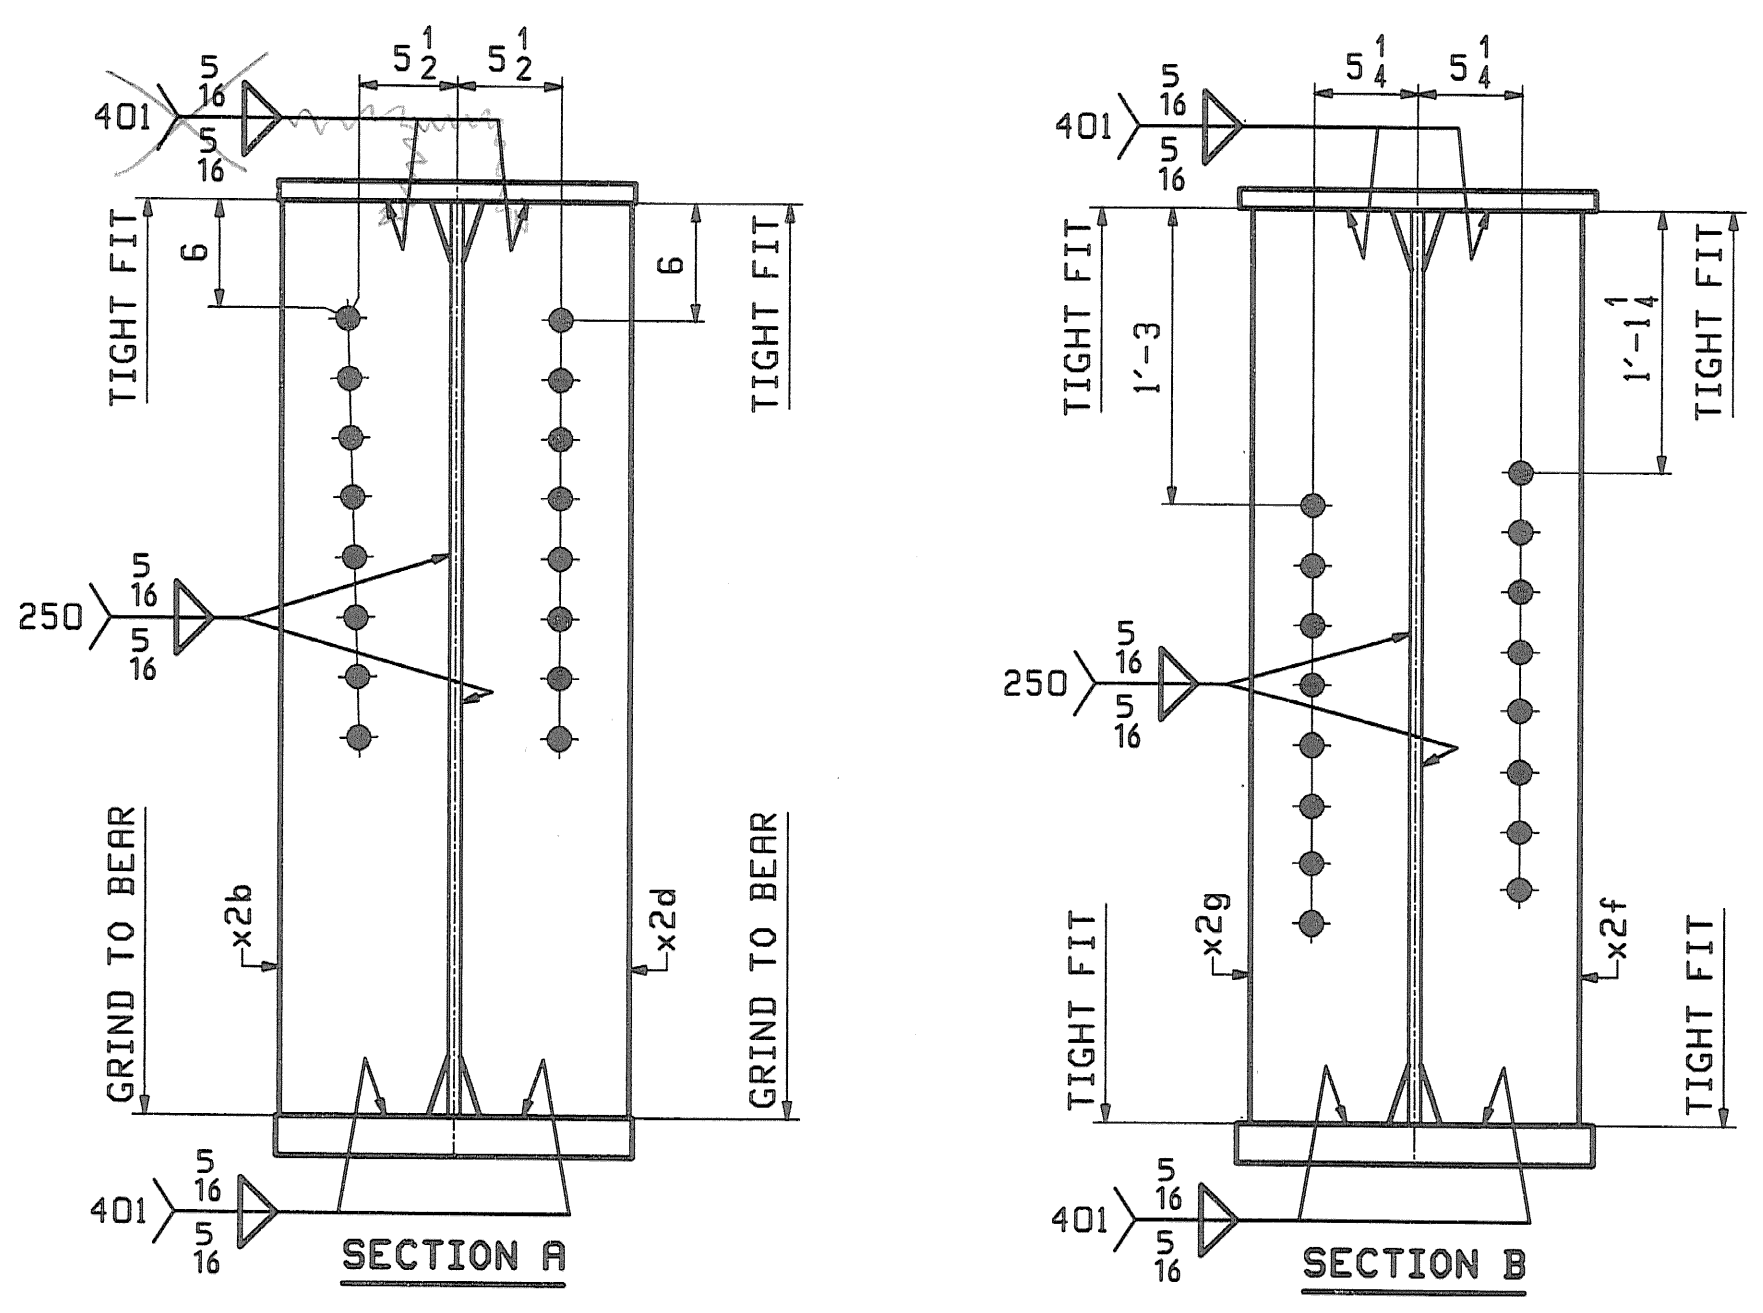

REV.	DATE	REMARKS	DWN	CHK	APVL	SHOP
0						5-12-08
MATERIAL:		SURFACE PREP. & PAINT:		HOLES:		SHOP BOLTS:
A709-50W (UN)		SEE DWG GNI		15 16"		NONE
DESCRIPTION: GIRDER - 8G3B						
CASCO BAY STEEL STRUCTURES, INC. 75 SPRING HILL ROAD SACO, MAINE 04072 PHONE (207) 282-7360 FAX. (207) 282-1179						
STRUCTURE: TH24 over Hoosic River BRIDGE NO. 41 PONNAL, VERMONT COUNTY OF BENNINGTON				DRAWN:	DATE:	
				JTB	04/25	
				CHKD:	DATE:	
				TM	05/05	
LOCATION: TOWN OF PONNAL					JOB NO.	DWG NO.
PROJ NO. BRZ 1441 (19) C/2					367	8
CUSTOMER: VERMONT AGENCY OF TRANSPORTATION						REV. Δ

RECEIVED
 MAY 15 2008
 APPROVED AS NOTED