


H = HOLE SIDE
 SS = SHORT SLOTTED SIDE
 LS = LONG SLOTTED SIDE

APPROACH RAIL SEE SHEET STARTING w/LB10 (SPLICES BILLED OUT ON APPR. SHEETS) (TYP.)

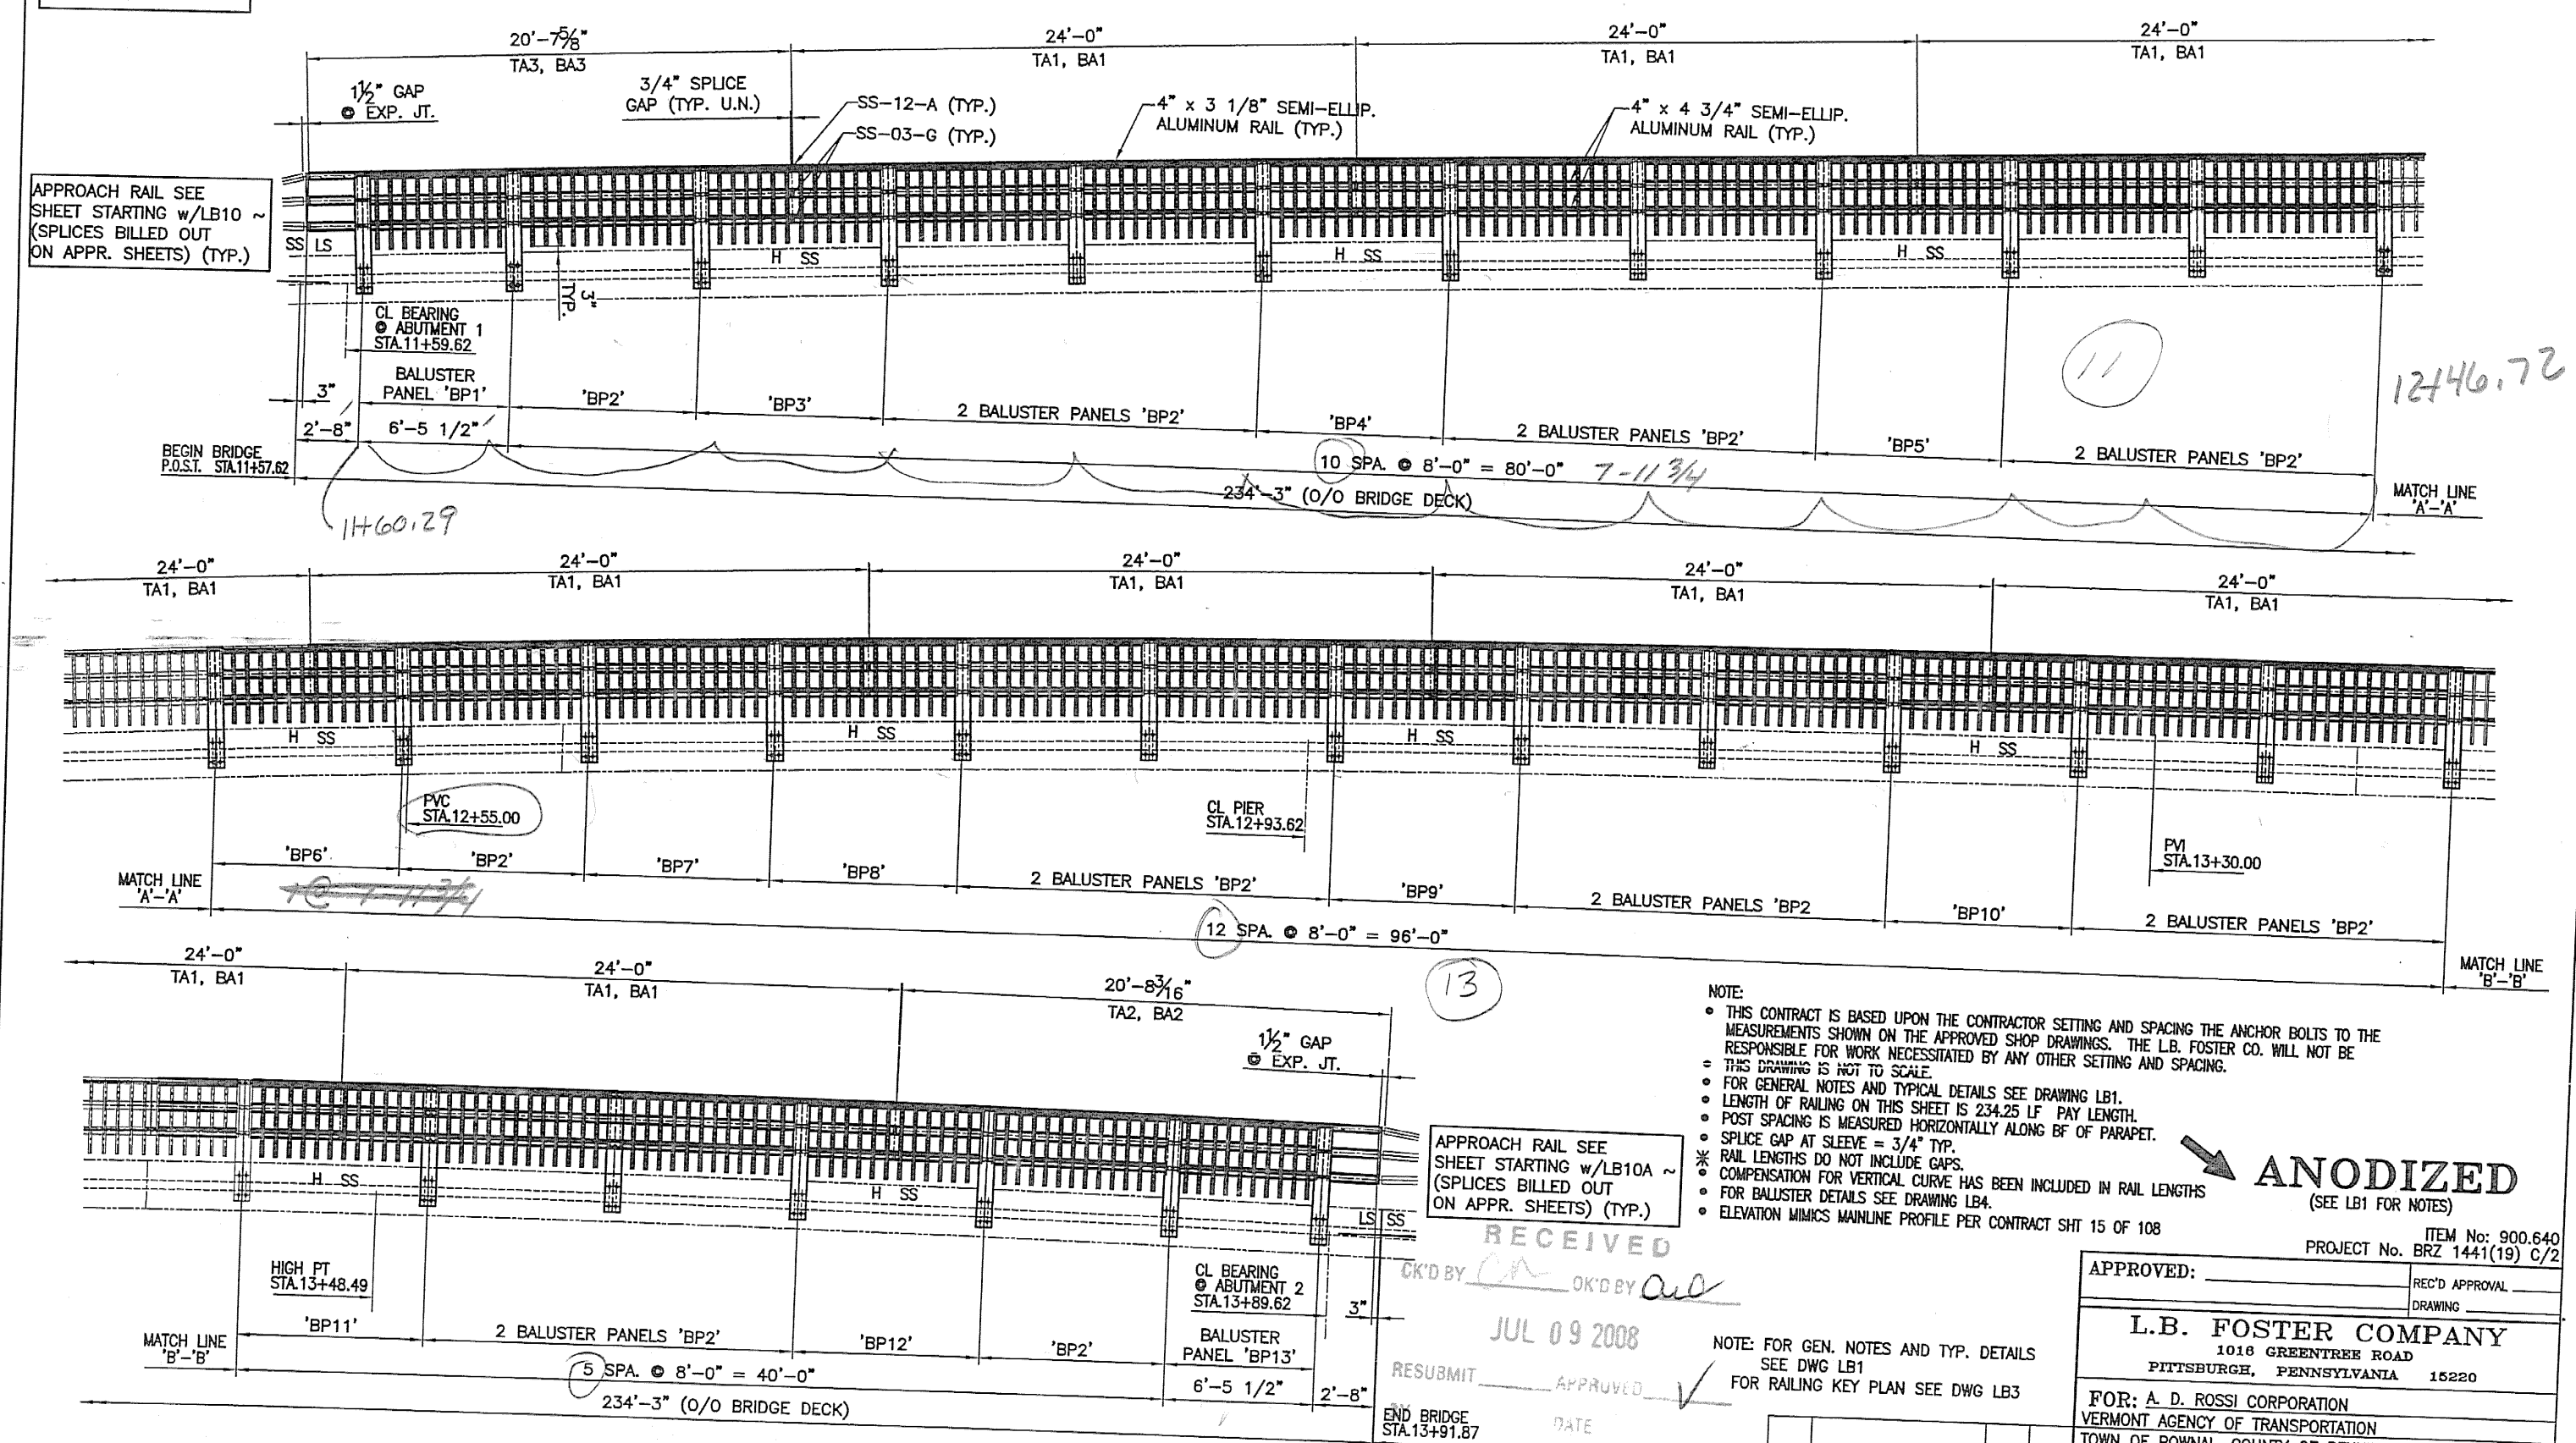

NOTE:
 • THIS CONTRACT IS BASED UPON THE CONTRACTOR SETTING AND SPACING THE ANCHOR BOLTS TO THE DIMENSIONS SHOWN ON THE APPROVED SHOP DRAWINGS. THE L.B. FOSTER CO. WILL NOT BE RESPONSIBLE FOR WORK NECESSARY BY ANY OTHER SETTING AND SPACING.
 • THIS DRAWING IS NOT TO SCALE.
 • FOR GENERAL NOTES AND TYPICAL DETAILS SEE DRAWING LBA.
 • LENGTH OF RAILING ON THIS SHEET IS 234.25 LF. PAY LENGTH.
 • PIER SPACING IS MEASURED HORIZONTALLY ALONG BF OF PARAPET.
 • SPLICE GAP AT SLEEVE = 3/4" TYP.
 • RAIL LENGTHS DO NOT INCLUDE GAPS.
 • COMPENSATION FOR TYPICAL CURVE HAS BEEN INCLUDED IN RAIL LENGTHS.
 • FOR BALUSTER DETAILS SEE DRAWING LBA.
 • ELEVATION WINGS MAINLINE PROFILE PER CONTRACT SHEET 15 OF 108

ANODIZED
 (SEE LBA FOR NOTES)

APPROACH RAIL SEE SHEET STARTING w/LB10A (SPLICES BILLED OUT ON APPR. SHEETS) (TYP.)

REV	DESCRIPTION	BY	DATE

APPROVED: _____
 PROJECT No. BRZ 1441(19) C/2
 ITEM No. 900.640
 DRAWING
L.B. FOSTER COMPANY
 1016 GREENVIEW ROAD
 PITTSBURGH, PENNSYLVANIA 15220
 FOR: A. D. ROSSI CORPORATION
 VERMONT AGENCY OF TRANSPORTATION
 TOWN OF POWNALL, COUNTY OF BENNINGTON
 BRIDGE RAILING FOR BRIDGE #41, TH 24, CLS (LOCAL)
 ST. ALUM BRIDGE RAILING - ELEVATION @ SIDEWALK SIDE
 WORK DATE 05/28/08 JOB No. BR485
 CHECKED DATE 06/17/08 DRAWING LBA
 CUST. No. _____
 REV. No. _____