


INSIDE ELEVATION OF WW #3 NE APPROACH RAIL

NOTE:  
 \* RAIL LENGTHS DO NOT INCLUDE END CAPS AND/OR GAPS.  
 \* LENGTH OF APPROACH RAILING ON THIS SHEET IS 57.79 LF PAY LENGTH.  
 \* LENGTHS SHOWN THUS ( ) ARE ACTUAL LENGTHS ALONG FRY FACE OF RAILING

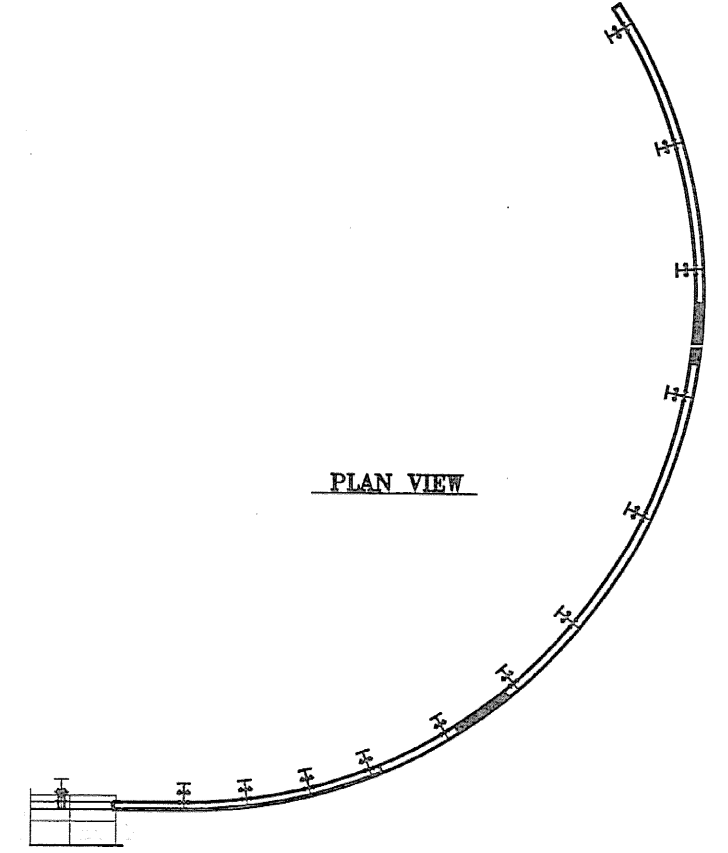

RECEIVED  
 OK'D BY [Signature]  
 JUL 09 2008  
 RESUBMIT \_\_\_\_\_ APPROVED [Signature]  
 BY \_\_\_\_\_ DATE \_\_\_\_\_

**ANODIZED**  
 (SEE L&S FOR NOTES)

PROJECT No. BR2 1441(19) C/2    ITEM No. 900.640

APPROVED:	REC'D APPROVAL:
<b>L.B. FOSTER COMPANY</b>	DRAWING
1919 GREENVIEW ROAD	
PITTSBURGH, PENNSYLVANIA 15220	

FOR: A. D. ROSSI CORPORATION  
 VERMONT AGENCY OF TRANSPORTATION  
 TOWN OF FERRIS, COUNTY OF BENNINGTON  
 BRIDGE RAILING FOR BRIDGE #41, TH 24, CL3 (LOCAL)  
 3L ALUMINUM APPROACH RAIL ELEVATIONS

MADE	CMS DATE 06/04/08	JOB NO.	ARD495	DIST. No.
CHECKED	BLJ DATE 06/19/08	DRAWING	LB8A	EST. No.