


NOTE:
 * RAIL LENGTHS DO NOT INCLUDE
 END CAPS AND/OR GAPS.
 * LENGTH OF APPROACH RAILING ON THIS SHEET IS
 43.75 LF PAY LENGTH.
 * LENGTHS SHOWN THUS () ARE ACTUAL LENGTHS ALONG
 FRT FACE OF RAILING

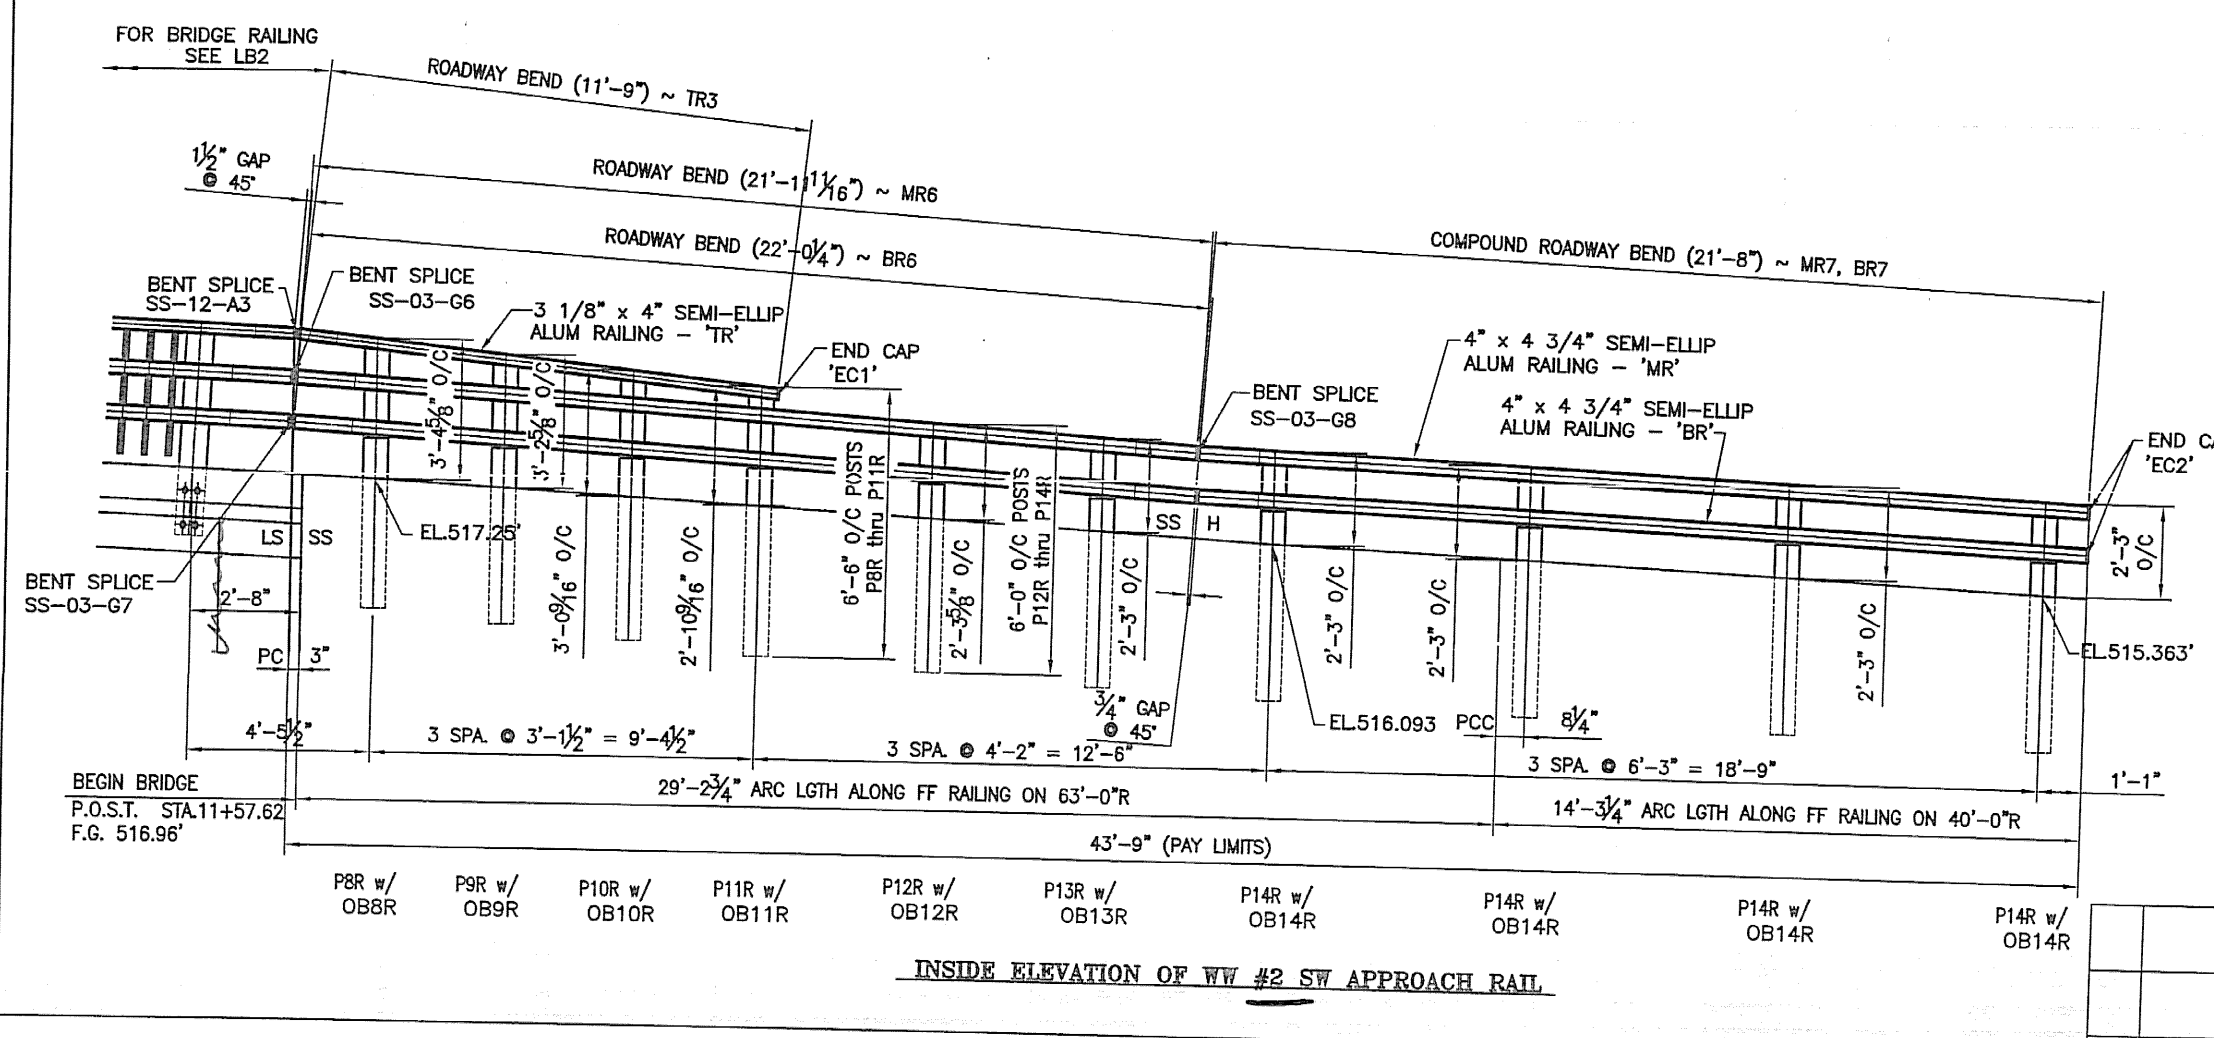

RECEIVED
 OK'D BY: *[Signature]*
 JUL 09 2008
 RESUBMIT: *[Signature]* APPROVED: *[Signature]*
 BY: _____ DATE: _____
ANODIZED
 (SEE LB1 or LB5 FOR NOTES)

PROJECT No. BRZ 1441(19) C/2	ITEM No: 900.640
APPROVED: _____	REC'D APPROVAL _____
L.B. FOSTER COMPANY 10145 ORIENTED ROAD PITTSBURGH, PENNSYLVANIA 15220	
FOR: A. D. ROSSI CORPORATION VERMONT AGENCY OF TRANSPORTATION TOWN OF FOWINAL COUNTY OF BENNINGTON BRIDGE RAILING FOR BRIDGE #41, TH 24, CL3 (LOCAL) 3L ALUMINUM APPROACH RAIL ELEVATIONS	
MADE: CMS, DATE 06/06/08, JOB No. AR0485	CST. No. _____
CHECK: B.L., DATE 06/19/08, DRAWING LE10	EST. No. _____

INSIDE ELEVATION OF WW #2 SW APPROACH RAIL