


NOTE:
 • RAIL LENGTHS DO NOT INCLUDE END CAPS AND/OR GAPS.
 • LENGTH OF APPROACH RAILING ON THIS SHEET IS 41.58 LF PAY LENGTH.
 • LENGTHS SHOWN THUS () ARE ACTUAL LENGTHS ALONG FRT FACE OF RAILING

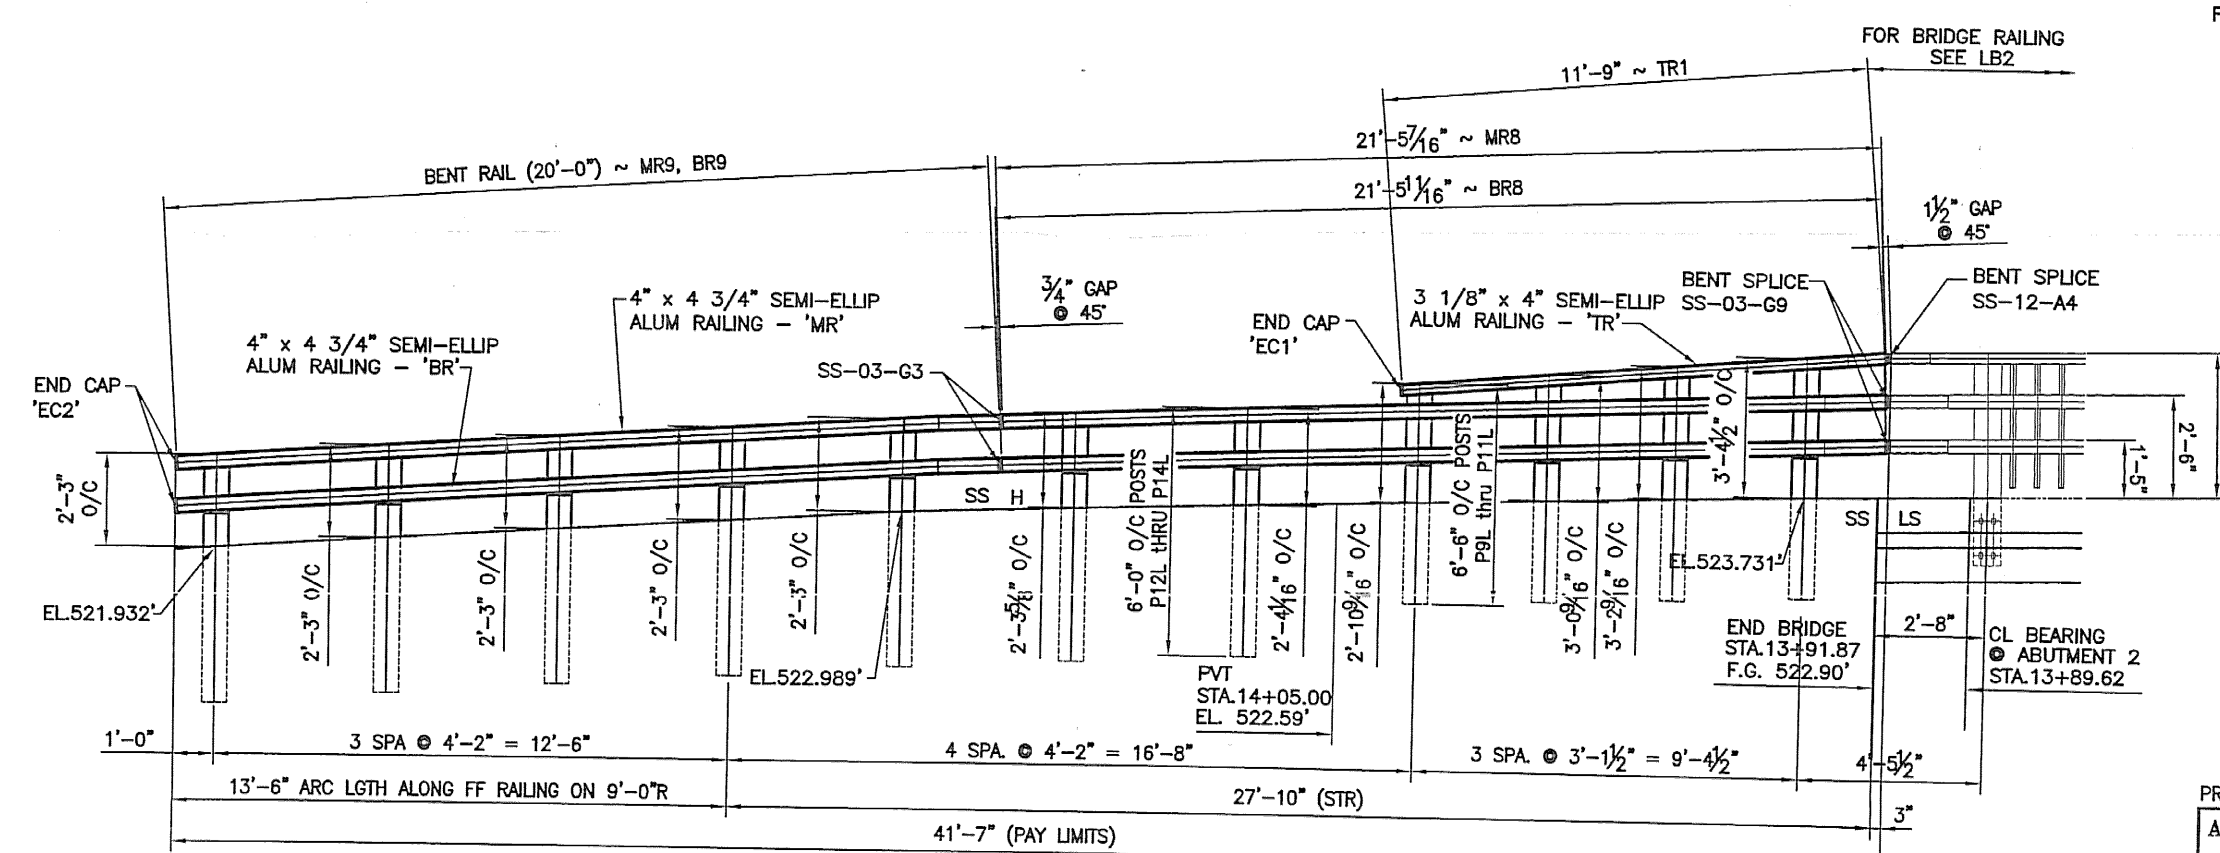

INSIDE ELEVATION OF RW #4 SR APPROACH RAIL

PROJECT No. BRZ 1441(19) C/2 ITEM No. 900.640

APPROVED: _____

L.B. FOSTER COMPANY
 1016 COUNTRYVIEW ROAD
 PITTSBURGH, PENNSYLVANIA 15220

FOR: A. D. ROSSI CORPORATION
 VERMONT AGENCY OF TRANSPORTATION
 TOWN OF FORMAL, COUNTY OF BENNINGTON
 BRIDGE RAILING FOR BRIDGE #41 TH 23 (LOCAL)
 3L ALUMINUM APPROACH RAIL ELEVATIONS

MADE CMS DATE 06/06/08 JOB No. AR0493 CUST. No. _____
 CHECK DATE 06/19/08 DRAWING 1B10A REV. No. _____

RECEIVED
 CK'D BY *[Signature]* ON 07/09/08
 JUL 09 2008
 RESUBMIT _____ APPROVED _____
 BY _____ DATE _____

ANODIZED
 (SEE LB1 or LBS FOR NOTES)

REV.	DESCRIPTION	BY	DATE