


PLAN

SCALE 1" = 10'-0"

NOTE:
SEE SHEET 37 FOR RAIL DETAILS

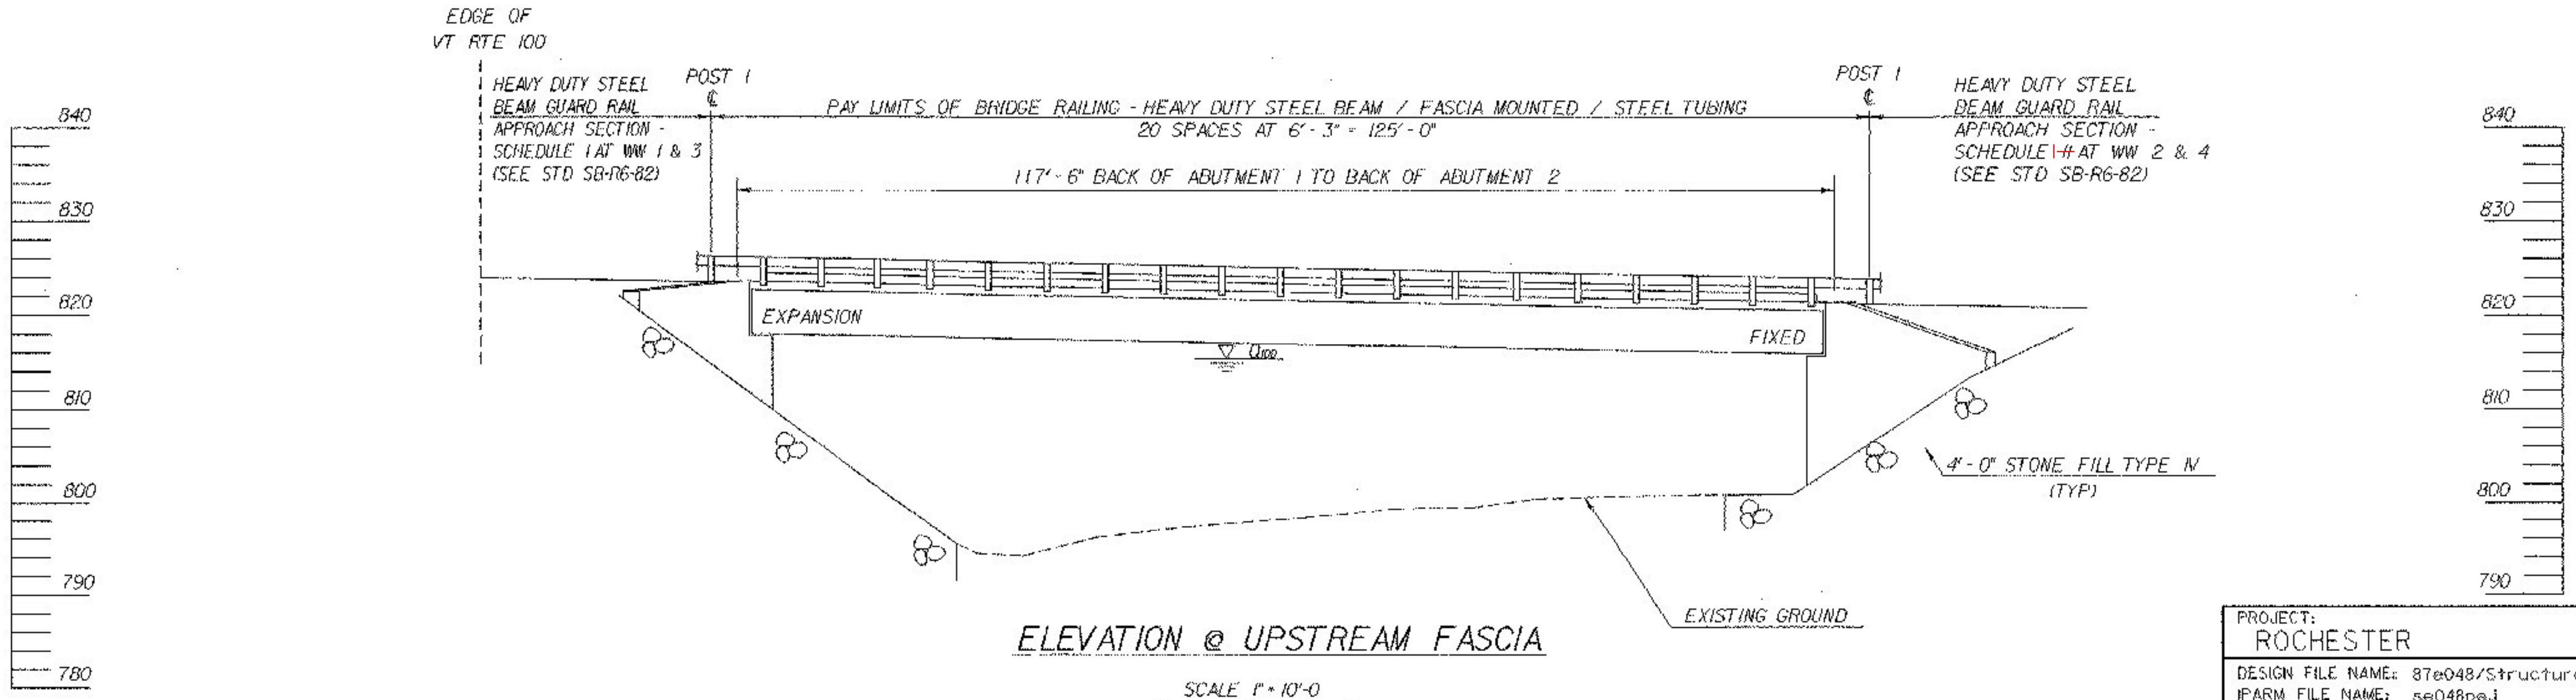

ELEVATION @ UPSTREAM FASCIA

SCALE 1" = 10'-0"

PROJECT: ROCHESTER	PROJECT NO.: BRZ 1444 (20)
DESIGN FILE NAME: 87e048/Structures/se048po.dgn	PLOT DATE: 25-JAN-2002
IFARM FILE NAME: se048po.i	SURVEY DATE: 3/91
SURVEYED BY: CILMAN	DRAWN BY: HIGGINS
SQUAD LEADER: C.P. WILLIAMS	SHEET: 17 OF 52
PLAN AND ELEVATION	