

GEOTEXTILE FABRIC FOR SILT FENCE
 LT.
 REV. 80+00 ~ REV. 83+00
 SF SILT FENCE

CONSTRUCT SPECIAL DITCH W/EROSION MATTING
 78+00 LT. ~ REV. 80+00 LT.

STATE OF VERMONT

STATE OF VERMONT

6B

REV. CURVE #2
 $\Delta = 18^\circ - 30' - 00.0''$ LT.
 $D = 8^\circ - 00' - 00''$
 $R = 716.198$
 $T = 116.64$
 $L = 231.25$
 $E = 9.44$
 BANK = 0.071 FT/FT

REV 83+00
 END SUBBASE SHIM COURSE
 BEGIN FULL DEPTH TYPICAL

REV. CURVE #1
 $\Delta = 31^\circ - 45' - 00''$ RT.
 $D = 11^\circ - 30' - 00''$
 $R = 498.224$
 $T = 441.69$
 $L = 276.09$
 $E = 19.76$
 BANK = 0.080 FT/FT

DRIVE CURVE DATA
 $\Delta = 24^\circ 15' - 06''$ LT.
 $D = 40^\circ 00' - 00''$
 $R = 143.24'$
 $T = 30.78'$
 $L = 60.63'$
 $E = 3.27'$
 $2T-L = 0.92'$

DRIVE CURVE DATA
 $\Delta = 19^\circ - 08' - 02''$ LT.
 $D = 12^\circ - 00' - 00''$
 $R = 477.4650'$
 $T = 80.47'$
 $L = 159.45'$
 $E = 6.73'$
 $2T-L = 1.50'$


PC = 1+00.27
 PI = 1+80.74 BK = 1+79.25 AH
 PT = 2+59.72

G200002 1805 87E055 JM
 SURVEYED BY REED DATE: 9-87
 DRAWN BY WILLEY DATE: 10-87
 SQUAD LEADER PERKINS
 DESIGN FILE NO. /prop/87e055/ra055zzz.dgn
 IPARM FILE 87e0552r.1 DATE PLOTTED 22-FEB-1996

BERLIN
 MEGC M 6200(2) S

R. O. W. SHEET 12 OF 17
 SHEET 17 OF 73

DATUM
 VERTICAL _____
 HORIZONTAL _____

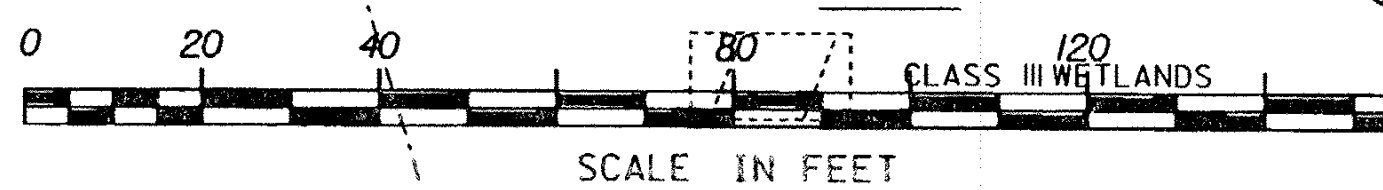

RELOCATE MAILBOX, SINGLE SUPPORT
 RT.
 REV 85+08

CONSTRUCT MAILBOX TURNOUT
 RT.
 REV 85+07

DION, NORMAN M. & PENNY R.

REMOVAL OF EXISTING FENCE
 RT.
 REV 85+22 ~ REV 86+00 (78 LF)

CONSTRUCT DRIVE
 RT.
 REV 84+83
 CRUSHED SLATE, 16 FT.
 REV 85+78 = 1+00 DRIVE C/L
 CRUSHED SLATE, 16 FT. $\Delta = 85^\circ - 13' - 19''$ RT.

02-15-96 REVISION #31	
11-03-95 REVISION #29	
06-13-94 REVISION #28	
09-14-93 REVISION #27	
08-23-93 REVISION #26	
06-28-93 REVISION #24	
05-24-93 REVISION #22	
05-13-93 REVISION #21	
04-30-93 REVISION #17	
10-16-92 REVISION #14	

