

DATUM
 VERTICAL NGVD 1929
 HORIZONTAL NAD 1927


TH #4 14+00 L.T. - TH #4 14+75 L.T.
 PAVED SHOULDER TAPER (4' TO 6')

TH #4 14+50 L.T. - TH #4 15+00 L.T.
 SPECIAL DITCH W/ EROSION MATTING

Excav. of SWAP & pavement =
 14+80 --- 15+00 LT

BM 1203-87-09
 REBAR
 EL. 1180.03

BM 1203-87-10
 CHIS. □ IN LEDGE
 EL. 1185.00

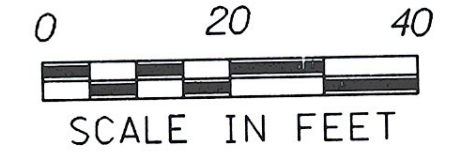

SURVEYED BY	<u>C. REED</u>	DATE	<u>9-87</u>
DRAWN BY	<u>D. WILLEY</u>	DATE	<u>10-87</u>
SQUAD LEADER	<u>T. BOHL</u>		
DESIGN FILE NO.	<u>/sqdd/87e055/de055bor.dgn</u>		
IPARM FILE	<u>DE055L6R</u>	DATE PLOTTED	<u>17-JUL-1997</u>
PROJ. NAME	<u>BERLIN</u>		
PROJ. NO.	<u>MEGC-M6200(2)S</u>		
SHEET	<u>28</u>	OF	<u>73</u> SHEETS