


TEMPORARY EROSION CONTROL PLAN

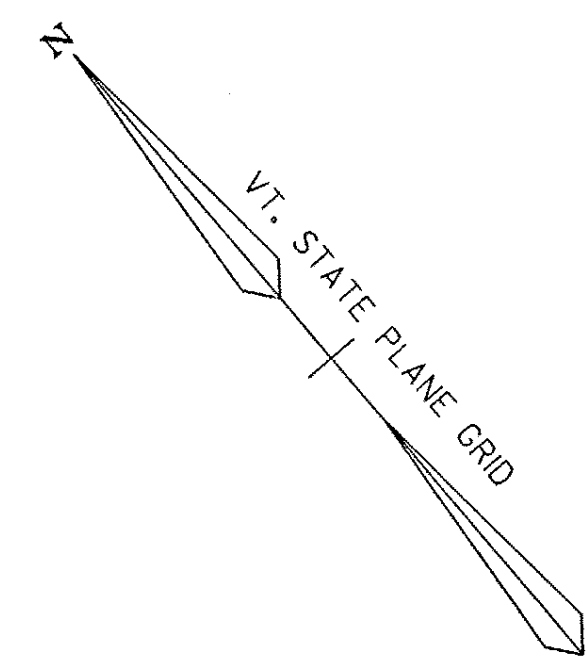

BM 1203-87-03
REBAR
EL. 1175.65

BM 1203-87-04
TABLET IN LEDGE
EL. 1191.94

GEOTEXTILE FABRIC FOR SILT FENCE
LT.
REV. 80+00 ~ REV. 83+00
SF SILT FENCE

CURVE DATA #2
 $\Delta = 19^{\circ}08'39''$ LT.
D = 6'
R = 954.930'
T = 161.04'
L = 319.07'
E = 13.48'

REV. CURVE #2
 $\Delta = 18^{\circ}30'00.0''$ LT.
D = 8'-00'-00''
R = 716.198
T = 116.64
L = 231.25
E = 9.44
BANK = 0.071 FT/FT


REV. CURVE #1
 $\Delta = 31^{\circ}45'00''$ RT.
D = 11'-30'-00''
R = 498.224
T = 141.69
L = 276.09
E = 19.76
BANK = 0.080 FT/FT

CURVE DATA #1
 $\Delta = 33^{\circ}20'16''$ RT.
D = 10'
R = 572.958'
T = 171.56'
L = 333.38'
E = 25.13'

DRIVE CURVE DATA
 $\Delta = 24^{\circ}15'06''$ LT.
D = 40'-00'-00''
R = 143.24'
T = 30.78'
L = 60.63'
E = 3.27'
2T-L = 0.92'

DRIVE CURVE DATA
 $\Delta = 19^{\circ}08'02''$ LT.
D = 12'-00'-00''
R = 477.4650'
T = 80.47'
L = 159.45'
E = 6.73'
2T-L = 1.50'

PC = 1+66.96
PI = 1+97.74 BK = 1+96.82 AH
PT = 2+27.60

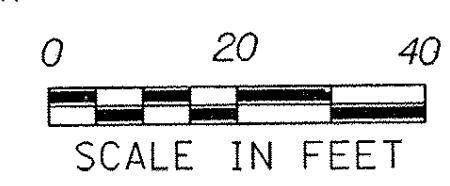

LEGEND

DATUM
VERTICAL NGVD 1929
HORIZONTAL NAD 1927

SURVEYED BY C. REED DATE 9-87
DRAWN BY D. WILLEY DATE 10-87
SQUAD LEADER T. BOHL
DESIGN FILE NO. /sddd/87e055/de055bor.dgn
IPARM FILE DE055L2E DATE PLOTTED 17-JUL-1997
PROJ. NAME BERLIN
PROJ. NO. MEGC-M6200(2)S
SHEET 39 OF 73 SHEETS

