
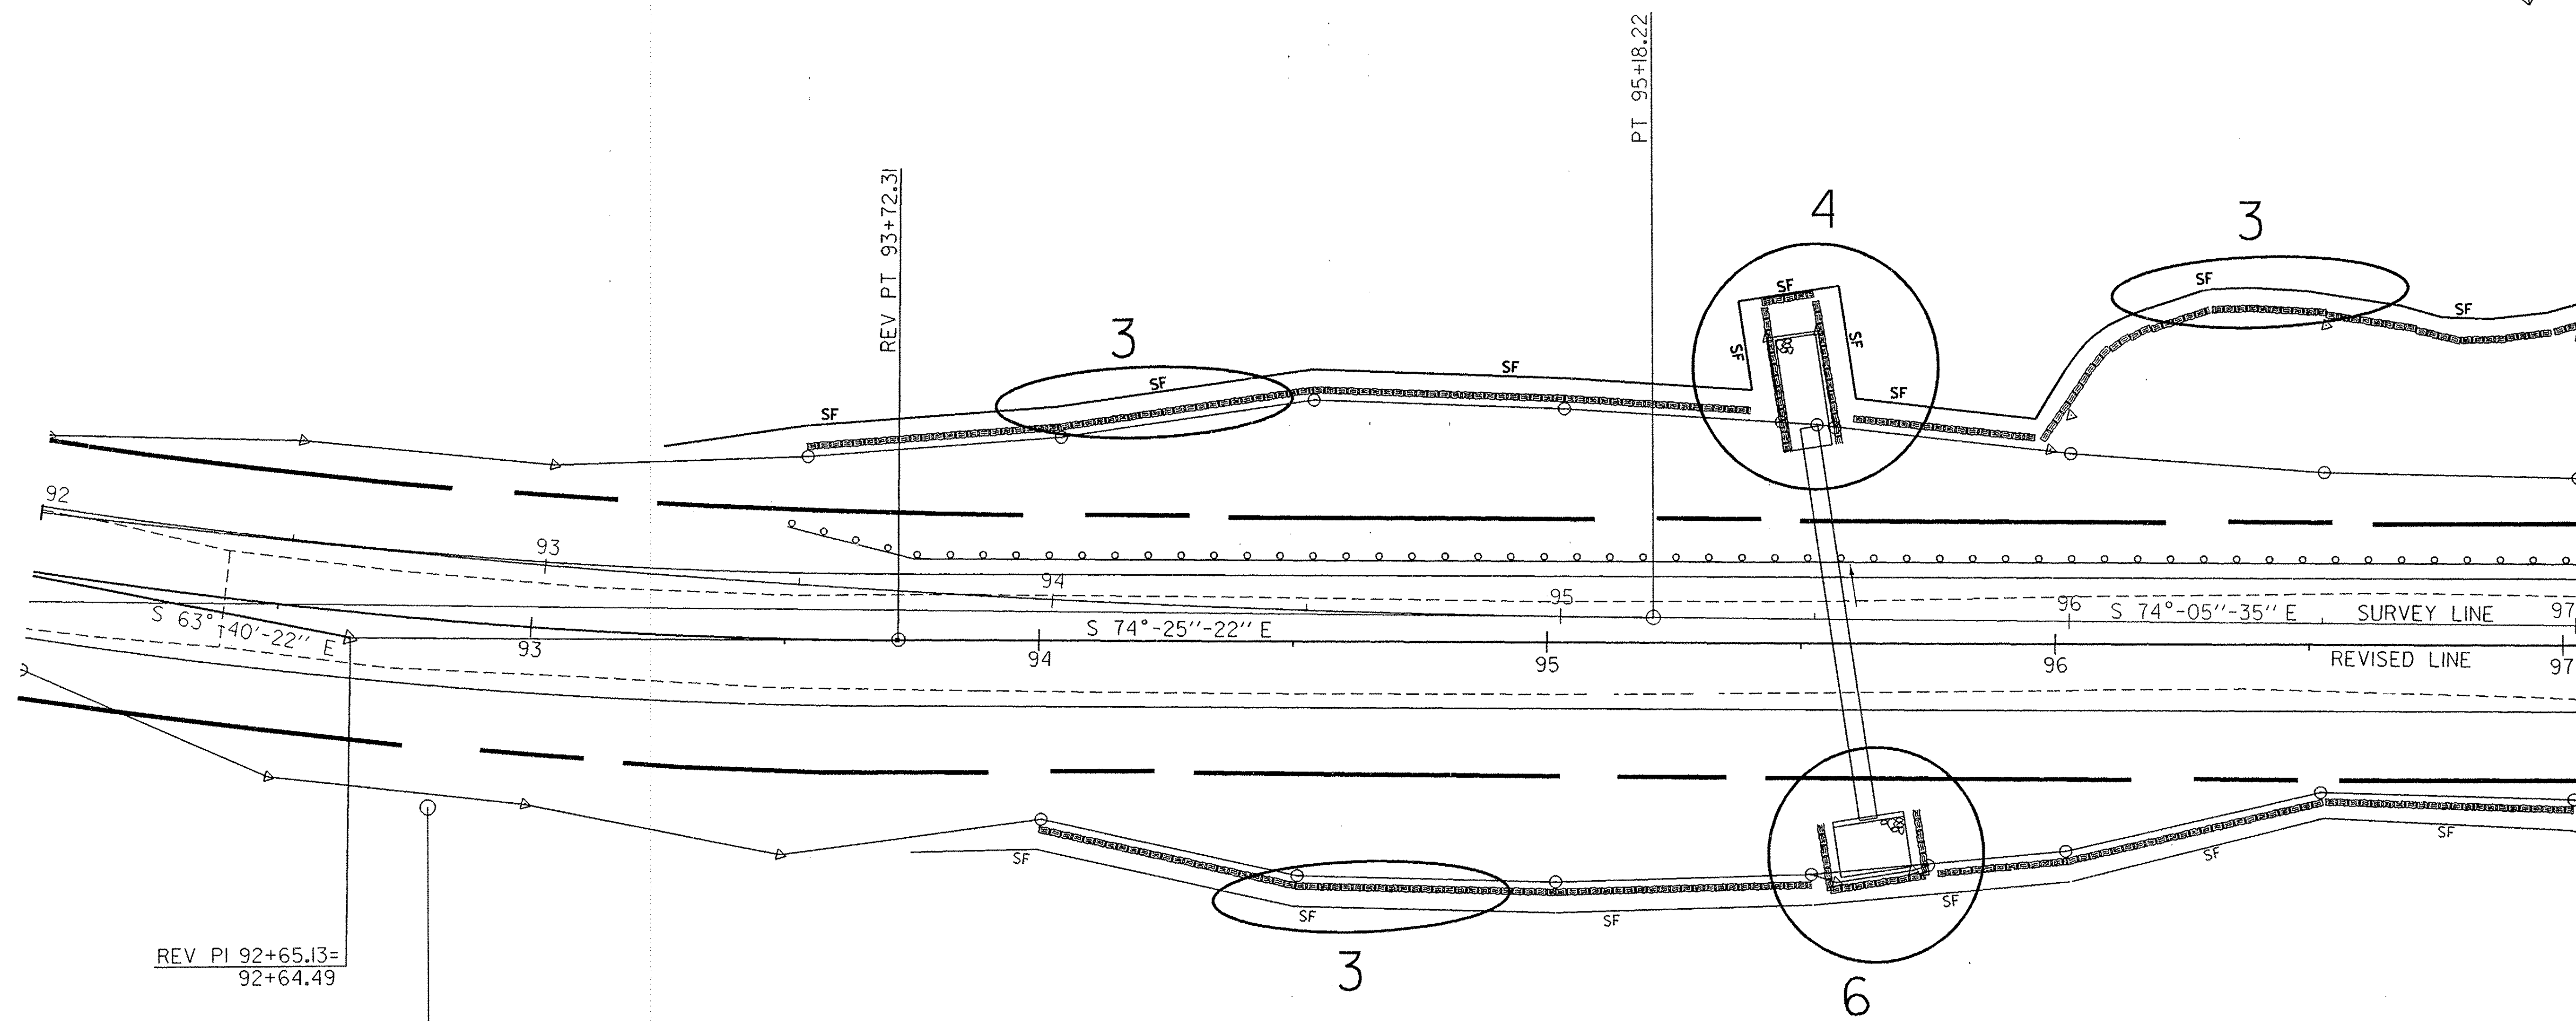


TEMPORARY EROSION CONTROL PLAN

REV. CURVE #4
 $\Delta = 10^{\circ}-45'-00.0''$ LT.
 $D = 5^{\circ}-00'-00''$
 $R = 1145.916$
 $T = 107.82$
 $L = 215.00$
 $E = 5.06$
 $BANK = 0.055$ FT/FT

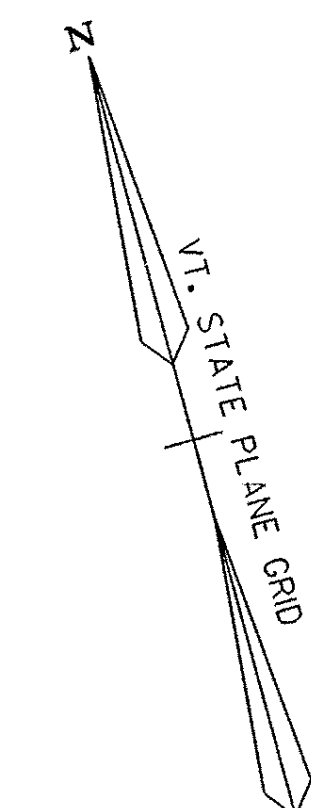


REV PI 92+65.13 =
92+64.49

BM 1203-87-05
BOLT IN LEDGE
EL. 1169.18

GEOTEXTILE FOR SILT FENCE
 REV. 93+24 LT. - REV. 97+00 LT.
 REV. 93+76 RT. - REV. 97+00 RT.
 SF SILT FENCE

LEGEND

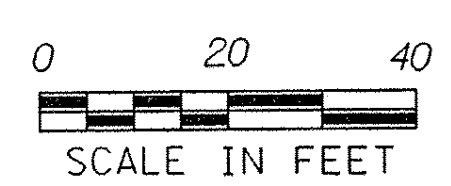

DATUM
 VERTICAL NGVD 1929
 HORIZONTAL NAD 1927

SURVEYED BY	C. REED	DATE	9-87
DRAWN BY	D. WILLEY	DATE	10-87
SQUAD LEADER	T. BOHL		
DESIGN FILE NO.	/sqdd/87e055/de055bor.dgn		
IPARM FILE	DE055L4E	DATE PLOTTED	17-JUL-1997
PROJ. NAME	BERLIN		
PROJ. NO.	MEGC-M6200(2)S		
SHEET	41	OF	73 SHEETS