
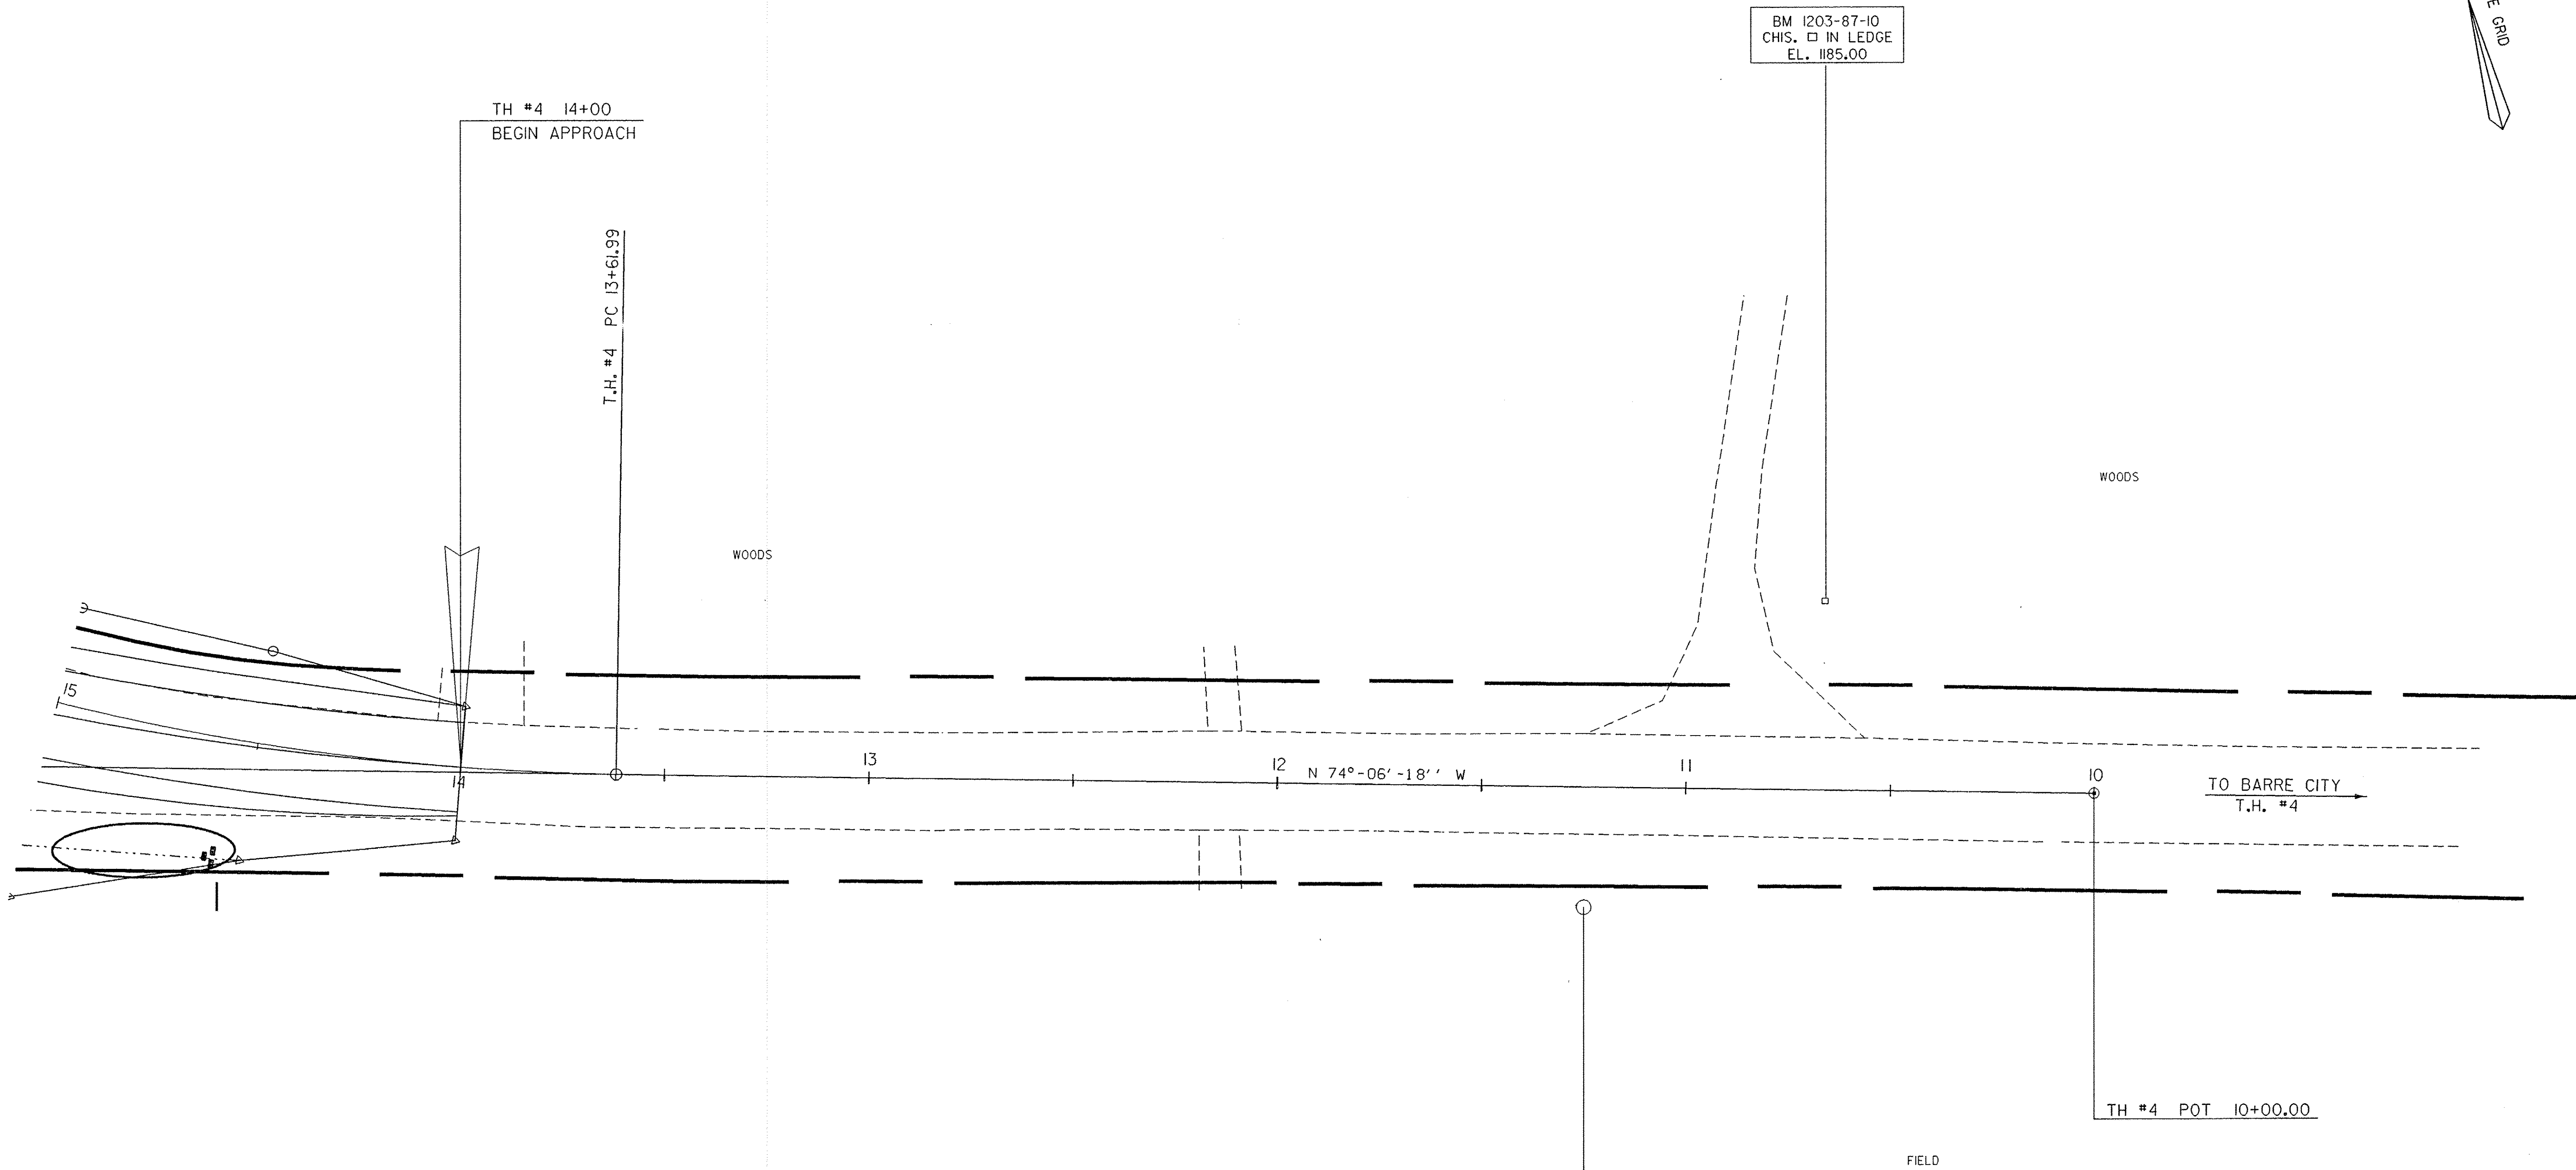


TEMPORARY EROSION CONTROL PLAN

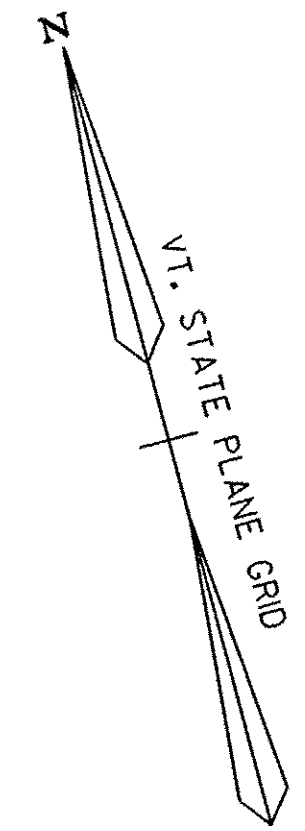

DATUM
 VERTICAL NGVD 1929
 HORIZONTAL NAD 1927

BM 1203-87-09
 REBAR
 EL. 1180.03

0 20 40
 SCALE IN FEET

SURVEYED BY	<u>C. REED</u>	DATE	<u>9-87</u>
DRAWN BY	<u>D. WILLEY</u>	DATE	<u>10-87</u>
SQUAD LEADER	<u>T. BOHL</u>		
DESIGN FILE NO.	<u>/sadd/87e055/de055bor.dgn</u>		
IPARM FILE	<u>DE055L6E</u>	DATE PLOTTED	<u>17-JUL-1997</u>
PROJ. NAME	<u>BERLIN</u>		
PROJ. NO.	<u>MEGC-M6200(2)S</u>		
SHEET	<u>43</u>	OF	<u>73</u> SHEETS