




1180

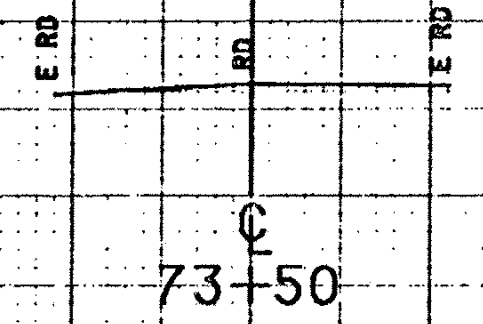


1180

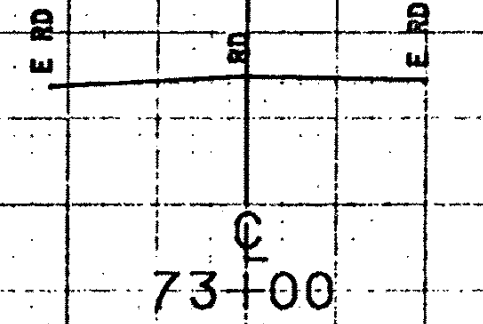

1180

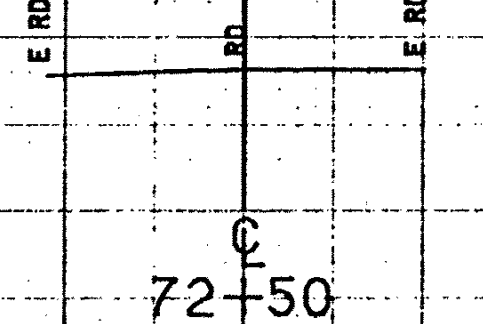

1180

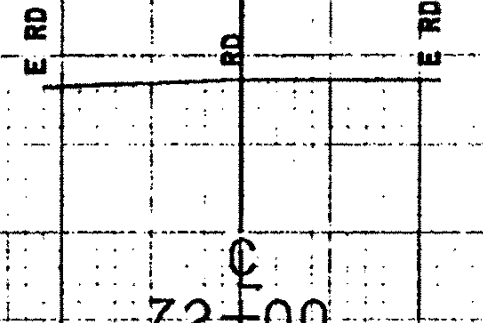

1180

Scott Hill Rd. TH #5
FROM STA. 72+00 TO STA. 74+00
PROJECT NAME BERLIN MAIN
NO. MEGG M6200(2)S PLOTTED 06/06/90
SURVEYED BY REED 09/87 0076
SHEET 51 OF 73 SHEETS

SCALE 1" = 10 FEET