
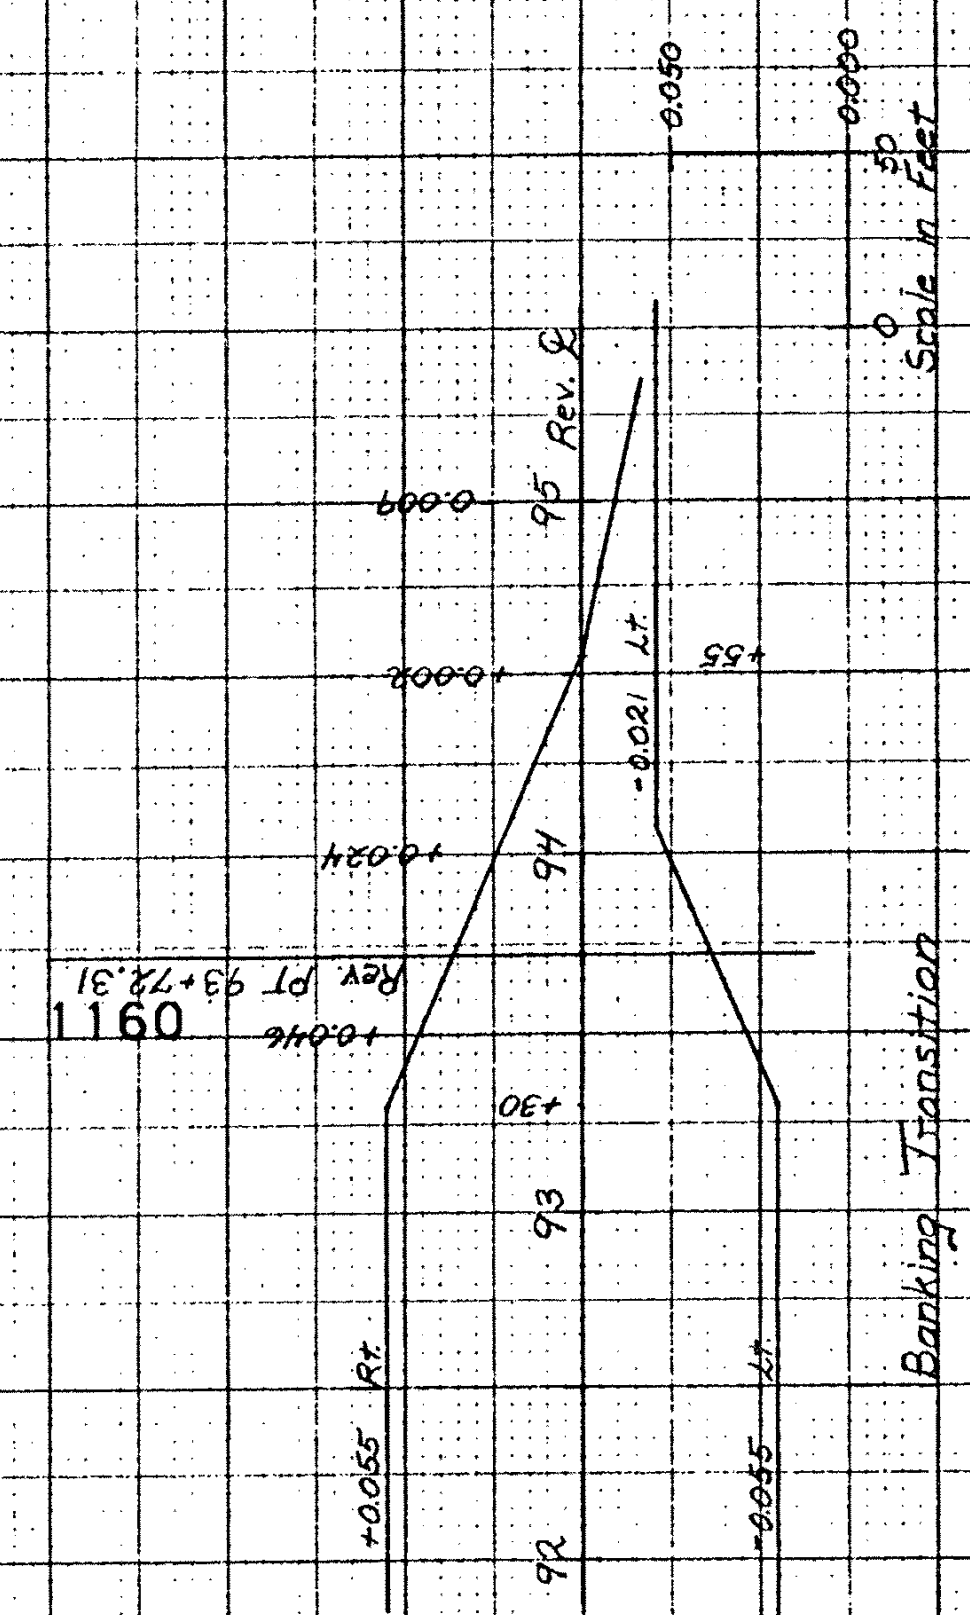


Rev. 93+25.8
Begin Scarifying Pavement

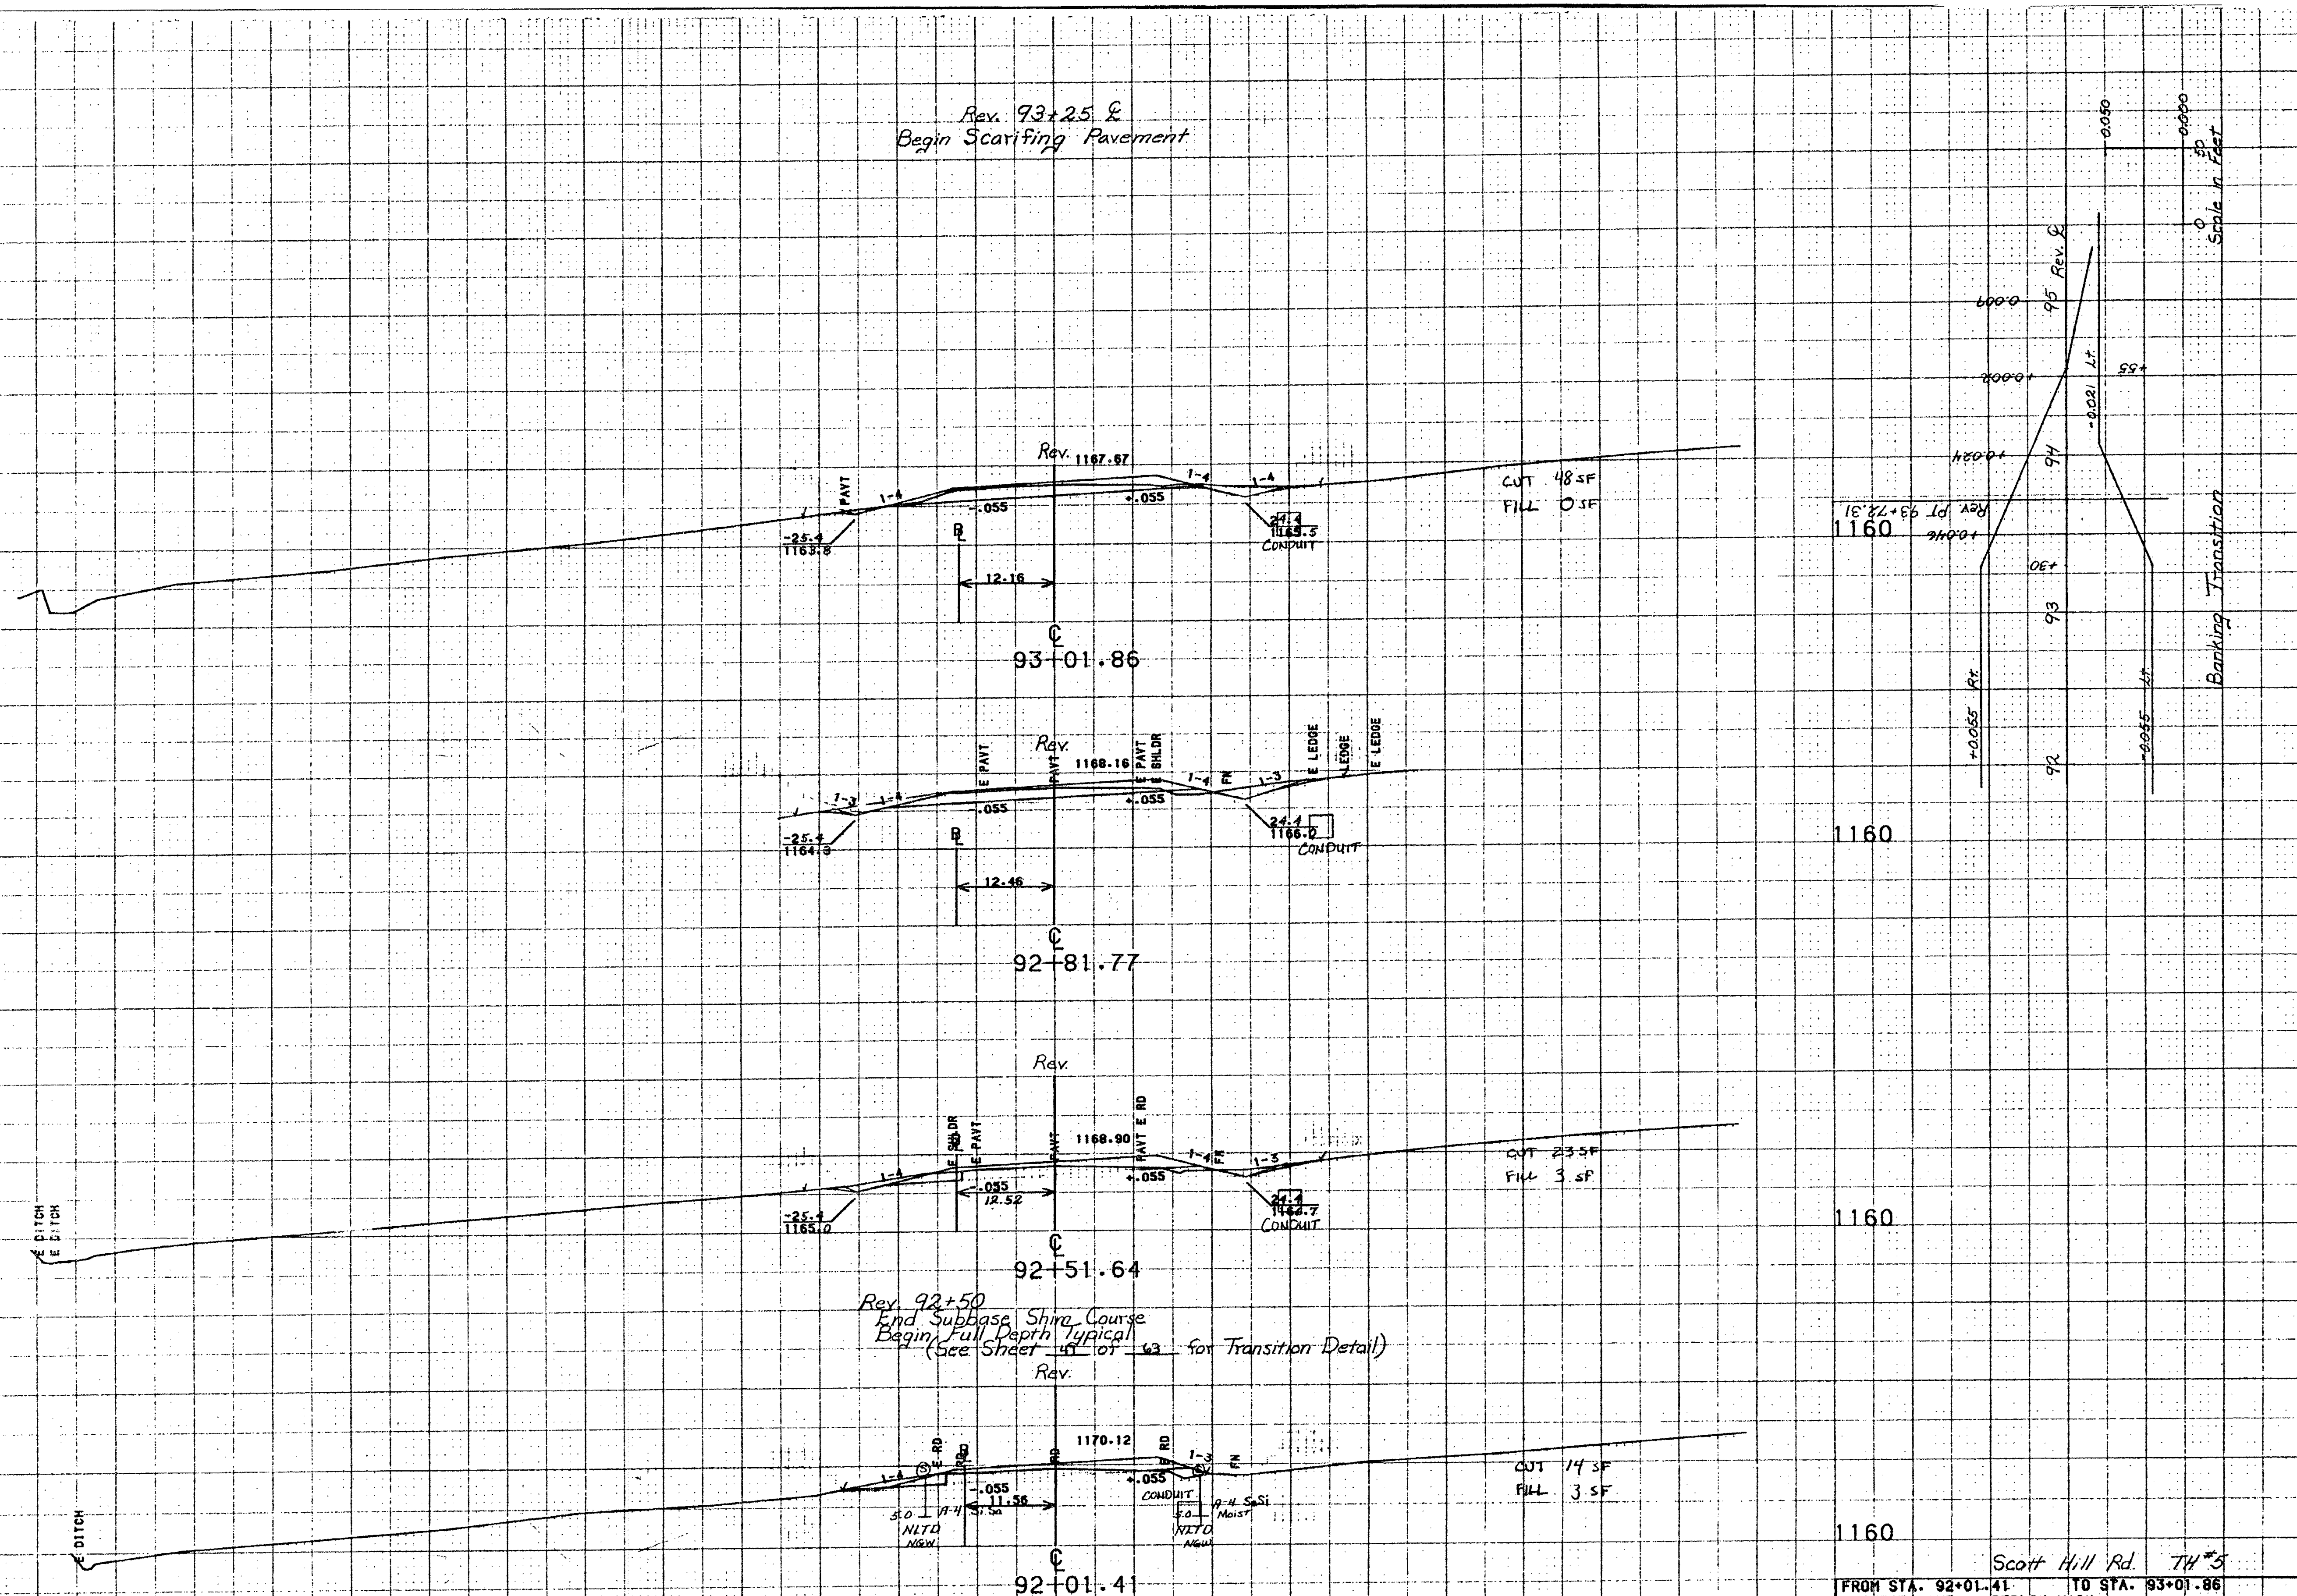

Rev. 92+50
End Subbase, Shiro Course
Begin Full Depth Typical
(See Sheet 67 for Transition Detail)

FROM STA. 92+01.41	TO STA. 93+01.86
PROJECT NAME	BERLIN MAIN
NO. M666	M6200(2)S
SURVEYED BY	REED
SHEET 67	OF 73 SHEETS
PLOTTED 06/05/90	
09/87 0076	

SCALE 1" = 50 FEET

Scale in Feet

Banking Transition

Scott Hill Rd. TH#5