


100+05.10
END PROJECT
MEGC - M6200 (2) S

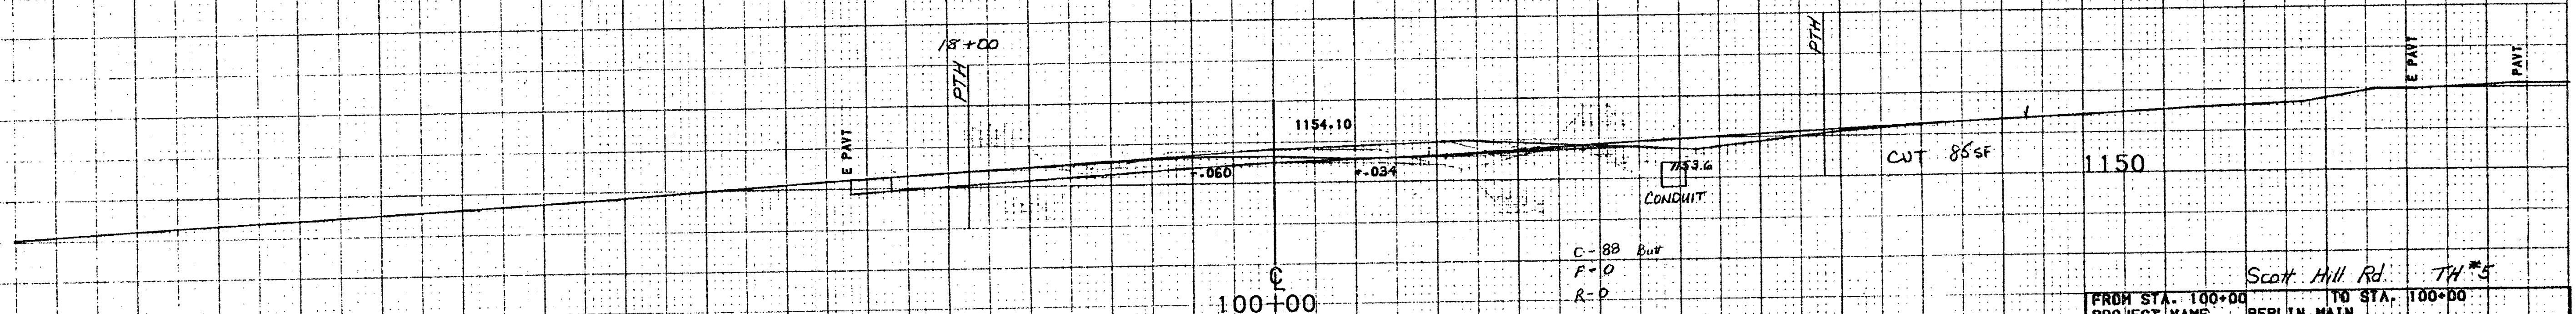

Rev. POT 99+82.30 =
Surv. PT 99+78.40
Eq. = +3.90

FROM STA. 100+00	TO STA. 100+00
PROJECT NAME BERLIN HALL	NO. M6200 (2) S
SURVEYED BY REED	PLOTTED 06/05/90
SHEET 65 OF 93 SHEETS	09/87 0076

Scott Hill Rd. TH #5